

C 1 8580. SEQUENCE NO. (WRA USE ONLY)

STATE OF MARYLAND WATER RESOURCES ADMINISTRATION TAWES STATE OFFICE BLDG., ANNAPOLIS, MD. 21401 WELL COMPLETION REPORT

THIS REPORT MUST BE SUBMITTED WITHIN 30 DAYS AFTER WELL COMPLETION

FILL IN THIS FORM COMPLETELY

COUNTY NUMBER

DATE RECEIVED (WRA USE ONLY) DATE WELL COMPLETED

DEPTH OF WELL 240 (TO NEAREST FOOT)

PERMIT NO. FROM "PERMIT TO DRILL WELL"

DRILLER'S IDENTIFICATION NO. 41

OWNER: Crestone Property, LAST NAME: STREET OR RD: POST OFFICE:

WELL LOG: STATE THE KIND OF FORMATIONS PENETRATED, THEIR COLOR, DEPTH, THICKNESS AND IF WATER BEARING

Table with columns: DESCRIPTION, FEET (FROM TO), CHECK IF WATER BEARING. Includes handwritten entries for soil and sandstone layers.

GROUTING RECORD: WELL HAS BEEN GROUTED (Y), TYPE OF GROUTING MATERIAL (CM), NO. OF BAGS (800), GALLONS OF WATER (41)

DEPTH OF GROUT SEAL (TO NEAREST FOOT): FROM 0 FT. TO 20 FT.

CASING RECORD: MAIN CASING TYPE (C), NOMINAL DIAMETER (6), TOTAL DEPTH OF MAIN CASING (98)

OTHER CASING: EACH CASING TYPE, DIAMETER (INCH), DEPTH (FEET) FROM TO

SCREEN RECORD: SCREEN TYPE OR OPEN HOLE (S), DIAMETER (INCH), DEPTH (FEET) FROM TO

DEPTH OF SCREEN (TO NEAREST WHOLE FOOT): FROM 20 TO 240

GRAVEL PACK: IF WELL DRILLED WAS A FLOWING WELL (CIRCLE BOX)

WRA USE ONLY (NOT TO BE FILLED IN BY DRILLER): TELESCOPE CASING, LOG INDICATOR


PUMPING TEST: HOURS PUMPED (TO NEAREST HOUR) 2, PUMPING RATE (GALLONS PER MINUTE TO NEAREST GALLON) 2

WATER LEVEL: DISTANCE FROM LAND SURFACE BEFORE PUMPING (70), WHEN PUMPING (570)

TYPE OF PUMP USED (CIRCLE APPROPRIATE BOX): CENTRIFUGAL (C), PISTON (P), TURBINE (T), etc.

PUMP INSTALLED: TYPE OF PUMP (WRITE APPROPRIATE LETTER IN BOX), CAPACITY (GALLONS PER MINUTE TO NEAREST GALLON)

CASING HEIGHT (CIRCLE APPROPRIATE BOX AND ENTER CASING HEIGHT): ABOVE (49), BELOW (51)

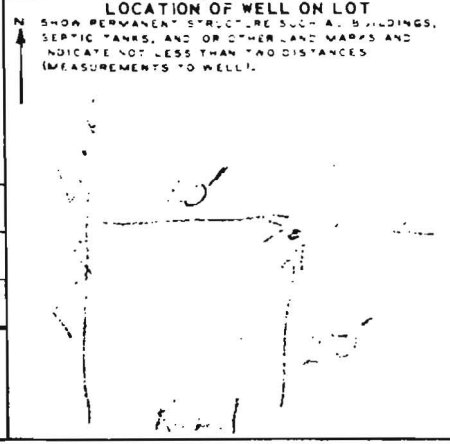

CIRCLE APPROPRIATE BOXES: A WELL WAS ABANDONED AND SEALED WHEN THIS WELL WAS COMPLETED, ELECTRIC LOG OBTAINED, TEST WELL CONVERTED TO PRODUCTION WELL

I HEREBY CERTIFY THAT I HAVE COMPLIED WITH ALL REGULATIONS STATED ON THE ABOVE-CAPTIONED "PERMIT TO DRILL WELL"

DRILLER'S NAME, SIGNATURE, DATE

C 1 352

SEQUENCE NO. (WRA USE ONLY)

STATE OF MARYLAND WATER RESOURCES ADMINISTRATION TAWES STATE OFFICE BLDG., ANNAPOLIS, MD. 21401 WELL COMPLETION REPORT

THIS REPORT MUST BE SUBMITTED WITHIN 30 DAYS AFTER WELL COMPLETION

FILL IN THIS FORM COMPLETELY

COUNTY NUMBER

1 2 (SEQ. NO.) (THIS NUMBER IS TO BE PUNCHED IN COLS. 3-8 ON ALL CARDS)

DATE RECEIVED (WRA USE ONLY)

DEPTH OF WELL

PERMIT NO. FROM "PERMIT TO DRILL WELL"

DATE WELL COMPLETED

22 (TO NEAREST FOOT) 26

28 29 30 31 32 33 34 35 36 37

8-13

18 20

DRILLERS IDENTIFICATION NO.

OWNER LAST NAME

FIRST NAME

STREET OR RFO

POST OFFICE

WELL LOG: STATE THE KIND OF FORMATIONS PENETRATED, THEIR COLOR, DEPTH, THICKNESS AND IF WATER BEARING. DESCRIPTION (USE ADDITIONAL SHEETS IF NECESSARY) FEET (FROM TO) CHECK IF WATER BEARING

Top Soil 0 2
SAND 2 8
SANDSTONE 8 50 ✓
15' SLATE 50 500

GROUTING RECORD: WELL HAS BEEN GROUTED (CIRCLE APPROPRIATE BOX) YES [Y] NO [N] TYPE OF GROUTING MATERIAL (CIRCLE BOX) CEMENT [CM] BENTONITE CLAY [BC] NO. OF BAGS NO. OF POUNDS GALLONS OF WATER DEPTH OF GROUT SEAL (TO NEAREST FOOT) FROM 48 FT. TO 54 FT.

CASING RECORD: MAIN CASING TYPE, NOMINAL DIAMETER TOP MAIN CASING (NEAREST INCH), TOTAL DEPTH OF MAIN CASING (NEAREST FOOT). OTHER CASING IF USED DIAMETER (INCH), DEPTH (FEET) FROM TO.

SCREEN RECORD: SCREEN TYPE OR OPEN HOLE (CIRCLE APPROPRIATE CODE BELOW) SIT [STEEL], BBR [BRASS OR BRONZE], HCO [OPEN HOLE], PLS [PLASTIC], OT [OTHER].

DEPTH NEAREST WHOLE FOOT: 1 8 9 15 17 21; 2 23 24 26 30 32 36; 3 38 39 41 45 47 51. SLO-T-SIZE 1, 2, 3. DIAMETER OF SCREEN (NEAREST INCH) FROM TO. GRAVEL PACK. IF WELL DRILLED AS A FLOWING WELL CIRCLE BOX 68.

PUMPING TEST: HOURS PUMPED (TO NEAREST HOUR) 1 9. PUMPING RATE (GALLONS PER MINUTE TO NEAREST GALLON) 11 15. METHOD USED TO MEASURE PUMPING RATE. WATER LEVEL: DISTANCE FROM LAND SURFACE BEFORE PUMPING (NEAREST FOOT) 17 20. WHEN PUMPING (NEAREST FOOT) 22 25. TYPE OF PUMP USED (CIRCLE APPROPRIATE BOX FOR PUMPING TEST): A AIR, B PISTON, T TURBINE, C CENTRIFUGAL, R ROTARY, O OTHER (DESCRIBE BELOW), J JET, S SUBMERSIBLE.

PUMP INSTALLED: TYPE OF PUMP (WRITE APPROPRIATE LETTER IN BOX - SEE ABOVE: A, C, J, P, R, S, T, O). IS USER WILL INSTALL PUMP (CIRCLE APPROPRIATE BOX) YES [Y] NO [N]. CAPACITY: GALLONS PER MINUTE (TO NEAREST GALLON) 31 35. PUMP HORSE POWER 37 41. PUMP COLUMN LENGTH (NEAREST FOOT) 42 47.


CASING HEIGHT: (CIRCLE APPROPRIATE BOX AND ENTER CASING HEIGHT) ABOVE [] BELOW [] LAND SURFACE (NEAREST FOOT) 49 50 51.

LOCATION OF WELL ON LOT: SHOW PERMANENT STRUCTURE SUCH AS BUILDINGS, SEPTIC TANKS, AND/OR OTHER LAND MARKS AND INDICATE NOT LESS THAN TWO DISTANCES (MEASUREMENTS TO WELL).

Handwritten notes: HOUSE, 135, 21

CIRCLE APPROPRIATE BOXES: A WELL WAS ABANDONED AND SEALED WHEN THIS WELL WAS COMPLETED; E ELECTRIC LOG OBTAINED; P BEST WELL CONVERTED TO PRODUCTION WELL. I HEREBY CERTIFY THAT I HAVE COMPLETED WITH ALL CONDITIONS STATED ON THE ABOVE-CAPTIONED "PERMIT TO DRILL WELL", AND THAT INFORMATION CONTAINED IN THIS REPORT IS TRUE, ACCURATE, AND COMPLETE TO THE BEST OF MY KNOWLEDGE, INFORMATION AND BELIEF. DRILLERS NAME: TELESCOPE CASING; LOG INDICATOR; WRA USE ONLY (NOT TO BE FILLED IN BY DRILLER); TELESCOPE CASING 70; LOG INDICATOR 72; OTHER DATA AVAILABLE 74 75 76.

ARGO DRIVE

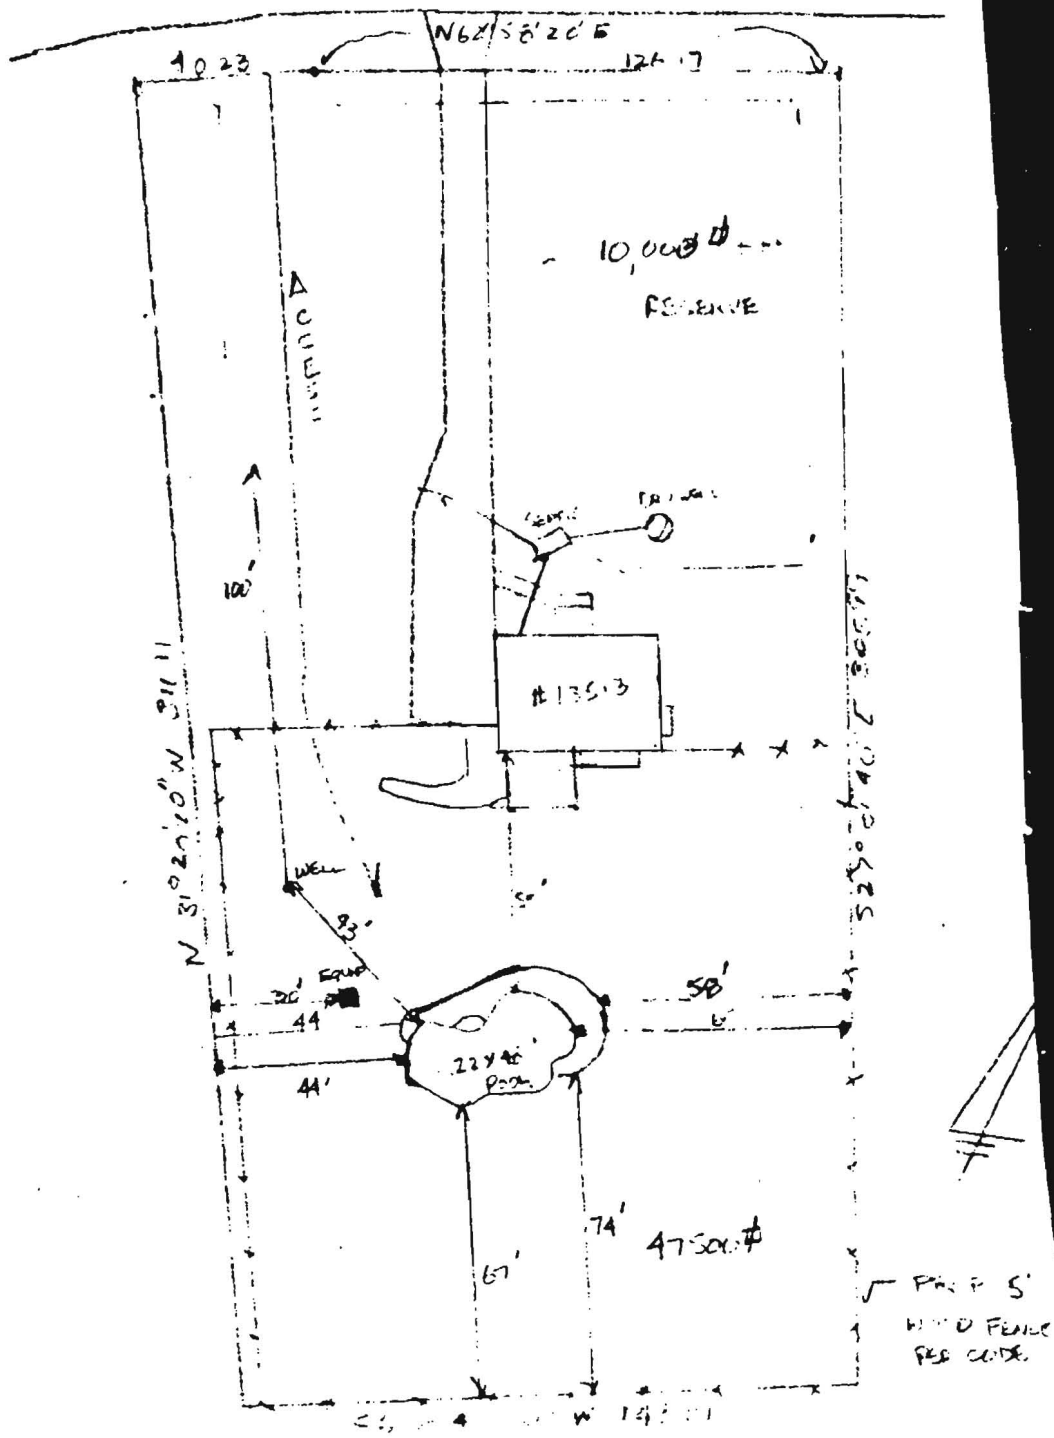

104