

# APPLICATION

N. 19558

SEWAGE DISPOSAL TESTING

P. \_\_\_\_\_

STATE OF MARYLAND - DEPARTMENT OF HEALTH AND MENTAL HYGIENE

HOWARD COUNTY HEALTH DEPARTMENT  
ENVIRONMENTAL HEALTH SERVICES  
P. O. BOX 476, ELLICOTT CITY, MARYLAND 21043  
TELEPHONE 465-5000, EXT 356

DISTRICT 5th

DATE 2/11/74

TO THE COUNTY HEALTH OFFICER  
ELLICOTT CITY, MARYLAND

I, HEREBY, APPLY FOR THE NECESSARY TEST IN ORDER TO CONSTRUCT (OR RECONSTRUCT) A SEWAGE DISPOSAL SYSTEM.

PROPERTY OWNER Frank P. Willson and Wife, Et. Al.

Any questions call Mr. Johnson:

ADDRESS c/o Ashton Realty Co., Ashton, Md. 20702

PHONE 914 924-4811

PROPERTY LOCATION

SUBDIVISION Linden Chapel Hills

LOT NO. 26, Blk. D, Sec. 4

ROAD AND DESCRIPTION Argo Drive

SIZE OF LOT 44, 536 sq. ft. ±

TYPE BLDG. 3 or 4 bedroom

NUMBER OF BEDROOMS

IF NOT SINGLE RESIDENCE DESCRIBE \_\_\_\_\_

THE SYSTEM INSTALLED UNDER THIS APPLICATION IS ACCEPTABLE ONLY UNTIL PUBLIC FACILITIES BECOME AVAILABLE.

SIGNATURE OF APPLICANT /s/ Robert Johnson

APPROVED BY \_\_\_\_\_ FOR \_\_\_\_\_ DATE \_\_\_\_\_

(KIND OF SYSTEM)


REJECTED BY \_\_\_\_\_ FOR \_\_\_\_\_ DATE \_\_\_\_\_

(KIND OF SYSTEM)

HOLD PENDING FURTHER TESTS \_\_\_\_\_ DATE \_\_\_\_\_

REASONS FOR REJECTION OR HOLDING \_\_\_\_\_

## THIS IS NOT A PERMIT

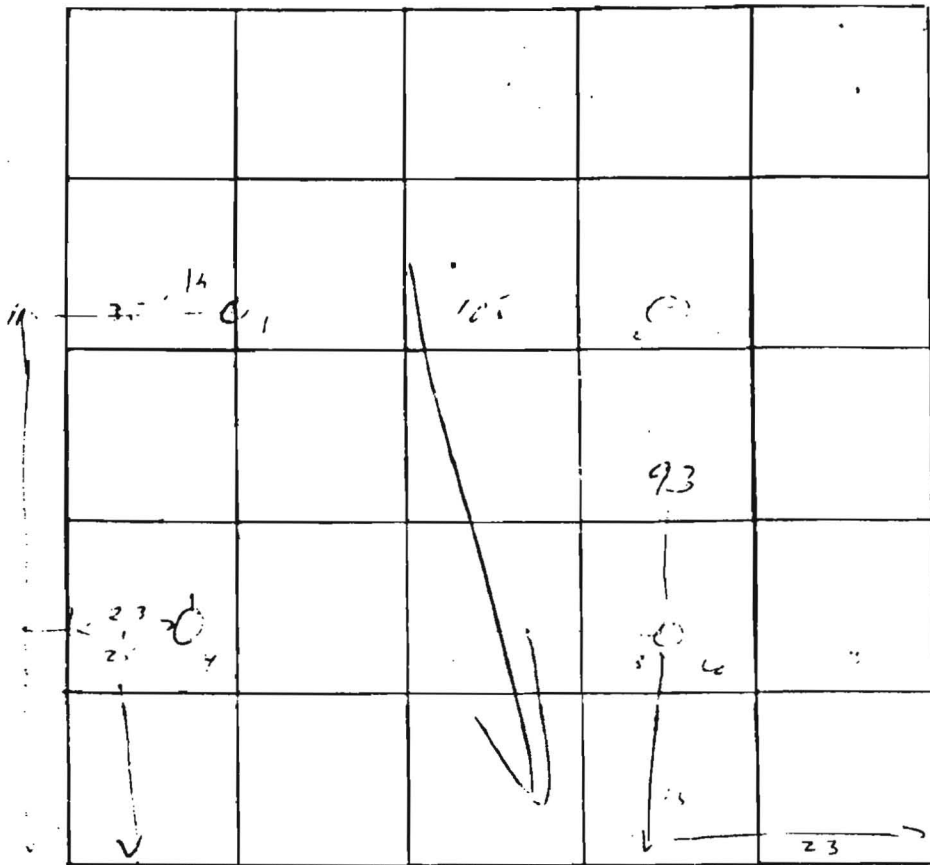

INDICATE NORTH - NAME ADJOINING ROADWAY AS BASE LINE

DATE	TEST NO	DEPTH	PRE WET		TEST DROP		TIME
			START	STOP	START	STOP	
3/6	1	5	103	104	104	105	4
	1A	12	103	105	105	111	5
	2	10	V's				
	3	6	117	119	119	121	7:15
	3A	12	117	121	121	125	4:15
	4	11	V's				

9  
8  
12  
4:19  
25  
120/125  
121/123  
127-13  
131-135 (G)

REMARKS \_\_\_\_\_

TYPE OF SOIL clay

TESTED BY R. M. f. H. z ALSO PRESENT \_\_\_\_\_