

~~12/2/76~~
12/3/76

PERMIT

P 24712

SEWAGE DISPOSAL SYSTEM

A 22397

MARYLAND STATE DEPARTMENT OF HEALTH

HOWARD COUNTY

INDEXED

ELLICOTT CITY

DISTRICT 4th

DATE 11/12/76

Jim Brittingham IS PERMITTED TO INSTALL ALTER

ADDRESS 3004 N. Rogers Ave., Ellicott City, Md. PHONE 461-1870

A SEWAGE DISPOSAL SYSTEM LOCATED AT _____

SUBDIVISION _____ ROAD Bushy Park Rd. LOT 8

PROPERTY OWNER Floyd Grayson

ADDRESS _____

SPECIFICATIONS 3 Bedrooms

DRAIN FIELD _____ DEPTH _____ FEET. BOTTOM AREA _____ SQ. FT.

SEEPAGE PITS _____ ABSORBENT SIDE-WALL AREA _____ SQ. FT.

SEPTIC TANK CAPACITY 1000 GALLONS

FOR GARBAGE GRINDER, INCREASE DISPOSAL AREA 22% & TANK CAPACITY 50%.

OTHER - DRYWELL & TRENCH: 175 sq. ft. per bedroom, inlet to be 5 feet below original grade maximum depth below original grade 12 ft. effective ground starts at 5 ft. giving 7 ft. effective depth. Location drywell 144 from front property line and 10 ft. off left property line when facing the right side of lot approximately parallel to road. Trench to have 5 ft. buffer off from dry well.

NOTES: ALL PIPE FROM HOUSE TO DISPOSAL AREA MUST BE CAST IRON.

PERMIT VOID AFTER THREE YEARS.

NOTE INSTALL STAND PIPE ON SEPTIC TANK AND DRY WELL. STAND PIPES MUST BE 6 INCHES, IN DIAMETER CAST IRON, CONCRETE OR TERRA COTTA ACCEPTED. CALL FOR INSPECTION BEFORE ANY GRAVEL IS INSTALLED.


PLANS APPROVED BY Charles B. Streaker DATE 7/28/76

FILL SEPTIC TANK AND DISTRIBUTION BOX WITH WATER BEFORE CALLING FOR AN INSPECTION. COVER NO WORK UNTIL INSPECTED AND APPROVED.

NEITHER THE HOWARD COUNTY COMMISSIONERS NOR THE HEALTH DEPARTMENT IS RESPONSIBLE FOR THE SUCCESSFUL OPERATION OF ANY SYSTEM.

BLDG. PERMIT SIGNED AND RETURNED 11/3/76
Serial # 47443
Storage Shed

22397

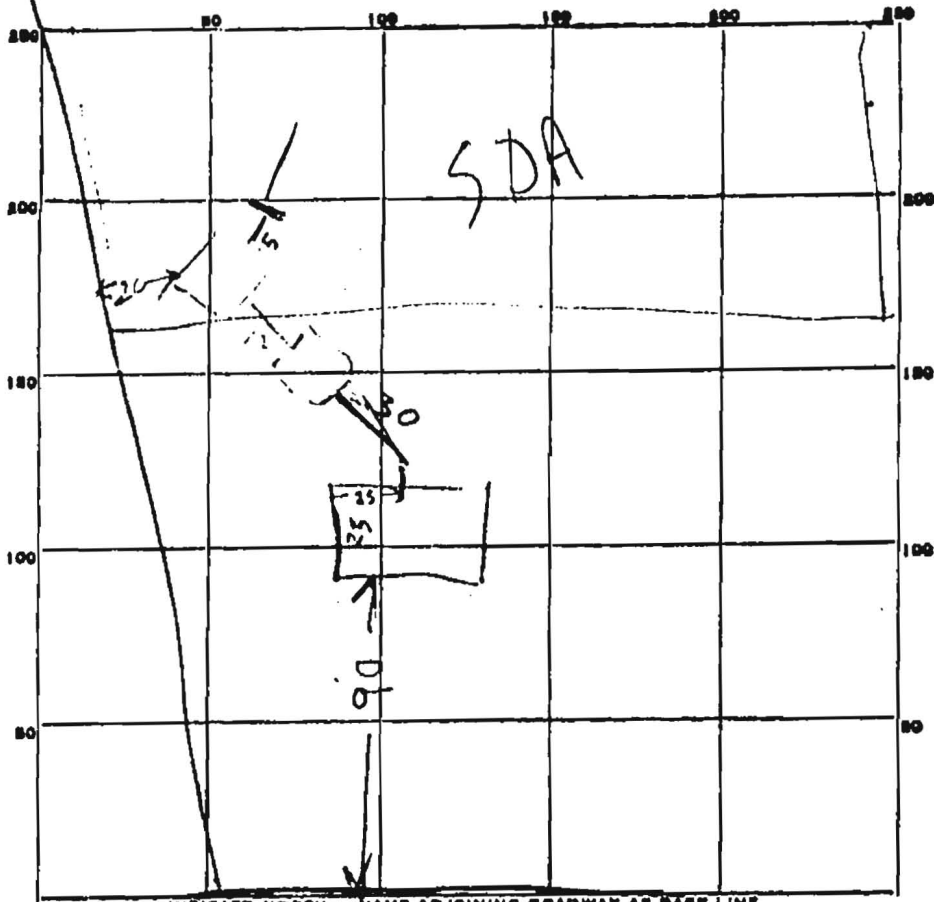

INDICATE NORTH. - NAME ADJOINING ROADWAY AS BASE LINE.

175 8
 3
 525
 105
 304
 489
 105
 6 4/5
 45 7
 8.5 336
 35 15 109
 0-7 244
 10310

PERMIT CARD DW ST
 SEPTIC TANK, LEVEL CLEANOUTS 95
 DISTRIBUTION BOX, LEVEL _____ 130

DITCH
 TILE FIELD, DEPTH 11 FT. TRENCH WIDTH 2 FT.
 GRAVEL DEPTH _____ IN. TOTAL LENGTH 25 FT.
 NUMBER OF TRENCHES 1 TOTAL ^{side wall} BOTTOM AREA 125
 BEEPAGE PITS, INSIDE DIAMETER ^{outside perimeter} 36 FT. DEPTH BELOW INLET 7 FT.
 ABSORBENT AREA ~~360~~ 360 SQ. FT.

REMARKS 12/2/76 - INSTALL TANK & DRYWELL ADD STONES TO DITCH & CALLUS PH

DATE SYSTEM APPROVED 3 Nov 76 INSPECTOR R. B. [Signature]