

RECORDED

APPLICATION

A 22397

SEWAGE DISPOSAL TESTING

P _____

STATE OF MARYLAND - DEPARTMENT OF HEALTH AND MENTAL HYGIENE

HOWARD COUNTY HEALTH DEPARTMENT
ENVIRONMENTAL HEALTH SERVICES
P. O. BOX 475, ELLICOTT CITY, MARYLAND 21043
TELEPHONE: 444-3000, EXT. 356

DISTRICT 4th

DATE 10/27/75

TO: THE COUNTY HEALTH OFFICER
ELLICOTT CITY, MARYLAND

I, HEREBY, APPLY FOR THE NECESSARY TEST IN ORDER TO CONSTRUCT (OR RECONSTRUCT) A SEWAGE DISPOSAL SYSTEM.

PROPERTY OWNER Richard Talley property

ADDRESS RFD #2, Daisy Rd. & Rte. 144, Woodbine, Md. PHONE 442-2300

PROPERTY LOCATION:

SUBDIVISION _____ LOT NO. 8

ROAD AND DESCRIPTION Bushy Park Road

SIZE OF LOT 1.114 acres TYPE BLDG. 3 or 4 bedrooms
NUMBER OF BEDROOMS _____

IF NOT SINGLE RESIDENCE DESCRIBE _____

THE SYSTEM INSTALLED UNDER THIS APPLICATION IS ACCEPTABLE ONLY UNTIL PUBLIC FACILITIES BECOME AVAILABLE.

SIGNATURE OF APPLICANT /s/ Steve Costello

APPROVED BY _____ FOR _____ DATE _____
(KIND OF SYSTEM)


REJECTED BY _____ FOR _____ DATE _____
(KIND OF SYSTEM)

HOLD PENDING FURTHER TESTS _____ DATE _____

REASONS FOR REJECTION OR HOLDING _____

THIS IS NOT A PERMIT

A 22397

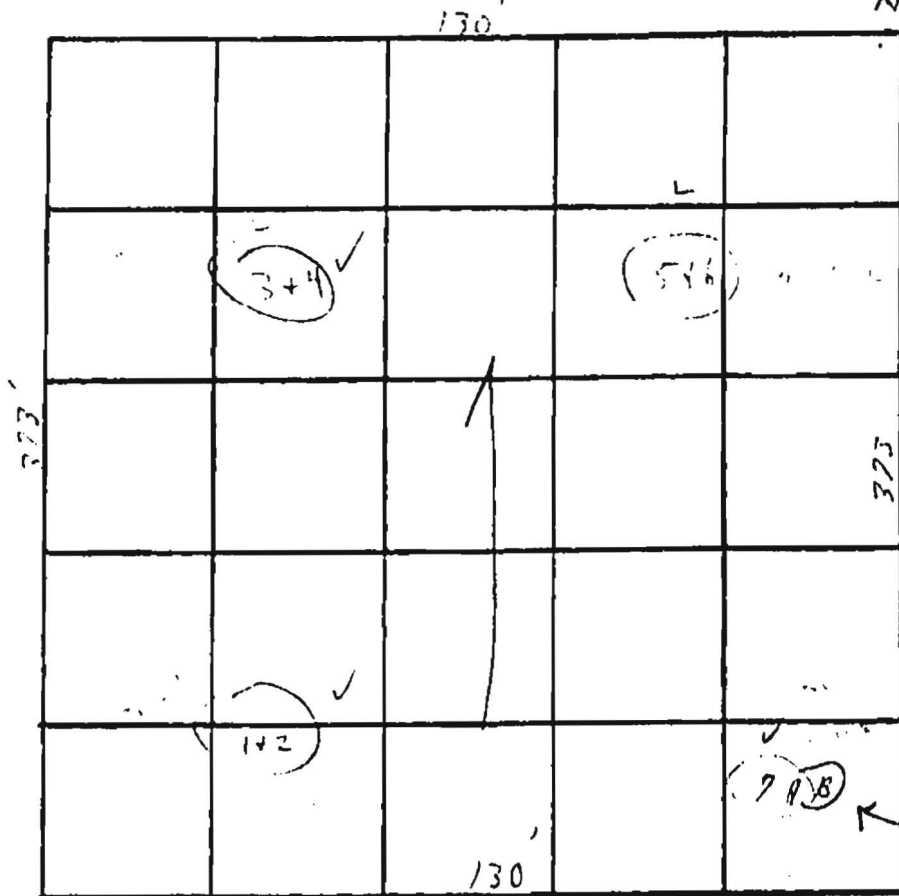

lot 8

1.114 acres

lot #8

INDICATE NORTH. - NAME ADJOINING ROADWAY AS BASE LINE.

Stoney Brook Rd

DATE	TEST NO.	DEPTH	PRE-WET		TEST - 1" DROP		TIME
			START	STOP	START	STOP	
10/28/75	1	5'	12:57	12:57	12:58	1:01	X
	(H) 2	12'	12:56	12:58	12:58	1:01	3m
	(H) 3	5'	12:37	12:37	12:37	12:37	
	(L) 4	12'	12:37	12:42	12:42	12:54	12m
	5						
	(L) 6						
	7A	3'	1:40	1:42	1:42	2:13	26m
	7B	12'	2:05	2:10	2:10	2:30	10m
	2A	1'	1:36	1:39	1:39	1:46	7m
	1A	5 1/2'	1:29	1:43	1:43	2:02	20m
	5A	6'	1:45	2:00	2:00	2:28	28m

Unit 4'
Good ground
at 5' average

REMARKS (Open Field) slash ground before day

TYPE OF SOIL light sandy loam

TESTED BY C.K.S. ALSO PRESENT: Costello & Men