

LICENSED AND PERMITS
 ONE DRIVE
 407 2793
 CROWN 1410 313-1810
 DEN 1410 313-3800

**HOWARD COUNTY
 PERMIT APPLICATION**

PERMIT NUMBER
 B-149 358 JAB

232 Haver Ridge
 Milcott City, Mo
 SDP/WP/Petition #:
 Subdivision
 Area Lot
 Parcel 4/22 Grid 9
 Ordinate 9149 Lot size 1.33

Property Owner's Name DI SUN
 Address 13232 Haver Ridge
 City Milcott City State Mo Zip Code 20112
 Home Phone (417) 584-1112 Work Phone _____
 Applicant's Name & Mailing Address, (if other than stated hereon):
 Phone _____ Fax _____

Cost \$ 2000
 INSTALL (12-0000)6 AND
 SIDE

Contractor Company UNITED PROJECT
 Contact Person REN
 Address 101 W. Rindsville Blvd
 City Mo. Ar. State Mo Zip Code 21771
 License No. 61424
 Phone (301) 827-2823 Fax (301) 827-5391

State _____ Zip Code _____
 Fax _____

Engineer or Architect Company _____
 Contact Person _____
 Address _____
 City _____ State _____ Zip Code _____
 Phone _____ Fax _____

DESCRIPTION - COMMERCIAL

BUILDING DESCRIPTION - RESIDENTIAL

Utilities
 Water Supply:
 Public
 Private
 Sewage Disposal:
 Public
 Private
 Electric Yes No
 Gas Yes No
 Heating System:
 Electric Oil
 Natural Gas
 Propane Gas
 Sprinkler system: N/A
 Full
 Partial
 Other Suppression
 # of Heads _____

Building Characteristics
 SF Dwelling SF Townhouse
 Depth _____ Width _____
 1st floor: _____
 2nd floor: _____
 Basement: _____
 Finished Basement Unfinished Basement
 Crawl space Slab on Grade
 No. of Bedrooms _____
 Multi-family dwellings:
 No. of efficiency units: _____
 No. of 1 BR units: _____
 No. of 2 BR units: _____
 No. of 3 BR units: _____
 Other Structure: _____
 Dimensions: _____
 Footings: _____
 Roof: _____
 State Certified Modular
 Manufactured Home

Utilities
 Water Supply:
 Public
 Private
 Sewage Disposal:
 Public
 Private
 Electric Yes No
 Gas Yes No
 Heating System:
 Electric Oil
 Natural Gas
 Propane Gas
 Sprinkler system: N/A
 NFPA #13D
 NFPA #13R
 Other:

ACRIBER AS FOLLOWS: (1) THAT HE/SHE IS AUTHORIZED TO MAKE THIS APPLICATION; (2) THAT THE INFORMATION IS CORRECT; (3) THAT HE/SHE WILL COMPLY WITH ALL REGULATIONS OF HOWARD COUNTY
 THAT HE/SHE WILL PERFORM NO WORK ON THE ABOVE REFERENCED PROPERTY NOT SPECIFICALLY DESCRIBED IN THIS APPLICATION; (5) THAT HE/SHE GRANTS COUNTY OFFICIALS THE RIGHT TO ENTER ONTO
 THE WORK PERMITTED AND POSTING NOTICES.


Arnold

 Print Name Alvin E. Garsch

 Date 7/12/04

Checks payable to: **DIRECTOR OF FINANCE OF HOWARD COUNTY**
**** PLEASE WRITE NEATLY AND LEGIBLY ****
- FOR OFFICE USE ONLY -


10337

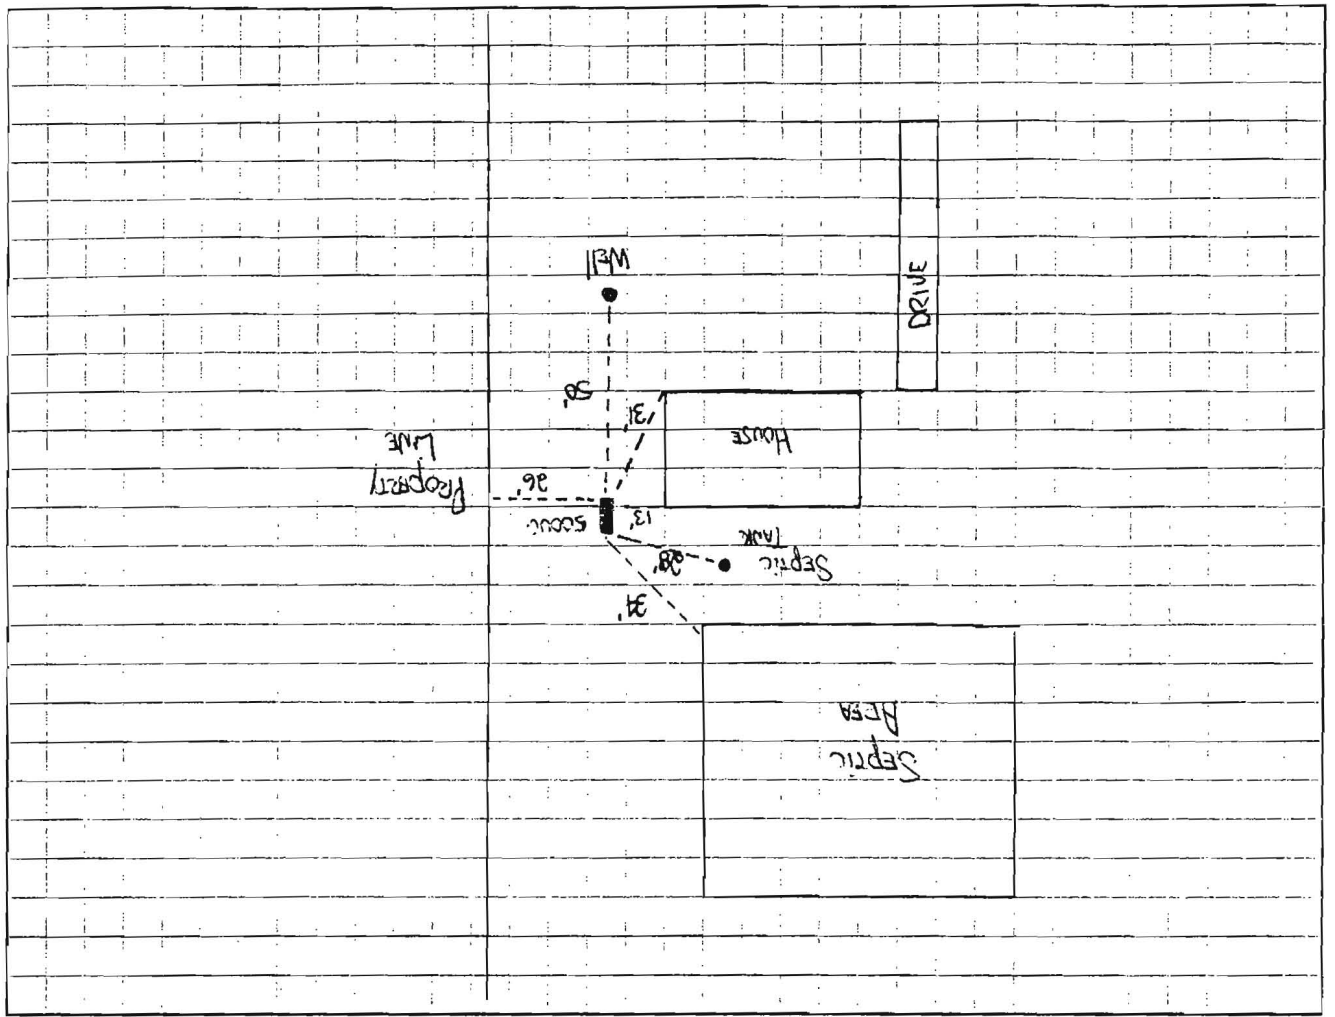

Scale 1" = 50'

Distance From Tank To:
 Right Rear of House: 13'
 Left Front of House: 31'
 Right Side Prop Line: 26'
 Well: 50'
 Septic Tank: 28'
 Septic Area: 34'

L.P. Tank
 O.K.

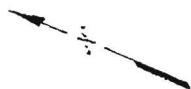

I certify to the best of my knowledge and belief the dwelling shown on this drawing on the property known as 13232 Hunt Ridge

Howard County, Maryland

lies within the lot lines shown as compiled from title or other sources. Other improvements shown are for pictorial purposes only. This drawing is not a boundary survey and has been prepared exclusively for title purposes only.

Lorne J. Hastings


11/29/94

Ruxton Design Corporation
8422 Bellona Lane
Towson, Maryland 21204
(410) 823-5000

Fax (410) 823-0115

Scale 1" = 100'

F-94000388

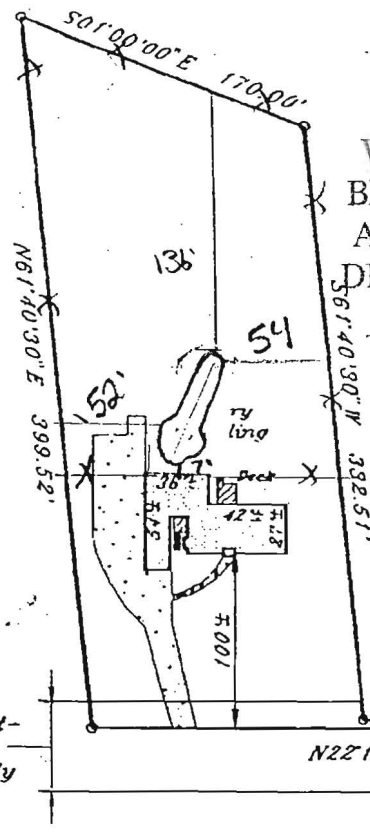

APPROVED

WALK-THRU BUILDING PERMIT

BP# 600159375 A# 28138

APP. SAN OF _____ DATE: 5/2/06

DESC. OF WORK:


25' x 50' inground pool

50' Road Right-of-Way to Howard County

S22°15'34"E 504.10'
N22°15'34"W 658.69'

S22°15'34"E 81.34'
N09°59'03"E 79.66'
S22°15'34"W 81.34'
N22°15'34"E

⊕ HUNT RIDGE

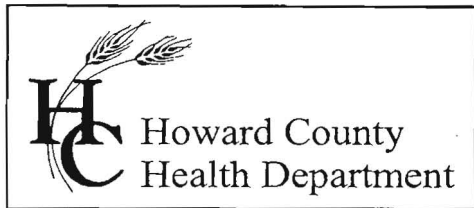

3525 H Ellicott Mills Drive, Ellicott City, MD 21043
(410) 313-2640 Fax (410) 313-2648
TDD (410) 313-2323 Toll Free 1-866-313-6300
website: www.hchealth.org

Penny E. Borenstein, M.D., M.P.H., Health Officer

June 7, 2004

TO: Mr. Bean Sun
13232 Hunt Ridge Road
Ellicott City, MD 21042

FROM: John A. Boris, Jr., R.S.
Program Director
Well and Septic Program

RE: Proposed relocation of septic area
800148137


Dear Mr. Sun:

This letter is in reference to a percolation test application received from Fyock Septic Service on 5/26/04 to relocate a portion of the sewage disposal area (SDA) for the purpose of adding a pool to the residence.

After reviewing the property information it was noted that groundwater was encountered in the test pits that were dug on the low side of the SDA. Therefore, based on the review of the test notes, any future adjustments attempting to be made lower than the current SDA will **require wet season testing**. Wet season testing is typically performed between February and April in areas where a seasonably high groundwater is encountered.

Your current options are to either relocate your proposed pool location to the rear of the lot or wait until next spring for the wet season test period to begin. Applicant is also reminded that it is their responsibility to contact the contractor to set up a test date when wet season testing conditions exist.

If you have any questions regarding this notice, you may contact me at (410) 313-1771.

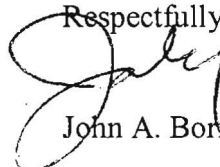Respectfully,

John A. Boris, Jr., R.S.

JAB

Cc: Fyock Septic Service
File