

APPLICATION

A. 28138

P. _____

SEWAGE DISPOSAL TESTING

STATE OF MARYLAND - DEPARTMENT OF HEALTH AND MENTAL HYGIENE

HOWARD COUNTY HEALTH DEPARTMENT
ENVIRONMENTAL HEALTH SERVICES
P. O. BOX 476, ELLICOTT CITY, MARYLAND 21043
TELEPHONE: 465-5000, EXT. 356

DISTRICT 3rd

DATE 6/2/78

TO: THE COUNTY HEALTH OFFICER
ELLICOTT CITY, MARYLAND

BLDG. PERMIT SIGNED
AND RETURNED Vllk3
Suit # 52182

I, HEREBY, APPLY FOR THE NECESSARY TEST IN ORDER TO CONSTRUCT (OR RECONSTRUCT) A SEWAGE DISPOSAL SYSTEM.

PROPERTY OWNER Dr. Richard Hemphill Salvatore + Terrie Schitino
ADDRESS 9734 Frederick Road
Ellicott City, Md PHONE 461-7828

PROPERTY LOCATION:

SUBDIVISION Triadelphia Farms II LOT NO. 7B
13270 ROAD AND DESCRIPTION Triadelphia Road

SIZE OF LOT ? TYPE BLDG. 3 or 4 bedrooms
NUMBER OF BEDROOMS

IF NOT SINGLE RESIDENCE DESCRIBE _____

THE SYSTEM INSTALLED UNDER THIS APPLICATION IS ACCEPTABLE ONLY UNTIL PUBLIC FACILITIES BECOME AVAILABLE.

SIGNATURE OF APPLICANT /s/ Dennis M. Rush

APPROVED BY Raymond Hodger FOR TRENCHES OR DRY WELL & TRENCH DATE 3/10/82
(KIND OF SYSTEM)

REJECTED BY _____ FOR _____ DATE _____
(KIND OF SYSTEM)

HOLD PENDING FURTHER TESTS in wet season only F. Skinner DATE 6/29/78

REASONS FOR REJECTION OR HOLDING Water at 8 to 11' in low perc test hole to

2/2/79 - HOLD FOR REVIEW WATER IN 1978 R17 2/21/79
perc time OK but need certified Hole House Site Well site Field
Run Top R17


THIS IS NOT A PERMIT

A28138

A28138

TRIDELPHIA FARMS II Lot 7B

————— FENCE —————

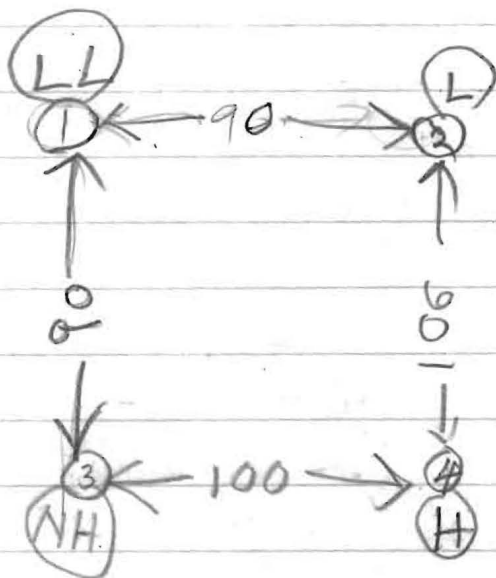

H = HIGH
 NH = NEXT HIGH
 LL = LOWEST
 L = LOW


3012 PROFILE
 ALL HOLES
 2-3 FT. CLAY NEAR TOP
 BOTTOM ALL SAND & DRY

DATE	#	DEPTH	START	STOP	START	STOP	TIME
2/1/79	1S	2 1/2	217	219	219	223	4
	1D	12 1/2	217	225	225	237	12
	2S	3	235	238	238	244	6
	2D	13	236	245	245	256	11
	3V	12	TOP 2 FT CLAY ALL SAND		DRY		
	4D	11 1/2	327	330	330	336	6
2/1/79	4S	3	327	329	329	331	2
	5						


also present D. Reeves
 Penny

Tested By R. Hodge & M. B.

Center's
copy
for water
depth data

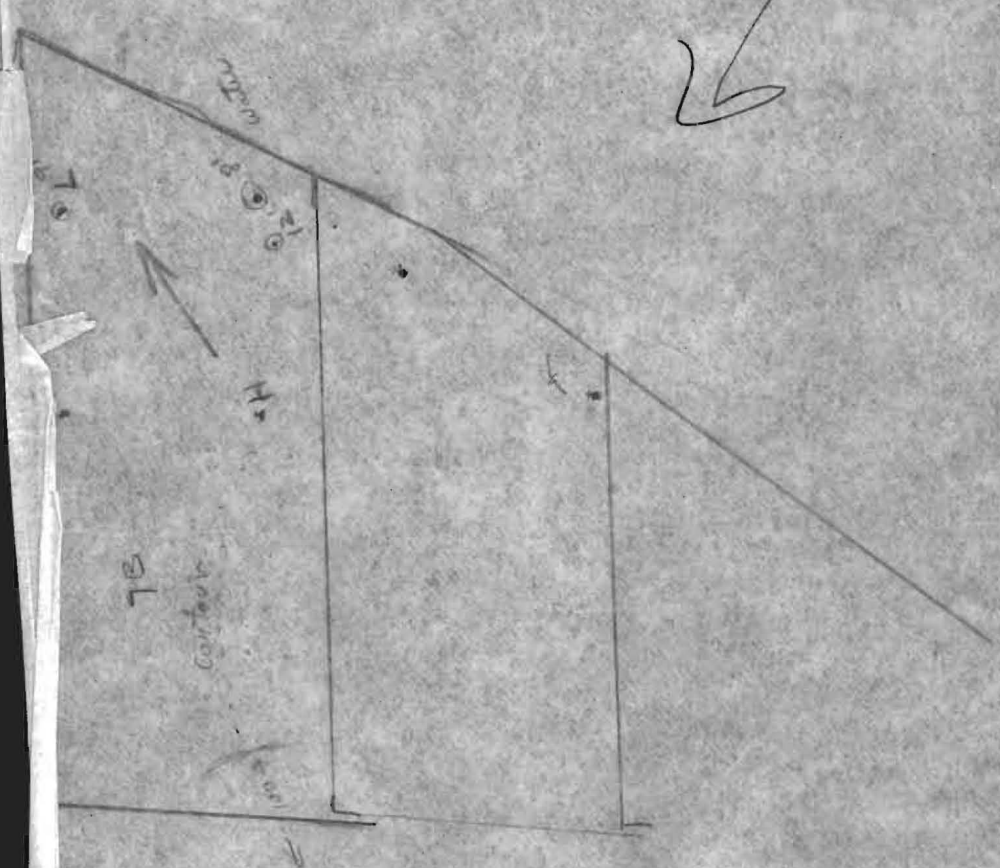

1/16 100 ft

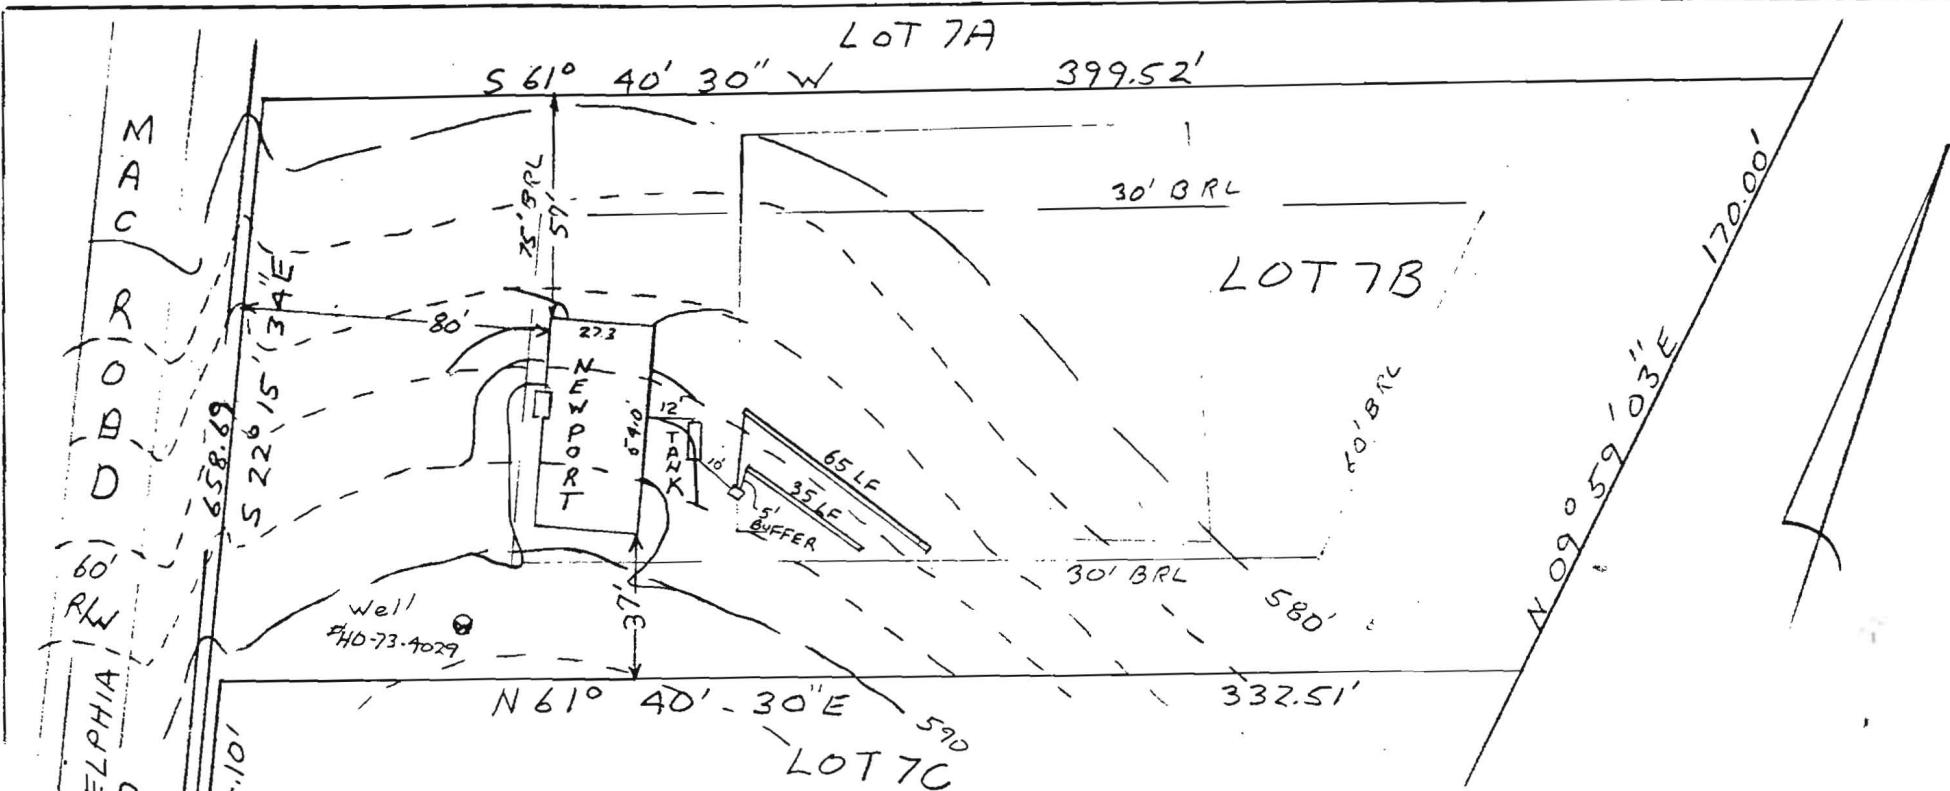

HOUSE:

FIRST FLOOR	592.00
BASEMENT	583.00
INVERT	584.80

SEPTIC TANK:

EXISTING GRADE	587.0
PROPOSED GRADE	588.0
INVERT IN	584.55
INVERT OUT	584.30

DISTRIBUTION BOX:

EXISTING GRADE	587.20
PROPOSED GRADE	587.20
INVERT	584.20

TRENCHES:

	WIDTH	STONE	INVERT	BOTTOM	LENTH
#1	2'	5'	583.5	578.5	35'
#2	2'	5'	582.7	577.7	65'

11/1/83
Sketch OK.
J.S.

PLOT PLAN
LOT 7B

TRIADDELPHIA FARMS II
3rd ELECTION DISTRICT
HOWARD COUNTY MARYLAND


SCALE 1"=50' DATE 10/13/82

I certify the above measurements and elevations are actual and true for this property.

J. Carl Hudgins
J. Carl Hudgins

10/16/81 wellsite lot 7Bok.
F.S.

K&E BALTIMORE 10 518 ALBANY 9-76 MC64936

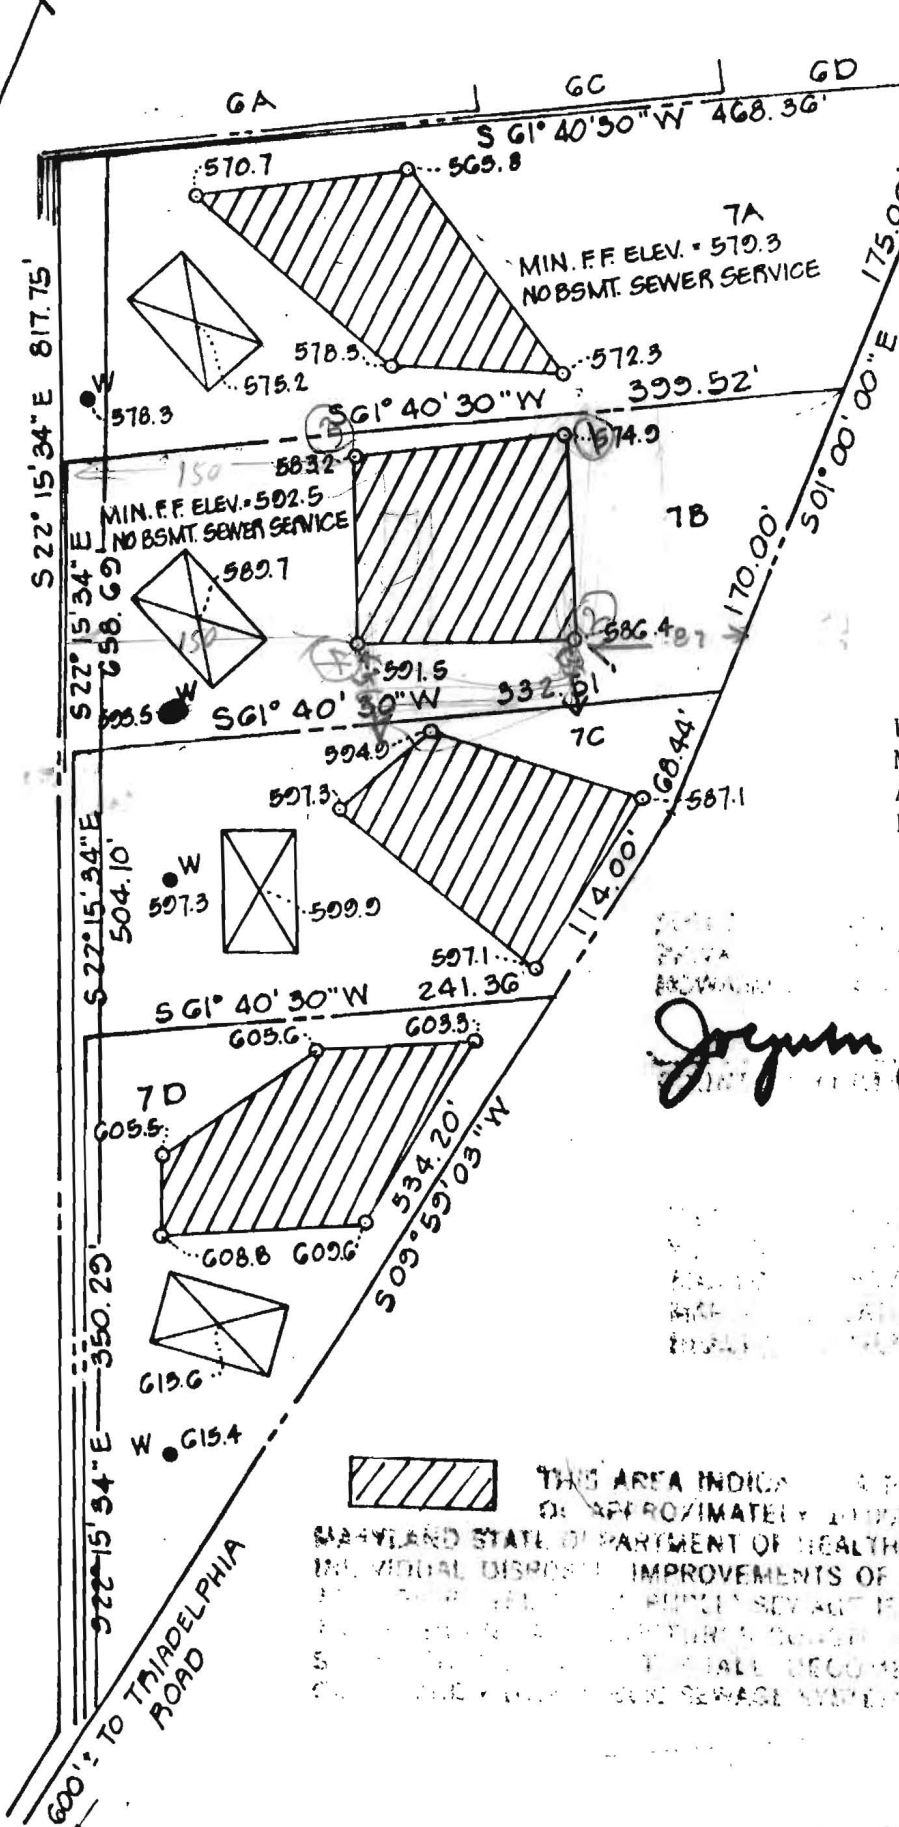

NOTE:
PERCOLATION TEST HOLES SHOWN HEREON AND INDICATED THUS (O) HAVE BEEN FIELD LOCATED BY TRANSIT STADIA METHOD, BASED ON STAKE OUT OF PROPERTY CORNERS BY TRANSIT STADIA METHOD AT THE TIME OF TESTS. VERTICAL DATUM IS ASSUMED.

WELL AND SEPTIC LOCATION MUST BE STAKED, APPROVED AND INSTALLED BEFORE ANY PERMITS ARE SIGNED.

AND
DEPARTMENT
Joeyun Boyles 8-20-17

THIS AREA INDICATES A TRINCH OR TRENCH FOR THE DISPOSAL OF APPROXIMATELY 1000 SQ. FT. OF SEWAGE BY MARYLAND STATE DEPARTMENT OF HEALTH AND GENERAL SERVICES. INDIVIDUAL DISPOSAL IMPROVEMENTS OF ANY KIND SHALL BE THE RESPONSIBILITY OF THE PROPERTY OWNER. SUCH IMPROVEMENTS SHALL BECOME NECESSARY AND BE INSTALLED PRIOR TO THE INSTALLATION OF ANY SEWAGE SYSTEM.

TITLE PERCOLATION TEST PLAT			
PROJECT LOT 7A, 7B, 7C & 7D TRIADELPHIA FARMS II			
LOCATION 3RD ELECTION DISTRICT		HOWARD COUNTY, MD.	
DATE: JULY, 1979	DESIGN BY: -	DRAWN BY: W.H.N.	CHECKED BY: W.G.H.
SCALE: 1" = 100'	JOB NO.: 77228	DRAWING NO.: 1 OF 1	

boender associates engineers
surveyors
planners

BALTIMORE 301-465-7777 ♦ SALISBURY 301-749-1286

7 ABCD

4/17/78

MAN

File #

A-28138

DR. SIM


(410) 531-1442

MODE	CONNECTION TEL	CONNECTION ID	USAGE T	PAGES
RY 68	3017389049		01'17	02'00

YBM INC

301 649 1923

* ACTIVITY REPORT *

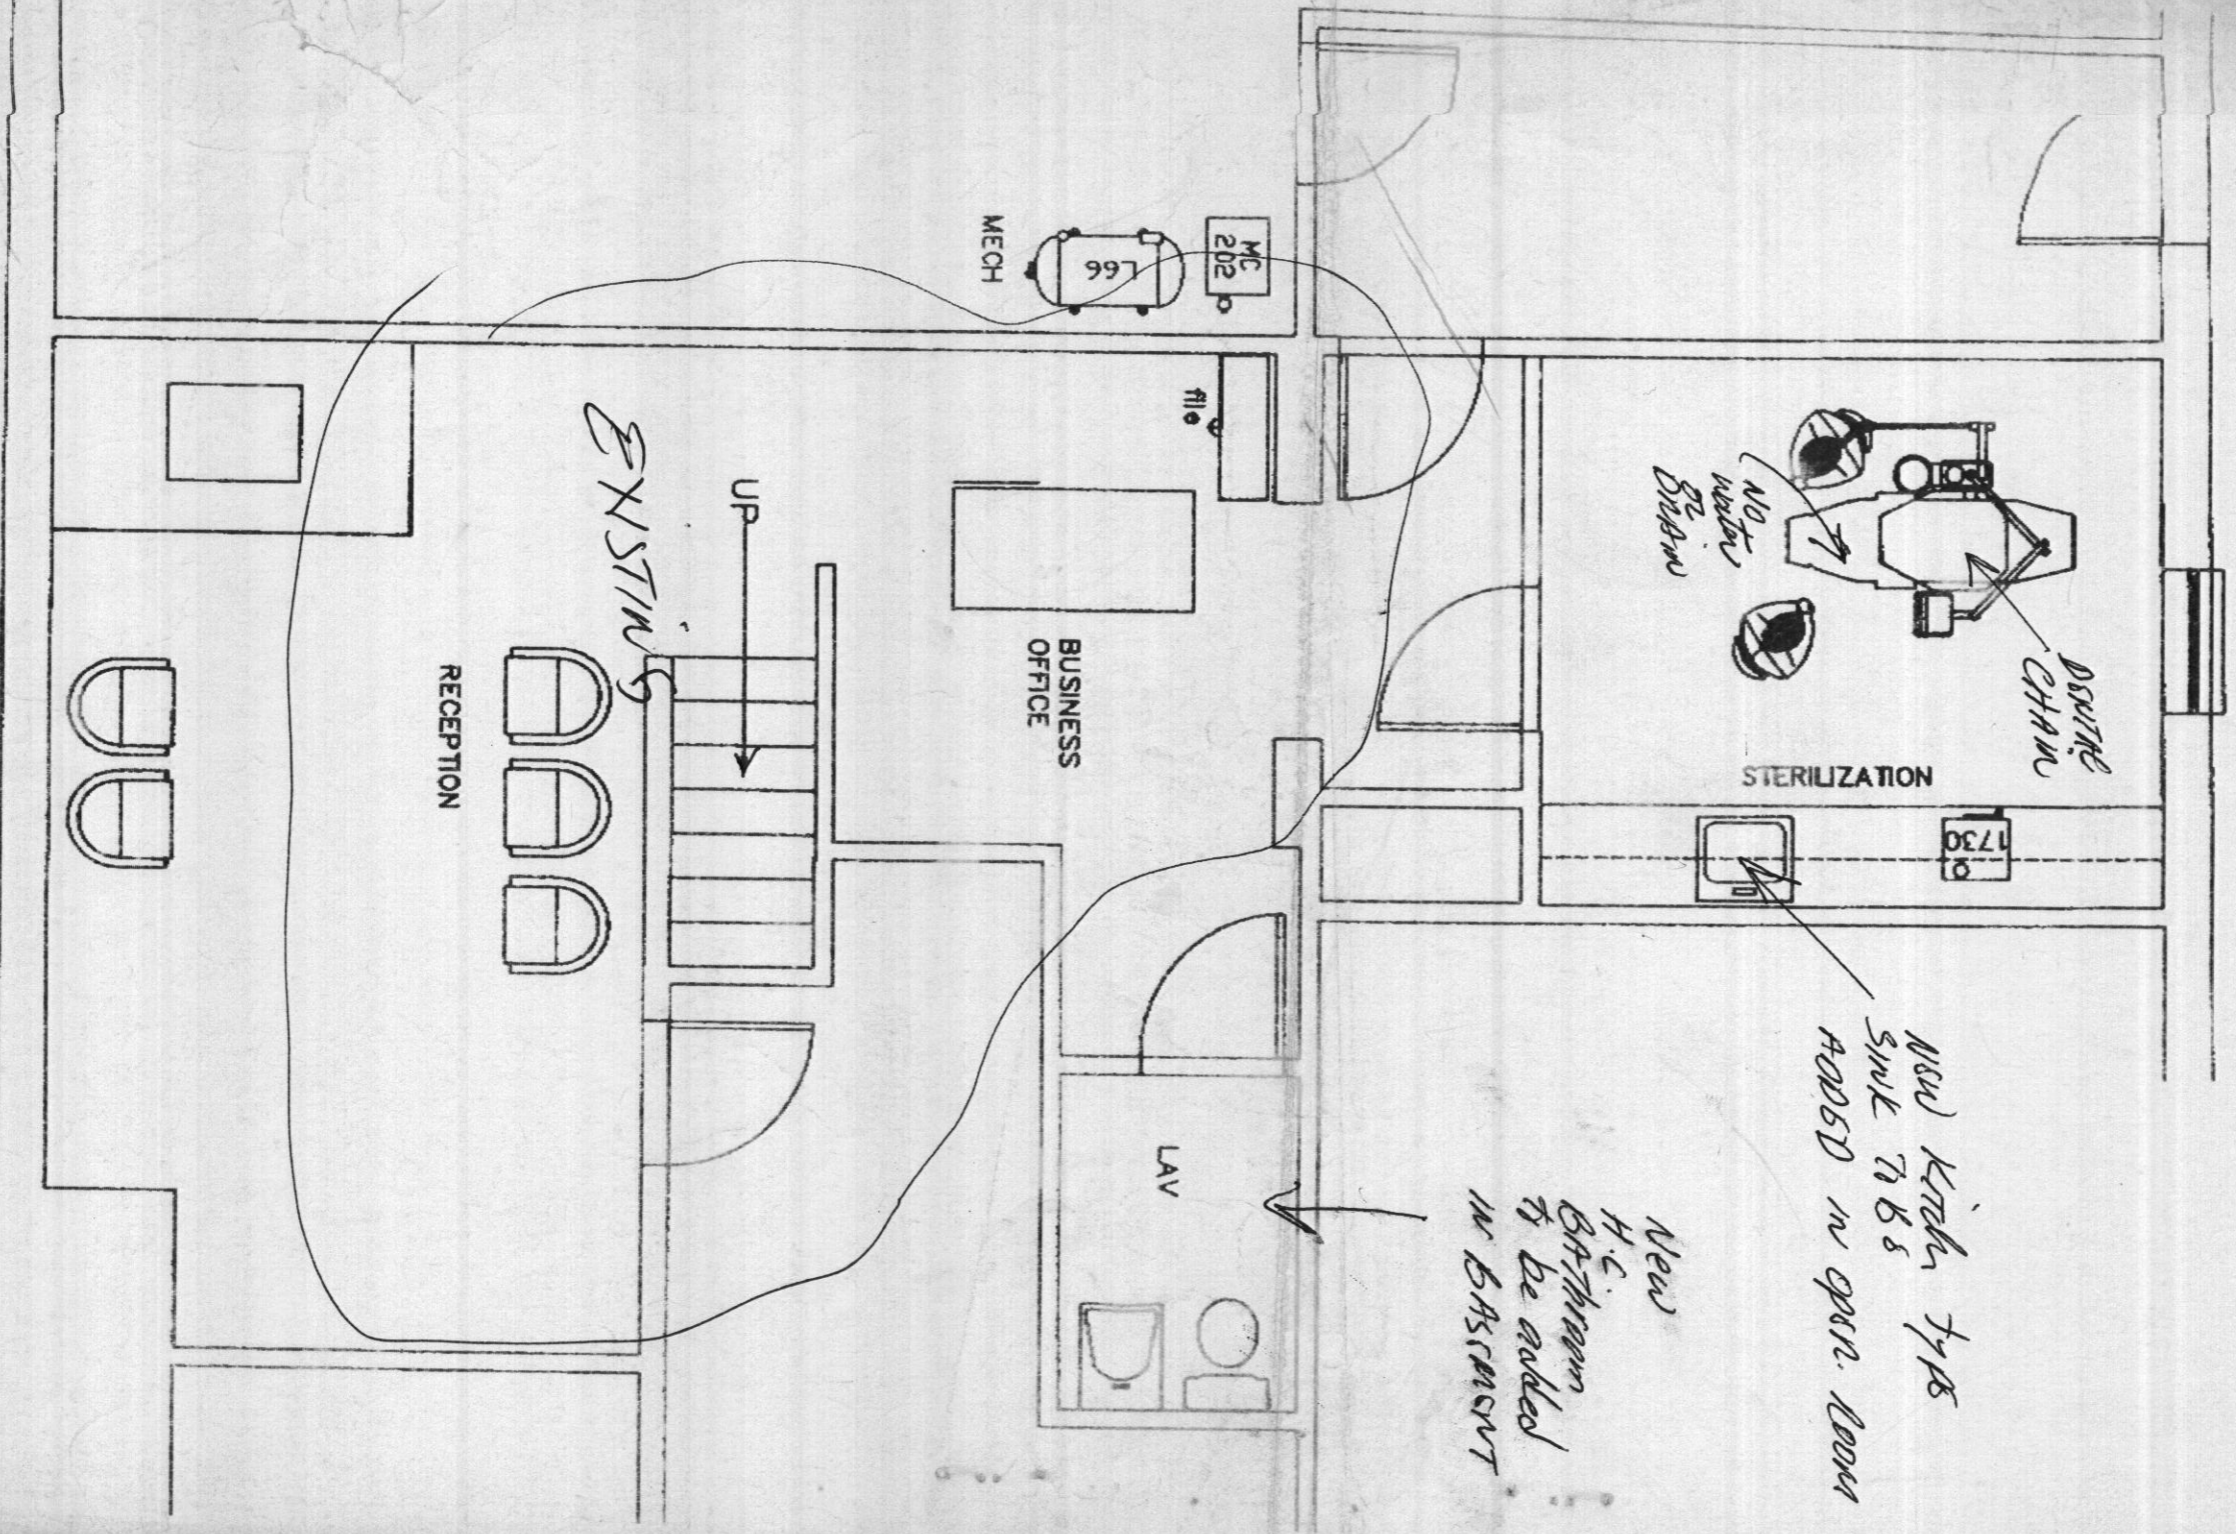

New kitchen type sink TBs added in oper. room

New H.C. Bathroom to be added in basement

NO TOILET OR DRAIN

DENTAL CHAIR

STERILIZATION

1730

MC 202

L66

MECH

BUSINESS OFFICE

LAV

RECEPTION

EXISTING

UP





DEPARTMENT OF PLANNING & ZONING

Joseph W. Rutter, Jr., Director

January 10, 1995

Di Sun, D.D.S.
13232 Hunt Ridge
Ellicott City, MD 21042

RE: 13232 Hunt Ridge
Tax Map 22, Block 9, Parcel 422

Dear Dr. Sun:

This is in response to your January 2, 1995 letter asking for approval of a home-based dental practice. Your home property, referenced above, is zoned RR (Rural Residential).

Section 105.C.5 permits a home-based dental practice in the RR District, subject to the requirements of Section 128.C.1. The information provided on your completed application form shows that your proposed dental practice meets the requirements for a home occupation.

Sections 133.D.1.b and 133.D.2.b require a minimum of two parking spaces for a single-family dwelling unit, one space for each nonresident employee and one space for visitors. In order to confirm that the required total of four parking spaces can be provided on the site, please submit a copy of your plot plan or house location survey showing the parking spaces.

If you should have any further questions, please contact Ms. Dace Blaumanis at (410) 313-2393.

Sincerely,

William F. O'Brien, Chief
Division of Comprehensive Planning
and Zoning Administration

RECEIVED
HOWARD COUNTY
HEALTH DEPT.
APR 10 AM 11:54

AS DISCUSSED WITH D, SUN
ACCEPTABLE WITH NO REQUIREMENT
FOR ADDITIONAL SEPTIC CAPACITY
AT THIS TIME.
SEPTIC AREA IS SUITABLE

WFO/DB:vv

cc: Dace Blaumanis, Planner I - Department of Planning and Zoning

at 13232 Hunt Ridge
Ellicott City, MD 21042

Estimated for One operatory dental office
① H₂O Vol. use:

Pt No. 10 pts / day (Max.)

① Bathroom use: 5 times / day
(1.6 Gallon each) = 8 G / day
(G)

Total Bathroom use: 16 G (10 x 1.6 G) / day (Max.)
(Max.)

② Sink H₂O use: 10 G / day (pt/min ; 1 G/min)
(Max. Total)

③ Lab work & Miscellaneous: 10 G / day

Total H₂O use: 44 G / day
(50 G / day Max.)

(Recommendation) = 100 G / day

DI SUN

D's [Signature]
4/10/19

RECEIVED
HOWARD COUNTY
HEALTH DEPT.
95 APR 10 AM 11:54