



Howard County
Health Department

APPLICATION

FOR PERCOLATION TESTING AND SITE EVALUATION

TEST DATE(S) 7/1/04 8:30 A.m. TEST TIME _____ A# 520437
 AGENCY REVIEW: _____ DATE 6/23/2004

DO NOT WRITE ABOVE THIS LINE

I HEREBY APPLY FOR THE NECESSARY TESTING/EVALUATION PRIOR TO ISSUANCE OF SEWAGE DISPOSAL SYSTEM PERMIT(S) TO:

CHECK AS NEEDED:

- CONSTRUCT NEW SEPTIC SYSTEM(S)
- REPAIR/ADD TO AN EXISTING SEPTIC SYSTEM
- REPLACE AN EXISTING SEPTIC SYSTEM

CHECK AS NEEDED:

- NEW STRUCTURE(S)
- ADDITION TO AN EXISTING STRUCTURE
- REPLACE AN EXISTING STRUCTURE

CHECK ONE:

- CREATE NEW LOT(S)
- BUILD ON AN EXISTING LOT IN A SUBDIVISION
- BUILD ON AN EXISTING PARCEL OF RECORD

IS THE PROPERTY WITHIN 2500' OF ANY RESERVOIR?

- YES
- NO

THE TYPE OF STRUCTURE IS:

- RESIDENTIAL WITH 4 PROPOSED BEDROOMS IN THE COMPLETED STRUCTURE (NOTE **UNKNOWN** IF APPROPRIATE)
- COMMERCIAL (PROVIDE DETAIL OF NUMBERS AND TYPES OF EMPLOYEES/ CUSTOMERS ON ACCOMPANYING PLAN)
- INSTITUTIONAL/GOVERNMENT (PROVIDE DETAIL OF NUMBERS AND TYPES OF EMPLOYEES/USERS ON ACCOMPANYING PLAN)

PROPERTY OWNER(S) Chris Tiede

DAYTIME PHONE 443-277-2970 CELL _____ FAX 410-489-0040

MAILING ADDRESS 1720 Saint Michaels Rd Woodlawn MD 21797
 STREET CITY/TOWN STATE ZIP

APPLICANT Chris Tiede

DAYTIME PHONE 443-277-2970 CELL _____ FAX _____

MAILING ADDRESS 1720 Saint Michaels Woodlawn MD 21797
 STREET CITY/TOWN STATE ZIP

APPLICANT'S ROLE: DEVELOPER BUILDER BUYER RELATIVE/FRIEND REALTOR CONSULTANT

PROPERTY LOCATION
 SUBDIVISION/PROPERTY NAME 1242 LOT NO. _____

PROPERTY ADDRESS 1242 Morgan Station Rd Lisbon
 STREET TOWN/POST OFFICE

TAX MAP PAGE(S) _____ GRID _____ PARCEL(S) _____ PROPOSED LOT SIZE 1 acre

AS APPLICANT, I UNDERSTAND THE FOLLOWING: THE SYSTEM INSTALLED SUBSEQUENT TO THIS APPLICATION IS ACCEPTABLE ONLY UNTIL PUBLIC SEWERAGE IS AVAILABLE. THIS APPLICATION IS COMPLETE WHEN ALL APPLICABLE FEES AND A SUITABLE SITE PLAN HAVE BEEN RECEIVED. I ACCEPT THE RESPONSIBILITY FOR COMPLIANCE WITH ALL M.O.S.H.A. AND "MISS UTILITY" REQUIREMENTS. APPROVAL IS BASED UPON SATISFACTORY REVIEW OF A PERC CERTIFICATION PLAN.

TEST RESULTS WILL BE MAILED TO APPLICANT. _____
 SIGNATURE OF APPLICANT

HOWARD COUNTY HEALTH DEPARTMENT, BUREAU OF ENVIRONMENTAL HEALTH, WELL AND SEPTIC PROGRAM
 3525-H ELLICOTT MILLS DRIVE, ELLICOTT CITY, MARYLAND 21043-4544 (410) 313-1771 FAX (410) 313-2648
 TDD (410) 313-2323 TOLL FREE 1-877-4MD-DHMH

AVP ①

Brown
L

Yellow/Brown
micaceous
SI

7'

Yellow/Brown
micaceous
SI/S
w/ 10%
mica schist

11 1/2'

②

Brown
L

Yellow brown
micaceous
SI

6'

Yellow/Brown
Red
micaceous
SI/S
w/ 10%
mica schist

12'

Brown
L

Brown/Red
micaceous
SI


4 1/2'

Purple/Yellow
Brown
micaceous
SI

8 1/2'

Yellow/Brown
SI/S
w/ 10%
Saprotite

12'

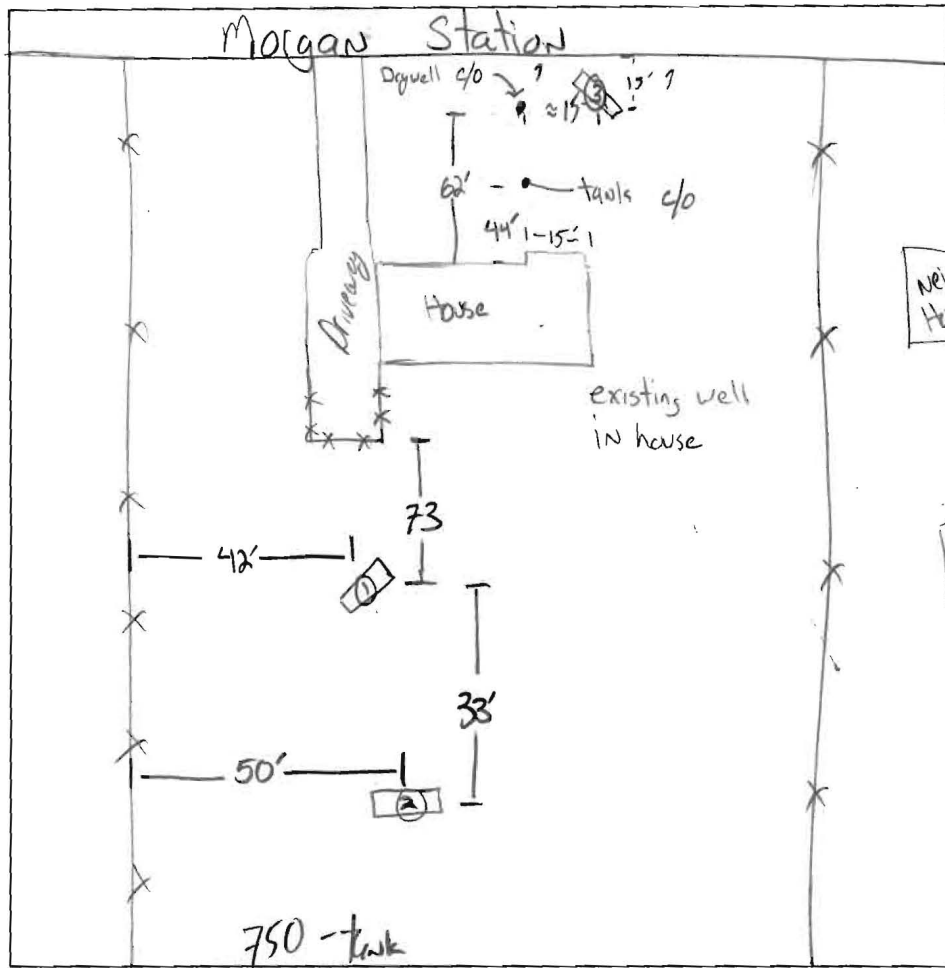

Neighbor House

Might be (2) lots over.

Jul 94 2143

DATE	TEST #	DEPTH	START	BREAK 1" DROP	STOP 2" DROP	TIME OF 2nd INCH	P/F/H
7/1/04	①	4 1/2' / 11 1/2'	8:56	8:58	9:01	3 min	P
	②	12'	- Visual -			OK	P
	③	12'	- Visual -			OK	P

REMARKS Plenty of area behind existing home - tank & Digwell functioning OK 7/1/04


SANITARIAN KJB BACKHOE Willie OTHERS Chris, Mike

TEST HOLES USED IN SDA _____ AVG. PERC TIME _____ SQ. FT/BR _____

TRENCH WIDTH _____ INLET DEPTH _____ MAX. BOT DEPTH _____ EFFECTIVE SW _____

NOTES.

- 1) B.R.L. information, if shown, was obtained from existing record plat of local agencies and is not guaranteed by NTT, Inc.
- 2) Building line and/or Flood Zone information is subject to the interpretation of the originator.
- 3) NTT, Inc. does not certify to unknown or unrecorded encroachments or overlaps.
- 4) Property markers NOT found, or guaranteed by this location.
- 5) Setback distance accuracy: ±4'
- 6) Some ground level objects obscured due to viewlines.

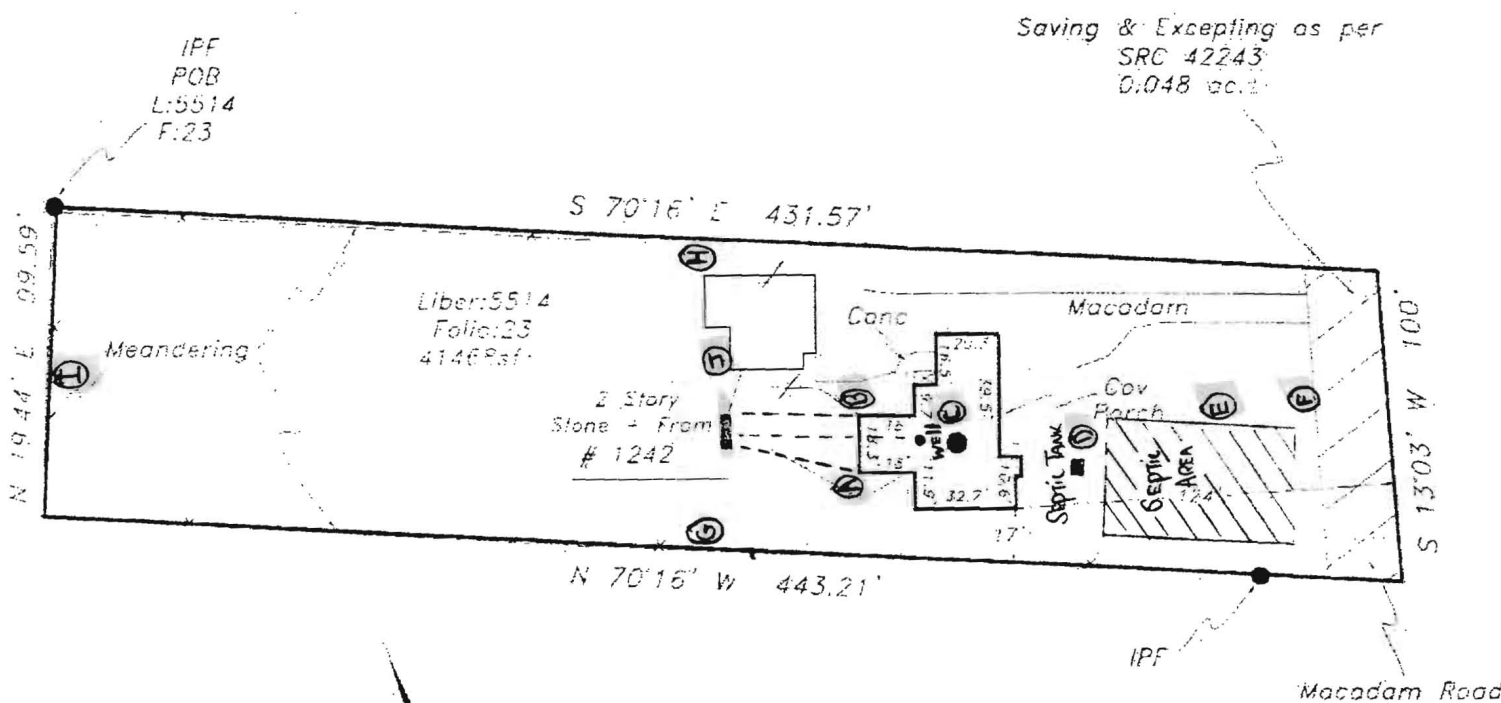

1242 Morgan Station Road

Subject property is shown in Zone 1 on the FIRM Map of Howard County, Maryland on Community Panel # 240044 C00BR Effective 12-4-86

This is to certify that I have surveyed the property shown hereon, being known as 1242 Morgan Station Road and recorded among the land records of Howard County, Maryland in Liber 5514 folio 25 for the purpose of locating the improvements thereon.

- * This plat is of benefit to the consumer only insofar as it is required by a lender or a title insurance company or its agent in connection with contemplated transfer, financing, or refinancing purposes.
- * This plat is not to be relied upon for the establishment of location of fences, garages, buildings, or other existing or future structures.
- * This plat does not provide for the accurate identification of property boundary lines, but such identification may not be required for the transfer of title or for securing financing or refinancing.



LOCATION DRAWING
1242 Morgan Station Road
Howard County, Maryland
Election District No. 04

NTT Associates, Inc.
16205 Old Frederick Road
Mt. Airy, Maryland 21771
Ph. (410)442-2031
Fax No. (410)442-1315

Scale:	1" = 80'
Date:	1-28-05
Field By:	Don
Drawn By:	Don
Drawing #	050031HOC



GASOLINE • PROPANE • HEATING OILS
HEATING • AIR CONDITIONING SALES • SERVICE


GENERAL OFFICE: 230 LINCOLN WAY EAST
NEW OXFORD, PENNSYLVANIA 17350-1296
(717) 624-4311 FAX (717) 624-5850

Distance from Tank to:

- A Corner of House: 39'
- B Corner of House: 37'
- C Well: 56'
- D Septic Tank: 105'
- E Septic Field: 116'
- F Front Property Line: 180'
- G Left Property Line: 30'
- H Right Property Line: 52'
- I Rear Property Line: 210'
- J CORNER OF DETACHED GARAGE: 15'

NOTES:

- 1) B.R.L. information, if shown, was obtained from existing record plat of local agencies and is not guaranteed by NTT, Inc.
- 2) Building line and/or Flood Zone information is subject to the interpretation of the originator.
- 3) NTT, Inc. does not certify to unknown or unrecorded encroachments or overlaps.
- 4) Property markers NOT found, or guaranteed by this location.
- 5) Setback distance accuracy ± 1'
- 6) Some ground line objects obscured due to vegetation.

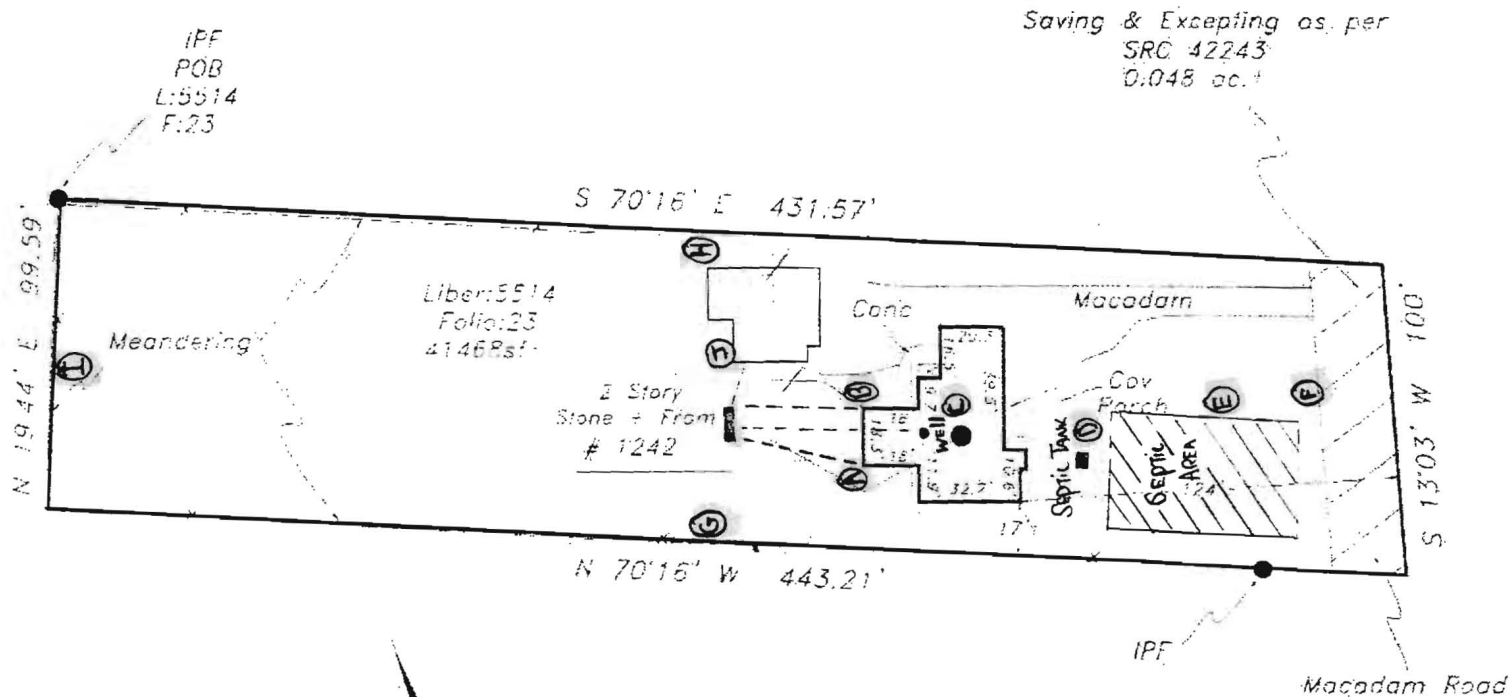

1242 Morgan Station Road

Subject property is shown in Zone 6 on the FIRM Map of Howard County, Maryland on Community Panel # 240044 G00BR Effective 12-4-56

This is to certify that I have surveyed the property shown hereon, being known as: 1242 Morgan Station Road and recorded among the land records of Howard County, Maryland in Liber 5514 folio 25 for the purpose of locating the improvements thereon.



- * This plat is of benefit to the consumer only insofar as it is required by a lender or a title insurance company or its agent in connection with contemplated transfer, financing, or refinancing purposes.
- * This plat is not to be relied upon for the establishment of location of fences, garages, buildings, or other existing or future structures.
- * This plat does not provide for the accurate identification of property boundary lines, but such identification may not be required for the transfer of title or for securing financing or refinancing.

LOCATION DRAWING
1242 Morgan Station Road
Howard County, Maryland
Election District No. 04

NTT Associates, Inc.	Scale: 1" = 60'
16205 Old Frederick Road Mt. Airy, Maryland 21771 Ph. (410)442-2031 Fax No. (410)442-1315	Date: 1-28-05
	Field By: Don
	Drawn By: Don
	Drawing # 050031HOC



GASOLINE • PROPANE • HEATING OILS
HEATING • AIR CONDITIONING SALES • SERVICE

GENERAL OFFICE: 230 LINCOLN WAY EAST
NEW OXFORD, PENNSYLVANIA 17350-1296
(717) 624-4311 FAX (717) 624-5850

Distance from Tank to:

- A Corner of House: 39'
- B Corner of House: 37'
- C Well: 56'
- D Septic Tank: 105'
- E Septic Field: 116'
- F Front Property Line: 180'
- G Left Property Line: 30'
- H Right Property Line: 52'
- I Rear Property Line: 210'
- J CORNER OF DETACHED GARAGE: 15'



GASOLINE • PROPANE • HEATING OILS
HEATING • AIR CONDITIONING SALES • SERVICE

GENERAL OFFICE: 230 LINCOLN WAY EAST
NEW OXFORD, PENNSYLVANIA 17350-1296
(717) 624-4311 FAX (717) 624-5850

Distance from Tank to:

- A Corner of House: 39'
- B Corner of House: 37'
- C Well: 56'
- D Septic Tank: 105'
- E Septic Field: 116'
- F Front Property Line: 180'
- G Left Property Line: 30'
- H Right Property Line: 52'
- I Rear Property Line: 210'
- J CORNER OF DETACHED GARAGE: 15'