



APPLICATION

FOR PERCOLATION TESTING AND SITE EVALUATION

TEST DATE(S) 6/24/04 TEST TIME 9:00 AP 520372
 AGENCY REVIEW: _____ DATE _____

DO NOT WRITE ABOVE THIS LINE

I HEREBY APPLY FOR THE NECESSARY TESTING/EVALUATION PRIOR TO ISSUANCE OF SEWAGE DISPOSAL SYSTEM PERMIT(S) TO:

CHECK AS NEEDED:

- CONSTRUCT NEW SEPTIC SYSTEM(S)
- REPAIR/ADD TO AN EXISTING SEPTIC SYSTEM
- REPLACE AN EXISTING SEPTIC SYSTEM

CHECK AS NEEDED:

- NEW STRUCTURE(S)
- ADDITION TO AN EXISTING STRUCTURE
- REPLACE AN EXISTING STRUCTURE

CHECK ONE:

- CREATE NEW LOT(S)
- BUILD ON AN EXISTING LOT IN A SUBDIVISION
- BUILD ON AN EXISTING PARCEL OF RECORD

IS THE PROPERTY WITHIN 2500' OF ANY RESERVOIR?

- YES
- NO

THE TYPE OF STRUCTURE IS:

- RESIDENTIAL WITH _____ PROPOSED BEDROOMS IN THE COMPLETED STRUCTURE (NOTE *UNKNOWN* IF APPROPRIATE)
- COMMERCIAL (PROVIDE DETAIL OF NUMBERS AND TYPES OF EMPLOYEES/ CUSTOMERS ON ACCOMPANYING PLAN)
- INSTITUTIONAL/GOVERNMENT (PROVIDE DETAIL OF NUMBERS AND TYPES OF EMPLOYEES/USERS ON ACCOMPANYING PLAN)

PROPERTY OWNER(S) SCOTT ROBBINS

DAYTIME PHONE _____ CELL _____ FAX _____

MAILING ADDRESS 10790 OLD FREDERICK RD
STREET CITY/TOWN STATE ZIP

APPLICANT FOGLES SEPTIC CLEAN, INC

DAYTIME PHONE 410-995-5670 CELL _____ FAX _____

MAILING ADDRESS 580 OBRECHT ROAD, SYKEVILLE MD
STREET CITY/TOWN STATE ZIP

APPLICANT'S ROLE: DEVELOPER BUILDER BUYER RELATIVE/FRIEND REALTOR CONSULTANT

PROPERTY LOCATION
SUBDIVISION/PROPERTY NAME _____ LOT NO. _____

PROPERTY ADDRESS 10790 OLD FREDERICK ROAD
STREET TOWN/POST OFFICE

TAX MAP PAGE(S) 10 GRID 23 PARCEL(S) 103 PROPOSED LOT SIZE _____

AS APPLICANT, I UNDERSTAND THE FOLLOWING: THE SYSTEM INSTALLED SUBSEQUENT TO THIS APPLICATION IS ACCEPTABLE ONLY UNTIL PUBLIC SEWERAGE IS AVAILABLE. THIS APPLICATION IS COMPLETE WHEN ALL APPLICABLE FEES AND A SUITABLE SITE PLAN HAVE BEEN RECEIVED. I ACCEPT THE RESPONSIBILITY FOR COMPLIANCE WITH ALL M.O.S.H.A. AND "MISS UTILITY" REQUIREMENTS. APPROVAL IS BASED UPON SATISFACTORY REVIEW OF A PERC CERTIFICATION PLAN.

TEST RESULTS WILL BE MAILED TO APPLICANT. _____ SIGNATURE OF APPLICANT

HOWARD COUNTY HEALTH DEPARTMENT, BUREAU OF ENVIRONMENTAL HEALTH, WELL AND SEPTIC PROGRAM
 3525-H ELLICOTT MILLS DRIVE, ELLICOTT CITY, MARYLAND 21043-4544 (410) 313-1771 FAX (410) 313-2648
 TDD (410) 313-2323 TOLL FREE 1-877-4MD-DHMH

AP ① ② ③

red brn
hvy l m
20% Rx

4

lt. brn
tan beige
sand
10%
Frags

-11

④

red orge
brn
hvy l m
WEST 10-15%
Rx

WEST 6-7

4 1/2 EAST

tan beige
mica
sand
10-20%
Frags

11


56

lt. brn
hvy sal m

1-2

lt. brn
tan gray
beige mica
sand
5-10%
soft
saprolite

11-12 1/2

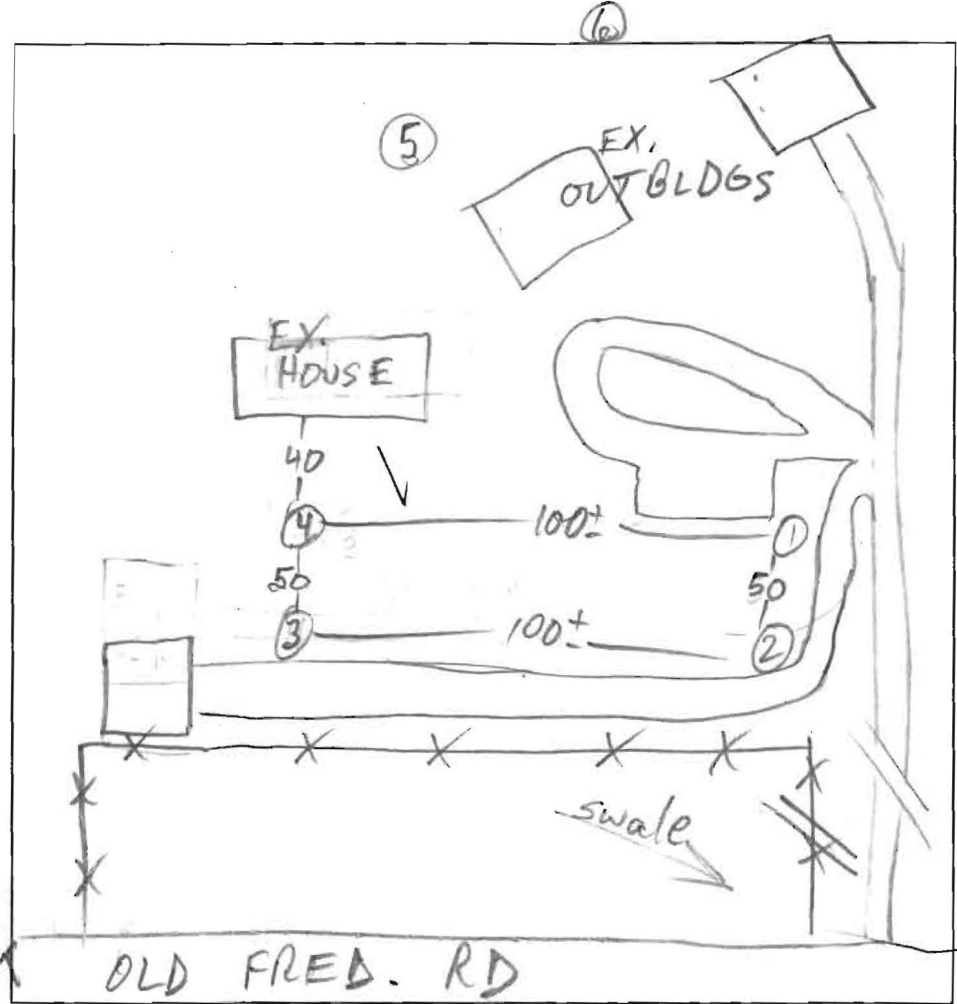

DATE	TEST #	DEPTH	START	BREAK 1" DROP	STOP 2" DROP	TIME OF 2nd INCH	P/F/H
6/24/04	1 v	11					
	2 v	11					
	3 v	11					
	4 S	4 WEST 4 1/2"	10:59	11:11	NO DROP		
	4 V	4 1/2"	11:24	11:30	< 1/4"		
	S2	4' 9"	11:36	11:39	11:44	5	
	5 v	11					
	6 v	12 1/2					

REMARKS _____
 SANITARIAN M. Rifkin BACKHOE _____ OTHERS _____
 TEST HOLES USED IN SDA _____ AVG. PERC TIME _____ SQ. FT/BR _____
 TRENCH WIDTH _____ INLET DEPTH _____ MAX. BOT DEPTH _____ EFFECTIVE SW _____

LOT 1
JAY C. GROC
2085/4E
ZONED:

REUWERS BREEZEWOOD
P.B. 6477

LOT 5
CURT R. SAVER
1426/132
ZONED: RC
IRON PIN FOUND

5 IRON PIN FOUND

6 CONCRETE MONUMENT FOUND

REUWERS BREEZEWOOD
LOT 6
P.B. 6477

LOT 1
4.705 acres

30' B.R.L.
569'16'12"E
41.60'

60' B.R.L.

509'18'35"W
239.39'

30' B.R.L.

558'14'27"E
278.43'

80' B.R.L.

513'00'10"W
196.62'

REBAR SET
8 582'40'48"E
191.45'

REBAR SET
14

577'38'57"E
232.44'

PARCEL 103
1937/582

LOT 2
3.728 acres
INCLUDING
0.334 acres IN
S.H.A. RESERVATION

11 REBAR SET
SDA believed
fictitious
No perc data found per 5/11/04

LOT 1
RUSSELL &
HAZEL BECKETT
1272/663
ZONED: RC

BECKETT PROPERTY
P.B. 5963

LOT 2
SUSAN MYERS
1315/427
1284/52
ZONED: RC

EX. 10' (PRIVATE) USE
IN COMMON EASEMENT OVER
AN EXISTING DRIVEWAY
LIBER 1062 FOLIO 574
PB. 5963

N09'18'35"E
647.69'

30' B.R.L.

30' B.R.L.

509'18'35"W
626.25'

75' B.R.L.

N82'56'14"W
232.29'

S82'56'14"E
232.29'

62.66'

LAND RESERVED FOR THE STATE HIGHWAY
ADMINISTRATION FOR THE PURPOSE OF A
PUBLIC ROAD (0.334 AC.)



F-93-31