


RALPH E FEAGA
TAX MAP 10
PARCEL 121
4.45 AC± (DEED)

DEED NORTH

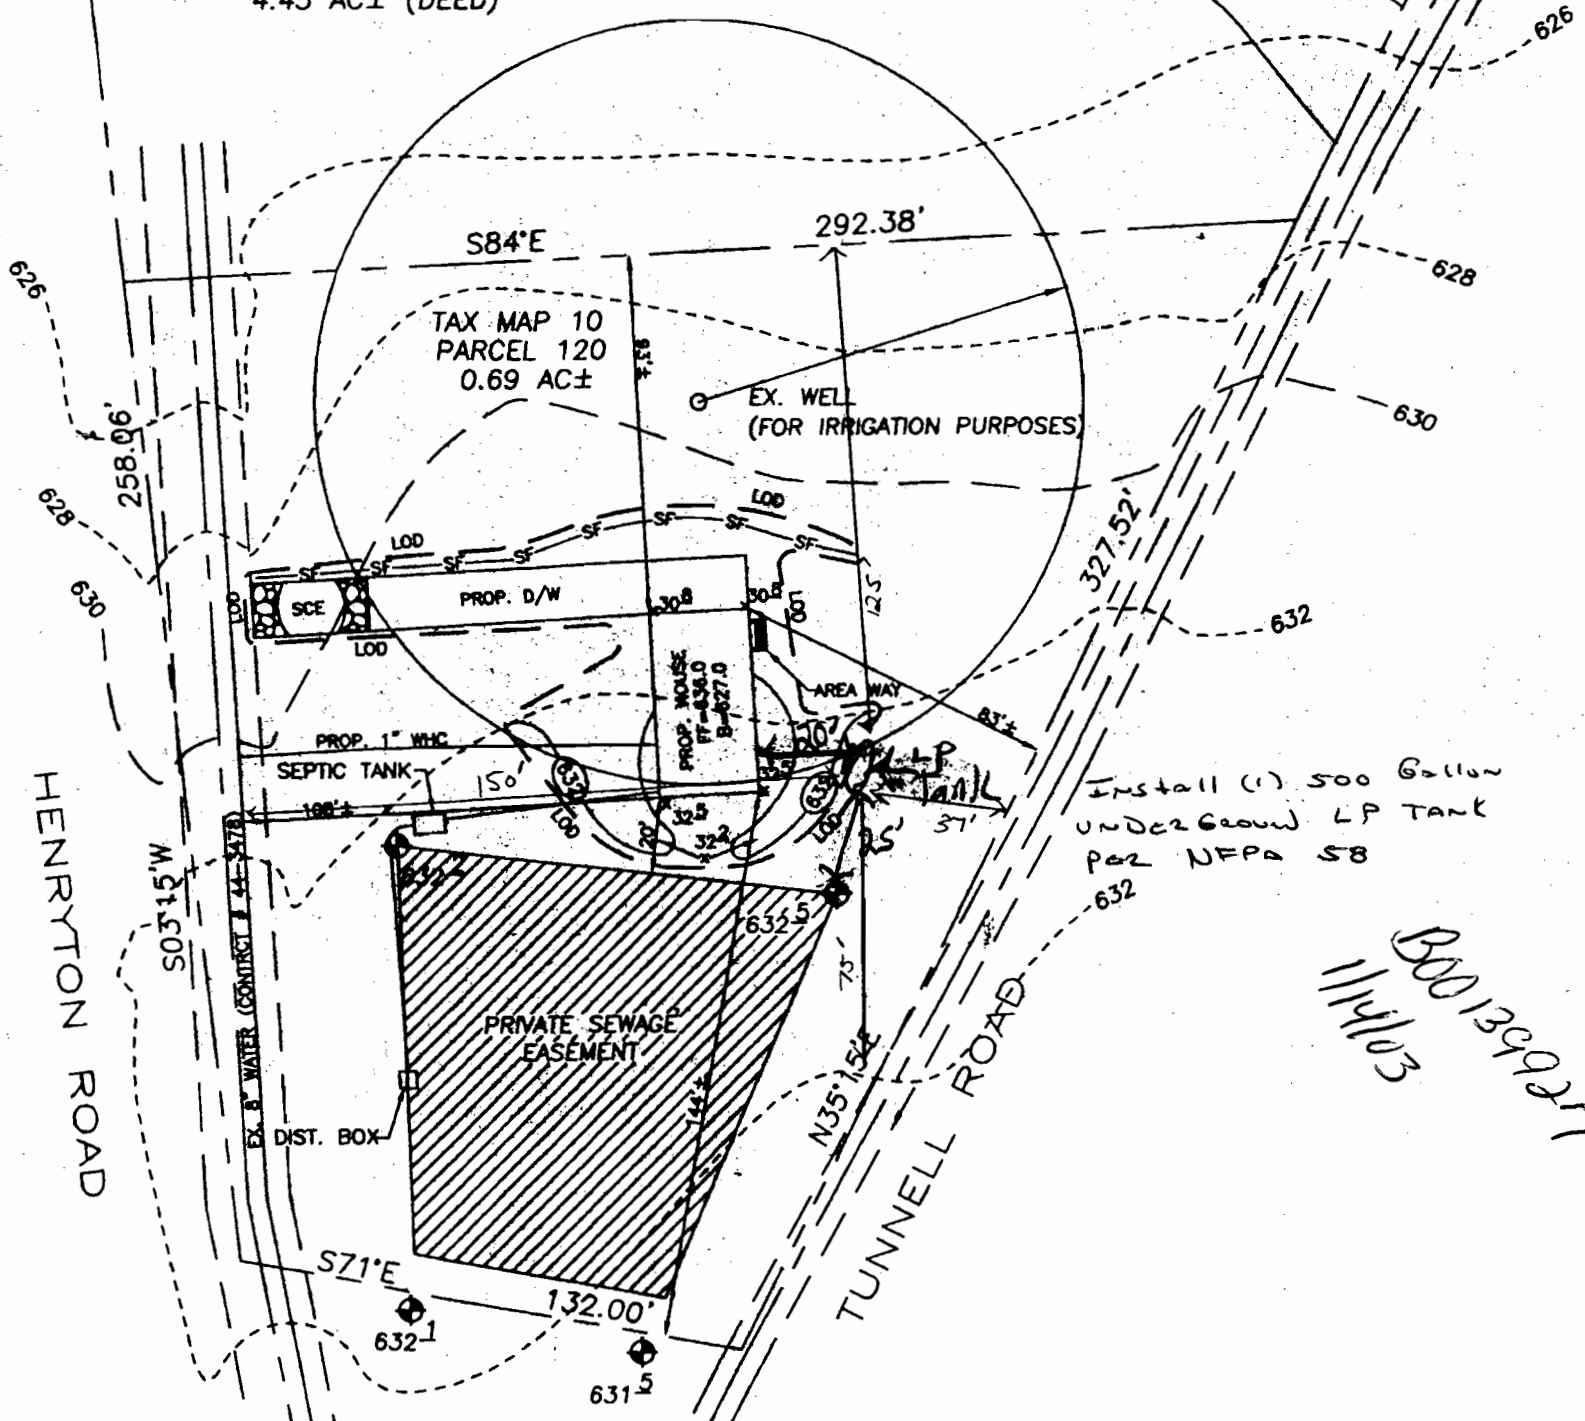

Install (1) 500 Gallon
UNDERGROUND LP TANK
PER NFPA 58

B00139927
11/4/03

HENRYTON ROAD

TUNNELL ROAD