

PUB. SEWER STATUS VERIFIED BY _____

ISSUE DATE: _____

APPROVAL DATE: _____

PERMIT INDEXED

P 520428-C

A RE-INDEX

ON-SITE SEWAGE DISPOSAL SYSTEM HOWARD COUNTY HEALTH DEPARTMENT BUREAU OF ENVIRONMENTAL HEALTH

IS PERMITTED TO INSTALL ALTER

ADDRESS: _____ PHONE NUMBER: _____

SUBDIVISION: Fox Haven LOT NUMBER: 16

ADDRESS: 14125 Clarksville Pike (Route 108) PROPERTY OWNER: McKillod

SEPTIC TANK CAPACITY (GALLONS): _____

PUMP CHAMBER CAPACITY (GALLONS): _____

NUMBER OF BEDROOMS: _____

SQUARE FEET PER BEDROOM: _____

LINEAR FEET OF TRENCH REQUIRED: _____

TRENCHES:	Trench to be _____ feet wide. Inlet _____ feet below original grade. Bottom maximum depth _____ feet below original grade. Effective area begins at _____ feet below original grade. _____ feet of stone below distribution pipe.
LOCATION:	
PURPOSE:	Reindex file 7/30/04

PLANS APPROVED: _____ DATE: _____

- NOTE: PERMIT VOID AFTER 2 YEARS
- NOTE: CONTRACTOR RESPONSIBLE FOR SCHEDULING A PRE-CONSTRUCTION INSPECTION FOR ALL INSTALLATIONS
- NOTE: WATERTIGHT SEPTIC TANKS REQUIRED
- NOTE: ALL PARTS OF SEPTIC SYSTEM SHALL BE 100 FEET FROM ANY WATER WELL
- NOTE: MANHOLE RISERS REQUIRED ON ALL SEPTIC TANKS AND PUMP CHAMBERS

**NEITHER THE HOWARD COUNTY COUNCIL OR THE HEALTH DEPARTMENT IS
RESPONSIBLE FOR THE SUCCESSFUL OPERATION OF ANY SYSTEM
PERMITTEE RESPONSIBLE FOR OBTAINING FINAL APPROVAL ON THIS PERMIT
CALL 410-313-2640 FOR INSPECTION OF SEPTIC SYSTEM**

P 520428-C

P520428-C

Approved (6-12)
8/4/78
P 28478

PERMIT

SEWAGE DISPOSAL SYSTEM

MARYLAND STATE DEPARTMENT OF HEALTH*

HOWARD COUNTY

ELLICOTT CITY

DISTRICT 5th

DATE 7/12/78

INDEXED

*7/17/78
Haver
Haver*

Paul Montgomery

IS PERMITTED TO INSTALL ALTER

ADDRESS 2878 Evergreen Court, Ellicott City, Md. 21043 PHONE 461-2518

SUBDIVISION (Fox Haven) ROAD 14125 Route 108 LOT 16

(Clarksville Pike)

PROPERTY OWNER same as above Paul Yoder

ADDRESS

SPECIFICATIONS 3 bedrooms

SEPTIC TANK CAPACITY 1000 GALLONS

DRAIN FIELD DEPTH FEET BOTTOM AREA SQ. FT.

DEEP TRENCH DEPTH FEET BOTTOM AREA SQ. FT.

SEEPAGE PITS ABSORBENT SIDE-WALL AREA 300 SQ. FT. total sidewall area in dry well.

INLET PIPE 3/4 FT BELOW ORIGINAL GRADE MAXIMUM DEPTH 10 1/4 FT. BELOW ORIGINAL GRADE

EFFECTIVE DEPTH AT FT BELOW ORIGINAL GRADE

LOCATE DISPOSAL AREA 180 FT FROM front LOT LINE AND 32 FT FROM right LOT LINE AS SEEN WHEN

FACING LOT FROM the right-of-way.

Trench to be 12 ft. long with an absorbent sidewall area of 81 sq. ft. (one side only). Inlet at 3/4 ft. and maximum depth 10 1/4 ft. below original grade. Start the trench after a 5 ft. earth buffer and run it on level ground the dis. acc required.

PLANS APPROVED BY Frank Skinner DATE 1/30/76

COVER NO WORK UNTIL INSPECTED AND APPROVED

NEITHER THE HOWARD COUNTY COUNCIL NOR THE HEALTH DEPARTMENT IS RESPONSIBLE FOR THE SUCCESSFUL OPERATION OF ANY SYSTEM

NOTE IF TRENCH IS USED CALL FOR INSPECTION BEFORE PLACING GRAVEL IN TRENCH

NOTE NO DRY WELL SHALL EXCEED 16 FOOT IN DIAMETER.

NOTE ALL PIPE FROM HOUSE TO DISPOSAL AREA MUST BE CAST IRON

PERMIT VOID AFTER THREE YEARS


NOTE INSTALL STAND PIPE ON SEPTIC TANK AND DRY WELL STAND PIPES MUST BE 6 INCHES IN DIAMETER. CAST IRON, CONCRETE OR TERRA COTTA ACCEPTED

*INSTALLER IS RESPONSIBLE FOR OBTAINING FINAL APPROVAL ON THIS PERMIT.

BLDG. PERMIT 300-233
AND RETURNED 10/10/78
Serial # 40007
Addition

21594

A 21594
lot 16

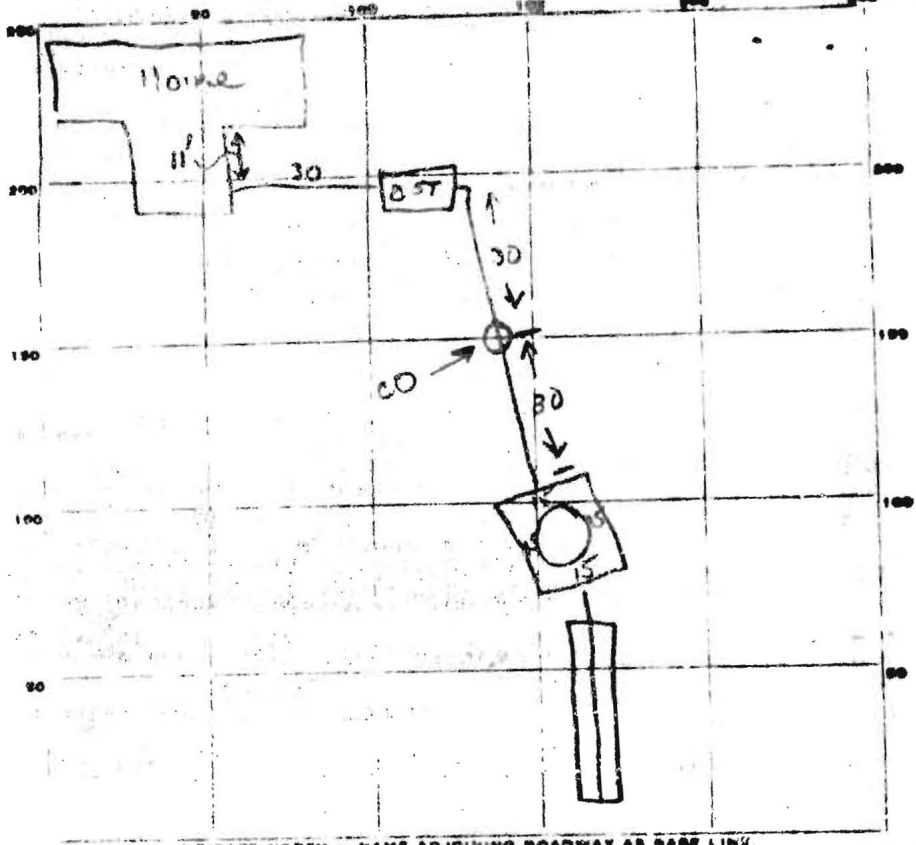

60
5.5
330
93

INDICATE NORTH - NAME ADJOINING ROADWAY AS BASE LINE.

PERMIT CARD

SEPTIC TANK LEVEL CLEANOUTS **CAST IRON**

DISTRIBUTION BOX LEVEL NG

TILE FIELD DEPTH 10 1/2 FT. TRENCH WIDTH 2 FT.

GRAVEL DEPTH 7 ft TOTAL LENGTH 15 FT.

NUMBER OF TRENCHES 1 TOTAL ABSORB AREA 105 **±105**

SEEPAGE PYS. INCHES-DIAMETER 60 FT. DEPTH BELOW INLET 5 1/2 FT. **±330**

ABSORBENT AREA 1435 SQ. FT.

REMARKS 3 Aug 78 - Inlet to DW at 5ft; Depth of DW is 12ft.
 (*Warning to get slope from tank) Warning about minimum depth.
 Call for final when gravel added to trench; DW, cleanouts
 installed & pipe inlet/outlet pipes in place. (GLK)
 4 Aug 78 Final OK (GLK)
 app'd - see first.

DATE SYSTEM APPROVED _____ INSPECTOR _____