

C 1 9290 PERMIT NO. (SEE REG. NO. 1) (THIS NUMBER IS TO BE PUNCHED IN TELL. NO. ON ALL CARDS)

STATE OF MARYLAND WATER RESOURCES ADMINISTRATION TAVES STATE OFFICE BLDG., ANNAPOLIS, MD. 21401 WELL COMPLETION REPORT

THIS REPORT MUST BE SUBMITTED WITHIN 10 DAYS AFTER WELL COMPLETION. FILL IN THIS FORM COMPLETELY. COUNTY NUMBER A 21594

DATE RECEIVED (WRA USE ONLY) DATE WELL COMPLETED 11-77

DEPTH OF WELL 30.5 (TO NEAREST FOOT) DRILLERS IDENTIFICATION NO. 1138

PERMIT NO. FROM "W" UNIT TO DRILL WELL: 40-73-2422

OWNER: [Handwritten Name] STREET OR RFD: [Handwritten Address] POST OFFICE: [Handwritten City]

WELL LOG

Table with columns: DESCRIPTION, FEET, CHECKED BY. Includes handwritten notes: 17-16-77, 55 casing, 1 battery, 46' open, 16' in cement, OR F.S.

GROUTING RECORD

WELL HAS BEEN GROUTED (CIRCLE APPROPRIATE BOX) YES [X] NO [] TYPE OF GROUTING MATERIAL (CIRCLE BOX) CEMENT [X] BENTONITE CLAY [] NO. OF BAGS 110 NO. OF POUNDS 1500

CASING RECORD

CASING TYPES: STEEL [X], CONCRETE [], PLASTIC [], OTHER [] MAIN CASING TYPE: [] NOMINAL DIAMETER: [] TOTAL DEPTH OF MAIN CASING: []

SCREEN RECORD

SCREEN TYPE: STEEL [X], WOOD OR SHOUKE [], OPEN HOLE [], PLASTIC [], OTHER []

DEPTH (NEAREST WHOLE FOOT)

Table for depth measurements from 1 to 51 feet.

DIAMETER OF SCREEN: [] IN NEAREST INCH

CRAYEL PACK: [] IF WELL DRILLED WAS A FLOWING WELL (CIRCLE BOX) [X]

WRA USE ONLY (NOT TO BE FILLED IN BY DRILLER) TELESCOPE CASING [] LOG INDICATOR [] OTHER DATA AVAILABLE []


PUMPING TEST

HOURS PUMPED (TO NEAREST HOUR) 2 PUMPING RATE (GALLONS PER MINUTE TO NEAREST GALLON) 4 WATER LEVEL (DISTANCE FROM LAND SURFACE) BEFORE PUMPING 55 (NEAREST FOOT) WHEN PUMPING 5 (NEAREST FOOT) TYPE OF PUMPED USED (CIRCLE APPROPRIATE BOX) CENTRIFUGAL [X]

PUMP INSTALLED

DRILLER WILL INSTALL PUMP (CIRCLE APPROPRIATE BOX) YES [X] NO [] CAPACITY: GALLONS PER MINUTE (TO NEAREST GALLON) PUMP HORSE POWER PUMP COLUMN LENGTH (NEAREST FOOT) CASING HEIGHT (CIRCLE APPROPRIATE BOX) ABOVE [X] BELOW [] LAND SURFACE (NEAREST FOOT)

LOCATION OF WELL ON LOT

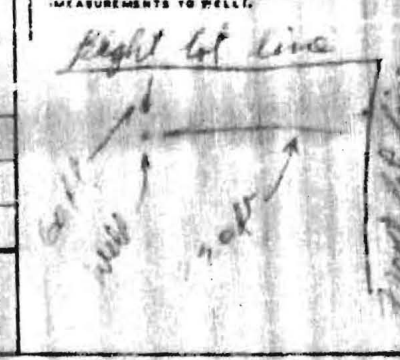

CIRCLE APPROPRIATE BOXES: A WELL WAS ABANDONED AND SEALED WHEN THIS WELL WAS COMPLETED [] SEPTIC LOG OBTAINED [] TEST WELL CONVERTED TO PRODUCTION WELL []