

*late this year*  
*10/29/79 - final*

SEWAGE DISPOSAL SYSTEM  
MARYLAND STATE DEPARTMENT OF HEALTH\*

HOWARD COUNTY

ELLCOTT CITY

DISTRICT 12

DATE 7/13/79

INDEXED

~~Jack Frank~~ Paul Schisler IS PERMITTED TO INSTALL  ALTER

ADDRESS Glensig, Md. PHONE \_\_\_\_\_

DIVISION (Fox Haven) ROAD 14095 Clarksville Pike LOT 13

PROPERTY OWNER Jan & Lisa McKillop

ADDRESS Box 41, Shady Spring, Md.

SPECIFICATIONS 4 bedrooms

SEPTIC TANK CAPACITY 1250 GALLONS

DRAIN FIELD \_\_\_\_\_ DEPTH \_\_\_\_\_ FEET. BOTTOM AREA \_\_\_\_\_ SQ. FT.

DEEP TRENCH \_\_\_\_\_ DEPTH \_\_\_\_\_ FEET. BOTTOM AREA \_\_\_\_\_ SQ. FT.

SEEPAGE PITS 8 ABSORBENT SIDE WALL AREA 145 SQ. FT. per bedroom in system.

INLET PIPE 4 1/2 FT. BELOW ORIGINAL GRADE. MAXIMUM DEPTH 11 FT. BELOW ORIGINAL GRADE

EFFECTIVE DEPTH AT \_\_\_\_\_ FT. BELOW ORIGINAL GRADE.

LOCATE DISPOSAL AREA 145 FT. FROM front LOT LINE AND 120 FT. FROM right LOT LINE AS SHOWN WHEN

FACING LOT FROM

Start the trench after a 5 ft. earth buffer and run it the necessary distance, on level ground, to make up for required sidewall area, as seen when facing the property from the right of way.

PLANS APPROVED BY Frank Skinner DATE 1/23/76

COVER NO WORK UNTIL INSPECTED AND APPROVED.

NEITHER THE HOWARD COUNTY COUNCIL NOR THE HEALTH DEPARTMENT IS RESPONSIBLE FOR THE SUCCESSFUL OPERATION OF ANY SYSTEM.

NOTE IF TRENCH IS USED CALL FOR INSPECTION BEFORE PLACING GRAVEL IN TRENCH.

NOTE NO DRY WELL SHALL EXCEED 16 FOOT IN DIAMETER

NOTE ALL PIPE FROM HOUSE TO DISPOSAL AREA MUST BE CAST IRON.


PERMIT VOID AFTER THREE YEARS.

NOTE INSTALL STAND PIPE ON SEPTIC TANK AND DRY WELL. STAND PIPES MUST BE 6 INCHES IN DIAMETER. CAST IRON, CONCRETE OR TERRA

COTTA ACCEPTED

\*INSTALLER IS RESPONSIBLE FOR OBTAINING FINAL APPROVAL ON THIS PERMIT.

A21591

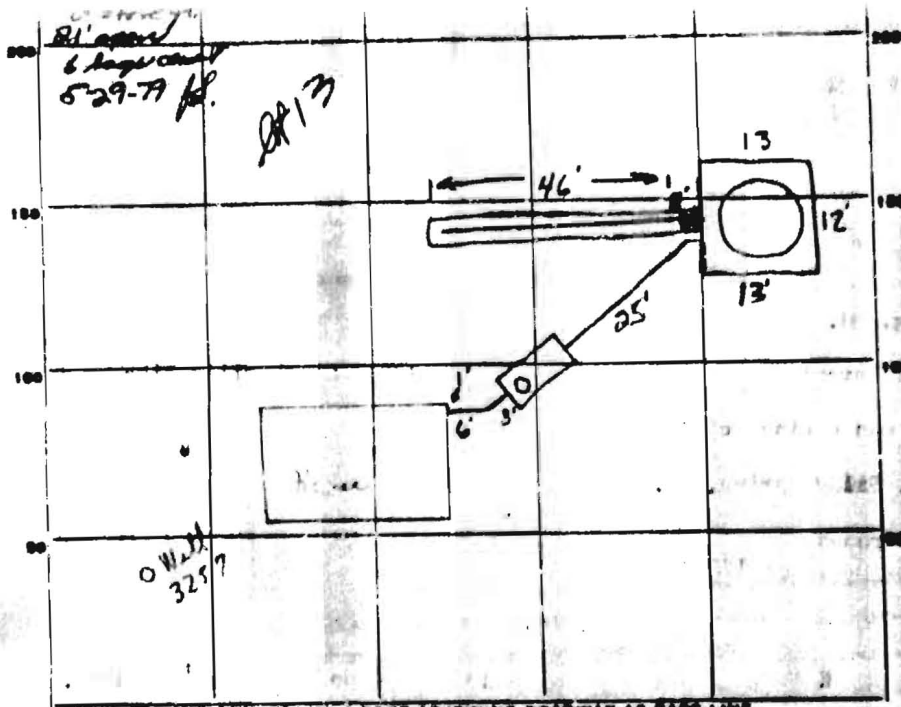

INDICATE NORTH - NAME ADJOINING ROADWAY AS BASE LINE.

PERMIT CARD  R/W ST DW  
 SEPTIC TANK, LEVEL  CLEANOUTS  CAST IRON  CAST IRON  
 DISTRIBUTION BOX, LEVEL N.A.  
 TILE FIELD, DEPTH 11 FT. TRENCH WIDTH 2 FT.  
 GRAVEL DEPTH 6 1/2 IN. TOTAL LENGTH 46 FT.  
 NUMBER OF TRENCHES 1 TOTAL BOTTOM AREA 299  
 STORAGE PITS, INSIDE DIAMETER 49 FT. DEPTH BELOW INLET 6 1/2 FT.  
 ABSORBENT AREA 617 SQ. FT.

REMARKS: 10/27 Not ready - no work done  
10/23/79 - OK TO COVER ALL WORK UP TO AND INCLUDING DRY WELL. OK TO ADD GRAVEL TO TRENCH 72.0 & JS  
10/29/79 OK to cover all work

DATE SYSTEM APPROVED 10/29/79 INSPECTOR [Signature]