

mon
2/2/01
10:00

APPLICATION

PERCOLATION TESTING

A 514908

HOWARD COUNTY HEALTH DEPARTMENT
BUREAU OF ENVIRONMENTAL HEALTH
3525-H ELLICOTT MILLS DRIVE/ELLICOTT CITY, MARYLAND 21043
TELEPHONE: 410-313-2640

Proposal - establish
septic reserve area
to serve ex. parcel
DISTRICT _____
DATE 1/29/2001

P _____

TO: THE COUNTY HEALTH OFFICER
ELLICOTT CITY, MARYLAND

I HEREBY APPLY FOR THE NECESSARY TEST PRIOR TO APPLICATION FOR PERMIT TO CONSTRUCT (OR RECONSTRUCT) A SEWAGE DISPOSAL SYSTEM.

PROPERTY OWNER Ralph Feaga

ADDRESS 1625 Henryton Road, Marriottsville, MD 21104 PHONE 410-442-5729

AGENT OR PROSPECTIVE BUYER Heritage Land Development

ADDRESS 3060 Washington Rd., Suite 220, Glenwood, MD 21738 PHONE 410-489-7900

PROPERTY LOCATION:

SUBDIVISION Feaga Property LOT NO. 1

ROAD AND DESCRIPTION 1625 Henryton Road, Marriottsville, MD 21104

TAX MAP NO. 10 PARCEL # 120

SIZE OF LOT .69 Acre TYPE OF BLDG. SFD
(SINGLE FAMILY DWELLING OR COMMERCIAL)

THE SYSTEM INSTALLED UNDER THIS APPLICATION IS ACCEPTABLE ONLY UNTIL PUBLIC FACILITIES BECOME AVAILABLE. I FULLY UNDERSTAND THE FEE CONNECTED WITH THE FILING OF THIS PERC TEST APPLICATION IS NON-REFUNDABLE UNDER ANY CIRCUMSTANCES. I ALSO AGREE TO COMPLY WITH ALL M.O.S.H.A. REQUIREMENTS IN TESTING THIS LOT.

Dennis R Feaga
(SIGNATURE OF APPLICANT)

APPROVED BY _____ FOR _____ DATE _____

DISAPPROVED BY _____ FOR _____ DATE _____

HOLD PENDING FURTHER TESTS _____

REASONS FOR REJECTION OR HOLDING _____

PERCOLATION TEST PLAT/PRELIMINARY PLAT - TITLE OR I.D. # _____ DATE _____

SITE DEVELOPMENT PLAN/FINAL PLAT - TITLE OR I.D. # _____ DATE _____

THIS IS NOT A PERMIT

COUNTY #


SOIL PROFILE

0' B/A


6' topsoil
 4.5' org brn cl lm
 14' red brn to tan si mica lm
 20% frag

13' 0' c
 6' topsoil
 4' org brn cl lm
 4' pale org tan si mica lm
 25-30% frag

12' D
 like (C)
 but 20-25% frag

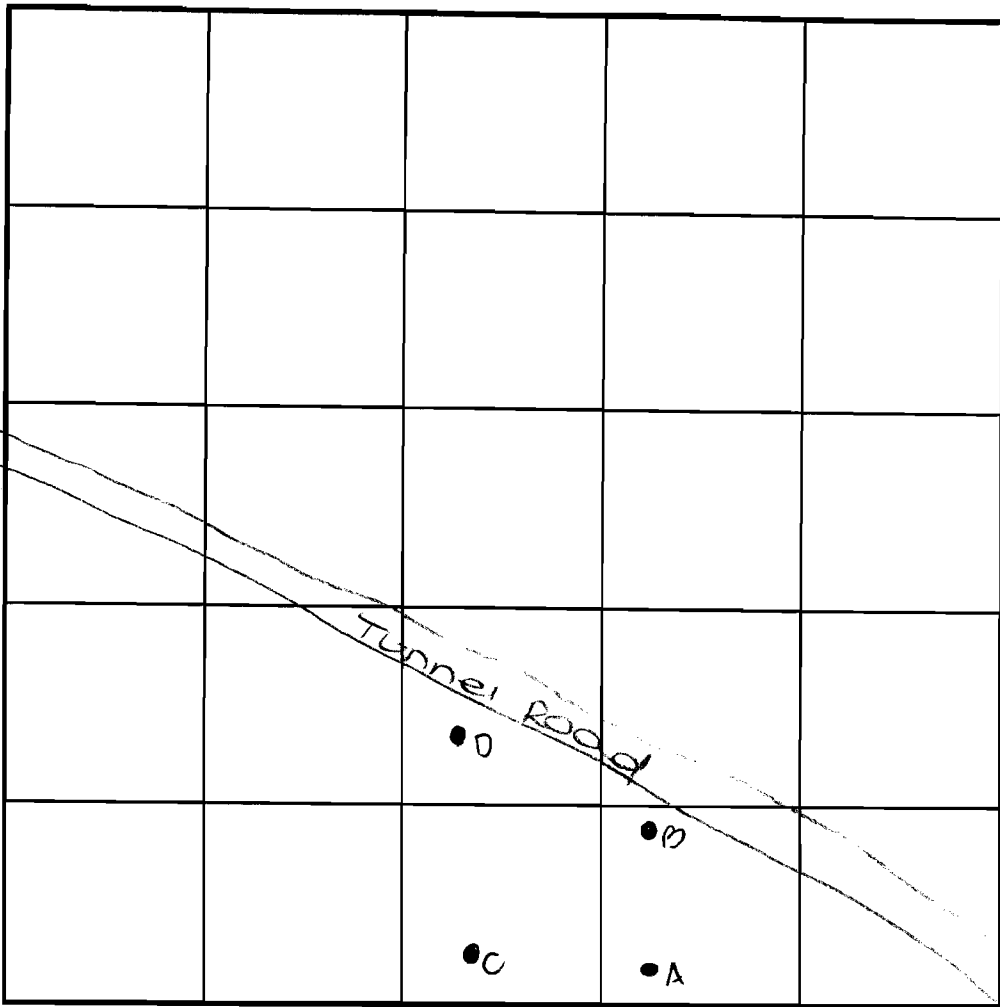

SOIL PROFILE

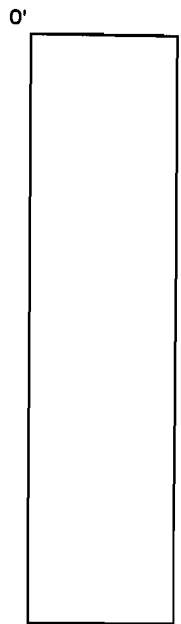

INDICATE NORTH - NAME ADJOINING ROADWAY AS BASE LINE.

Henryton Road

| DATE | TEST NO. | DEPTH | PRE-WET | | TEST - 1" DROP | | TIME |
|---------|----------|---------|---------|-------------|----------------|-------|------|
| | | | START | STOP | START | STOP | |
| 2-12-01 | B | 5.0' S | 10:34 | 10:57 | 10:57 | 11:01 | 4 |
| | | 13.0' D | visual | see profile | | | OK |
| | C | 4.0' S | 10:35 | 10:37 | 10:37 | 10:41 | 4 |
| | | 12.0' D | visual | see profile | | | OK |
| | D | 12.0' D | visual | see profile | | | OK |
| | A | 12.0' D | visual | see profile | | | OK |
| | | | | | | | |
| | | | | | | | |
| | | | | | | | |
| | | | | | | | |

REMARKS holes tested as staked

TYPE OF SOIL

TESTED BY

DVC

TRENCH DESIGN DATA: AVG. PERCOLATION TIME

4

INLET DEPTH

4.0

MAXIMUM BOTTOM DEPTH

6.0

ALSO PRESENT

T. Fagg, D. Fagg

TRENCH WIDTH

3

SQ. FT./BEDROOM

180