

6/29/04 pm

6/30/04 F/U 2:00 PM

7/1/04 - 2 PM

PUB. SEWER STATUS VERIFIED BY \_\_\_\_\_

ISSUE DATE: 6/17/04

APPROVAL DATE: 7/8/04

# PERMIT INDEXED

P 520426  
A UPGRADE

## ON-SITE SEWAGE DISPOSAL SYSTEM HOWARD COUNTY HEALTH DEPARTMENT BUREAU OF ENVIRONMENTAL HEALTH

Sams Excavating IS PERMITTED TO INSTALL  ALTER

ADDRESS: PO Box 0157, Fulton, MD 20759 PHONE NUMBER: 301-498-0145

SUBDIVISION: Mooresfield LOT NUMBER: 8

ADDRESS: 7526 Cherry Tree Drive PROPERTY OWNER: Roger Carter

SEPTIC TANK CAPACITY (GALLONS): 1500

PUMP CHAMBER CAPACITY (GALLONS): -

NUMBER OF BEDROOMS: 3

SQUARE FEET PER BEDROOM: \_\_\_\_\_

LINEAR FEET OF TRENCH REQUIRED: 150

$180 \times 3 = 540 - 3 = 180 \times - 149.9$

TRENCHES:	Trench to be <u>3</u> feet wide. Inlet <u>5 1/2</u> feet below original grade. Bottom maximum depth <u>6 1/2</u> feet below original grade. Effective area begins at <u>5 1/2</u> feet below original grade. <u>1</u> feet of stone below distribution pipe.
LOCATION:	
PURPOSE:	In support of B00148005. Call for inspection when ground is opened so sanitarian can recommend repair.

PLANS APPROVED: K. Bell DATE: 6/22/04


- NOTE: PERMIT VOID AFTER 2 YEARS
- NOTE: CONTRACTOR RESPONSIBLE FOR SCHEDULING A PRE-CONSTRUCTION INSPECTION FOR ALL INSTALLATIONS
- NOTE: WATERTIGHT SEPTIC TANKS REQUIRED
- NOTE: ALL PARTS OF SEPTIC SYSTEM SHALL BE 100 FEET FROM ANY WATER WELL
- NOTE: MANHOLE RISERS REQUIRED ON ALL SEPTIC TANKS AND PUMP CHAMBERS

NEITHER THE HOWARD COUNTY COUNCIL OR THE HEALTH DEPARTMENT IS RESPONSIBLE FOR THE SUCCESSFUL OPERATION OF ANY SYSTEM PERMITTEE RESPONSIBLE FOR OBTAINING FINAL APPROVAL ON THIS PERMIT

**BUILDING PERMIT SIGNED** 10-313-2640 FOR INSPECTION OF SEPTIC SYSTEM  
**AND RETURNED**

19-04-600148005 - bedroom Addition -

P520426

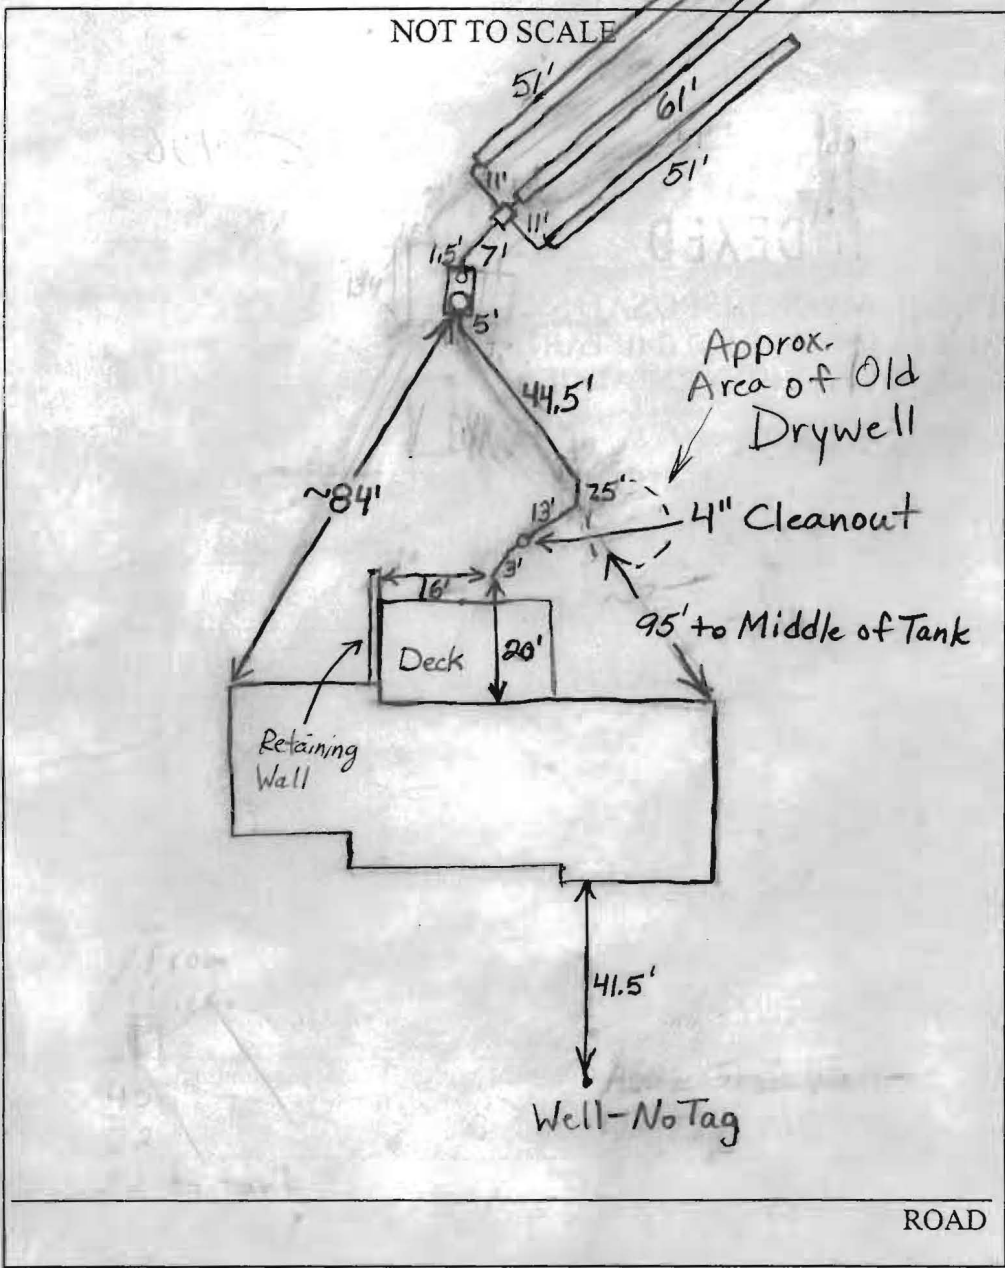

TRENCH/DRAINFIELD DATA		
WIDTH	INLET	BOTTOM
3'	4.5'-5'	6.5'-7.5'
NUMBER OF TRENCHES	3	
TOTAL LENGTH	163'	
ABSORPTION AREA	489 sq. ft. + Sidewall	
DISTRIBUTION BOX LEVEL	<input checked="" type="checkbox"/>	
DISTRIBUTION BOX BAFFLE	No	
DISTRIBUTION BOX PORT	Yes	

SEPTIC TANK DATA		
SEPTIC TANK 1 LEVEL		
2-Comp.	CAPACITY	1500 GAL
	SEAM LOC	Top
	TANK LID DEPTH	3'
	BAFFLES	Yes
	BAFFLE FILTER	No
	MANHOLE LOC	Front
	PORT LOC	Rear 8"
	WATERTIGHT TEST	No
SEPTIC TANK 2 LEVEL <del>N/A</del>		
	CAPACITY	<del>_____ GAL</del>
	SEAM LOC	<del>_____</del>
	TANK LID DEPTH	<del>_____</del>
	BAFFLES	<del>_____</del>
	BAFFLE FILTER	<del>_____</del>
	MANHOLE LOC	<del>_____</del>
	6" PORT LOC	<del>_____</del>
	WATERTIGHT TEST	<del>_____</del>

PRE-CONSTRUCTION \_\_\_\_\_


INSTALLATION 6/29/04 Tank set. Two trenches done (BB) 6/30/04  
 PVC pipe connected from cast iron line in front of deck to tank.  
 Distribution needs baffle. Need to install third trench and  
 pump out and fill in old tank and drywell. (BB) 7/1/04  
 System finished. O.K. to cover. Need to pump out and fill in  
 old drywell. Tank needs to be pumped out. Suggested filling  
 tank with concrete since tank located under concrete pool  
 walkway and top can't be crushed. (BB) 7/8/04 Drywell pumped

FINAL INSPECTOR B. Baker DATE OF APPROVAL 7/8/04  
 out and filled with dirt. Septic tank covered but contractor  
 said it was pumped out and he was able to push dirt into tank  
 through a hole he had made in the side of tank. (BB)

SITE INSPECTION SHEET

OWNER: Mr. + Mrs. Roger Carter PHONE #: 301-362-0168  
 ADDRESS: 7525 Cherry Tree Drive CONTRACTOR: \_\_\_\_\_  
Clarksville MD, 20759 WELL TAG #: - No tag -  
 SUBDIVISION: Moorestfield LOT: 8 COUNTY #: Howard  
 PROPOSAL: addition to a master bedroom, sunroom, & deck

LOCATION DIAGRAM

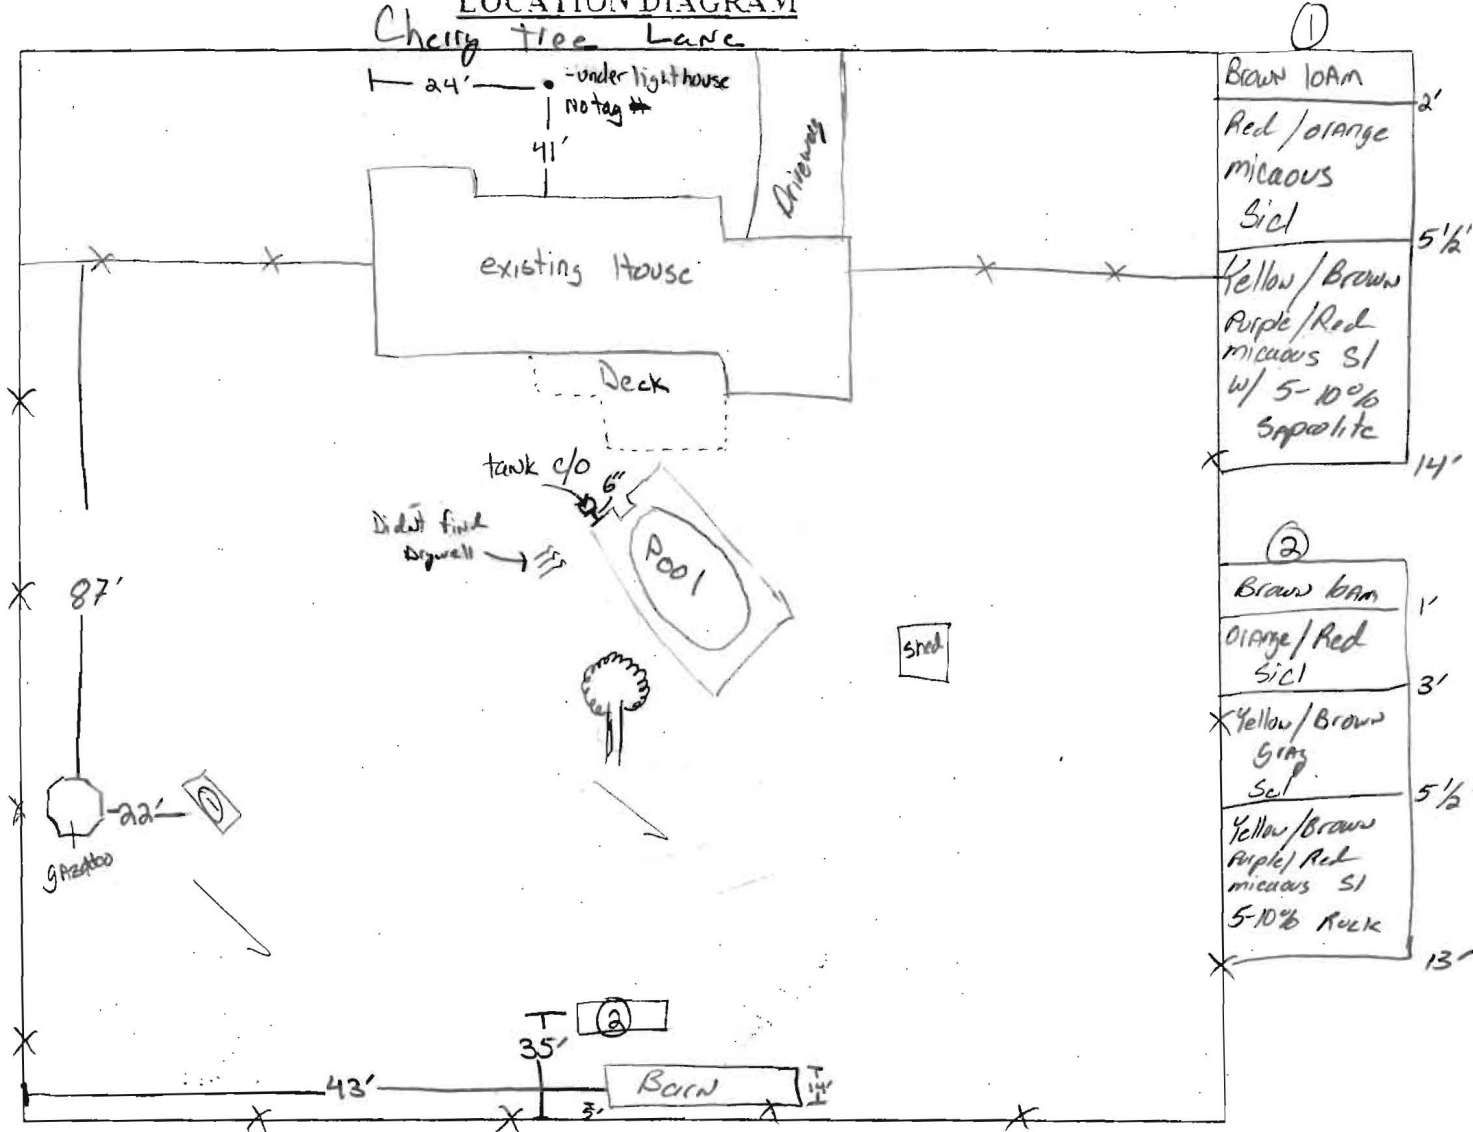


COMMENTS: Tried to find the dipwell & didn't. Told homeowner that they would have to upgrade their system. Pump & Collapse both tank & dipwell & found area for one system & repair. Both perc test holes pass - visual -

DATE: 6/2/04 INSPECTOR: K. Bell

N 28°23'20" E  
125.00

5' UTILITY  
EASEMENT

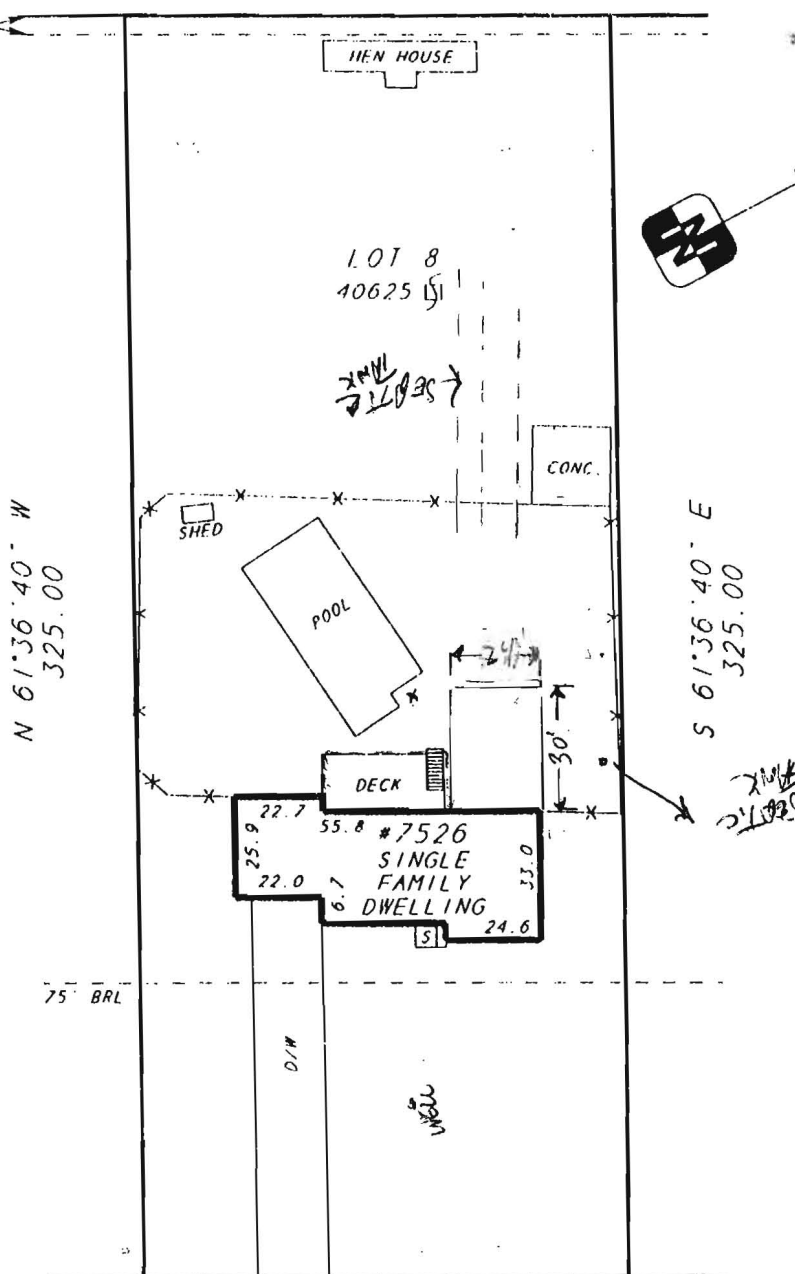

S 28°23'20" W  
125.00

## CHERRYTREE DRIVE

**LOCATION SURVEY OF:**  
**#7526 CHERRYTREE DRIVE**  
 LOT 8 BLOCK A  
 PLAT ONE  
**MORRESFIELD**  
 5TH ELECTION DISTRICT  
 PLAT BOOK 9 PAGE 5  
 HOWARD COUNTY, MD  
 SCALE: 1"=50' DATE: 8-13-01

A LAND SURVEYING AND DESIGN COMPANY



**DULEY  
AND  
ASSOCIATES, INC.**  
 SERVING D.C., MD., VA.



HOUSE LOCATION SURVEYS  
 BOUNDARY SURVEYS - ALTA SURVEYS  
 TOPOGRAPHIC SURVEYS - SITE PLANS

9450 PENNSYLVANIA AVE.  
 UPPER MARLBORO, MD. 20772

PHONE: 301-888-1111  
 PHONE: 1-888-88-DULEY

FAX: 301-888-1114  
 FAX: 1-888-55-DULEY



CASE # 1010584  
 FILE # 014442-127  
 DRAWN BY: B.G.

### SURVEYOR'S CERTIFICATE

I HEREBY STATE THAT THE EXISTING VISIBLE IMPROVEMENTS ON THE ABOVE DESCRIBED PROPERTY HAS BEEN CAREFULLY ESTABLISHED BY ACCEPTED METHODS AND THAT THE IMPROVEMENTS APPEAR TO LIE WITHIN FLOOD ZONE C. FLOOD CERTIFICATION IS RECOMMENDED TO DETERMINE THE EXACT FLOOD ELEVATION AND FLOOD ZONE. THIS SURVEY IS NOT TO BE USED OR RELIED UPON FOR THE ESTABLISHMENT OF ANY FENCE, BUILDING, OR OTHER IMPROVEMENTS. THIS PLAT DOES NOT PROVIDE FOR THE ACCURATE IDENTIFICATION OF PROPERTY BOUNDARY LINES, BUT SUCH IDENTIFICATION MAY NOT BE REQUIRED FOR THE TRANSFER OF TITLE OR SECURING FINANCING OR REFINANCING. THIS PLAT IS OF BENEFIT TO A CONSUMER ONLY INsofar AS IT IS REQUIRED BY A LENDER OR A TITLE INSURANCE COMPANY OR ITS AGENT IN CONNECTION WITH THE CONTEMPLATED TRANSFER, FINANCING OR REFINANCING THE LEVEL OF ACCURACY FOR THIS DRAWING IS 1". NO TITLE REPORT WAS FURNISHED TO NOR DONE BY THIS COMPANY. SAID PROPERTY SUBJECT TO ALL NOTES, RESTRICTIONS AND EASEMENTS OF RECORD, BUILDING RESTRICTION LINES AND EASEMENTS MAY NOT BE SHOWN ON THIS SURVEY. IMPROVEMENTS WHICH IN THE SURVEYORS OPINION APPEAR TO BE IN A STATE OF DISREPAIR OR MAY BE CONSIDERED "TEMPORARY" MAY NOT BE SHOWN.