

7/29/64

PERMIT

P 08796

A 08145

SEWAGE DISPOSAL SYSTEM

MARYLAND STATE DEPARTMENT OF HEALTH

HOWARD COUNTY

INDEXED

ELLICOTT CITY

DISTRICT 5

DATE 7/23/64

*Incomplete
7/30/64*

*installed
not not
approved due to
cleanout being needed
on Septic Tank*

Hy-Low Septic Service IS PERMITTED TO INSTALL ALTER

ADDRESS Damascus, Maryland PHONE _____

A SEWAGE DISPOSAL SYSTEM LOCATED AT _____

SUBDIVISION Moorefield ROAD Cherry Tree Drive LOT 8 - A

PROPERTY OWNER McHenry Co.

ADDRESS _____

SPECIFICATIONS 3 bedrooms

DRAIN FIELD _____ DEPTH _____ FEET, BOTTOM AREA _____ SQ. FT.

SEEPAGE PITS _____ ABSORBENT SIDE-WALL AREA _____ SQ. FT.

SEPTIC TANK CAPACITY 750 GALLONS

FOR GARBAGE GRINDER, INCREASE DISPOSAL AREA 22% & TANK CAPACITY 50%.


OTHER Dry well - 300 sq. ft. absorbent side wall area below inlet pipe.
Locate dry well 129' from back lot line and 54' from left side line
as lot is seen facing from Cherry Tree Drive.

PLANS APPROVED BY Ronald Fletcher DATE 3/17/64

FILL SEPTIC TANK AND DISTRIBUTION BOX WITH WATER BEFORE CALLING FOR AN INSPECTION. COVER NO WORK UNTIL INSPECTED AND APPROVED.

NEITHER THE HOWARD COUNTY COMMISSIONERS NOR THE HEALTH DEPARTMENT IS RESPONSIBLE FOR THE SUCCESSFUL OPERATION OF ANY SYSTEM.

A 0145

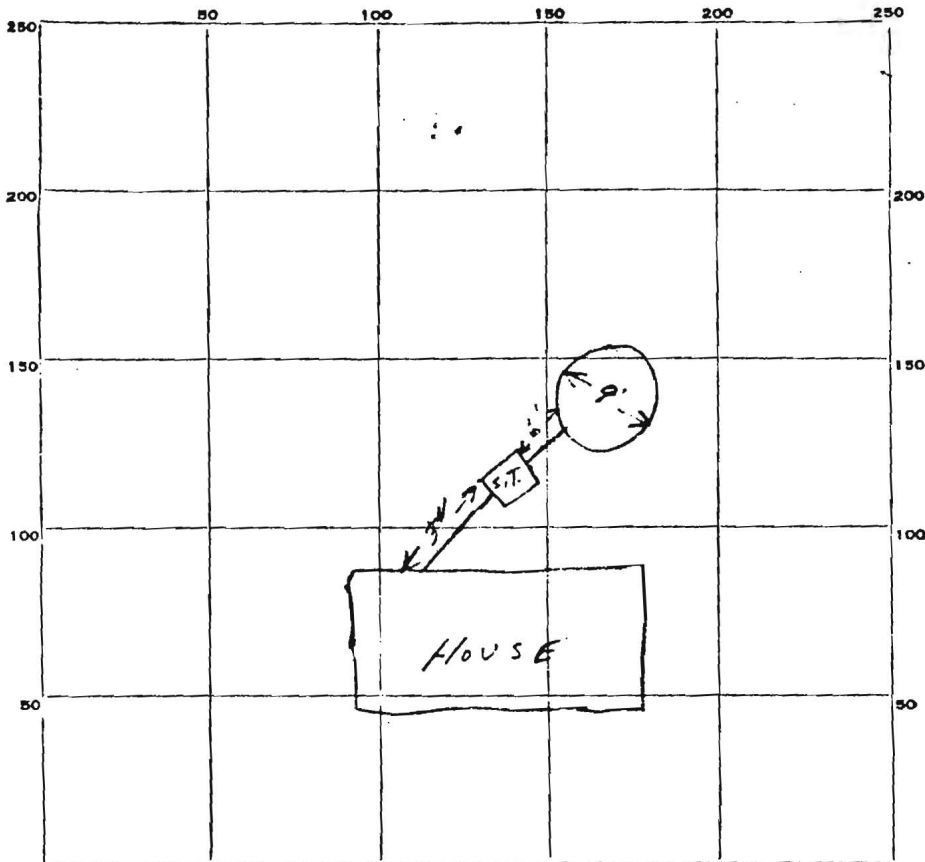

INDICATE NORTH. - NAME ADJOINING ROADWAY AS BASE LINE.

CHERRY TREE DRIVE

PERMIT CARD OK

SEPTIC TANK, LEVEL OK

CLEANOUTS J.K.

DISTRIBUTION BOX, LEVEL _____

TILE FIELD, DEPTH _____ FT. TRENCH WIDTH _____ FT.

GRAVEL DEPTH _____ IN. TOTAL LENGTH _____ FT.

NUMBER OF TRENCHES _____ TOTAL BOTTOM AREA _____

SEEPAGE PITS, INSIDE DIAMETER 9' FT. DEPTH BELOW INLET 11 FT.

ABSORBENT AREA 310 SQ. FT.

REMARKS 7/29/64 System needs an 8" clean out pipe installed on septic tank

DATE SYSTEM APPROVED _____ INSPECTOR _____