

# APPLICATION

A 08145

P \_\_\_\_\_

SEWAGE DISPOSAL TESTING

MARYLAND STATE DEPARTMENT OF HEALTH

HOWARD COUNTY

ELLICOTT CITY

Septic tank - 450 gal.

DISTRICT 5

Drywell - 300 sq ft. also bent sidewall area below inlet pipe

DATE 3/11/64

Locate drywell 129' from back lot line and 54' from left side line as lot is seen facing from Cherry Tree Drive.

TO: THE COUNTY HEALTH OFFICER  
ELLICOTT CITY, MARYLAND

I, HEREBY, APPLY FOR THE NECESSARY TESTS IN ORDER TO CONSTRUCT (OR RECONSTRUCT) A SEWAGE DISPOSAL SYSTEM.

PROPERTY OWNER McHenry Co.

ADDRESS Clarksville, Maryland PHONE \_\_\_\_\_

PROPERTY LOCATION:

SUBDIVISION Mooresfield LOT NO. 6 A

ROAD AND DESCRIPTION Cherry Tree Drive

OCCUPANT \_\_\_\_\_ PHONE \_\_\_\_\_

PERSON TO CONSTRUCT SYSTEM \_\_\_\_\_

ADDRESS \_\_\_\_\_ PHONE \_\_\_\_\_

SIZE OF LOT 1 acre TYPE BLDG. 3  
NUMBER OF BEDROOMS

IF NOT SINGLE RESIDENCE DESCRIBE \_\_\_\_\_

SIGNATURE OF APPLICANT David Scagg


APPROVED BY [Signature] FOR [Signature] DATE 3/11/64  
(KIND OF SYSTEM)

REJECTED BY \_\_\_\_\_ FOR \_\_\_\_\_ DATE \_\_\_\_\_  
(KIND OF SYSTEM)

HOLD PENDING FURTHER TESTS \_\_\_\_\_ DATE \_\_\_\_\_

REASONS FOR REJECTION OR HOLDING \_\_\_\_\_

## THIS IS NOT A PERMIT

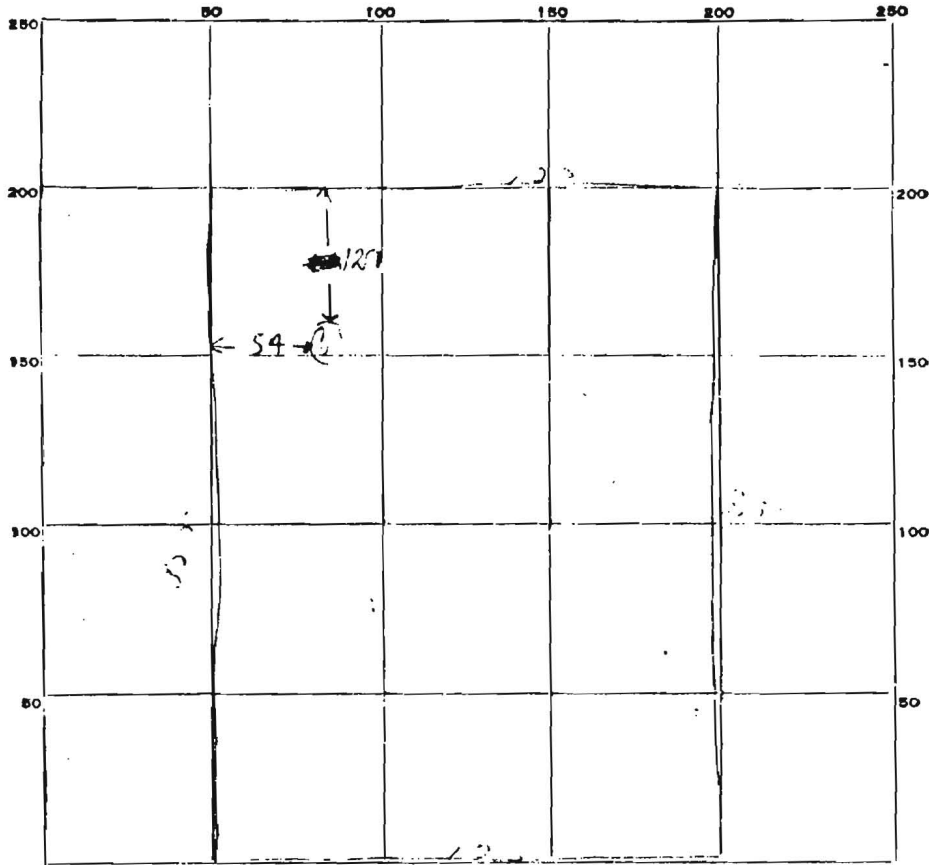

INDICATE NORTH. - NAME ADJOINING ROADWAY AS BASE LINE.

*Clayton Drive*

DATE	TEST NO.	DEPTH	PRE-WET		TEST - 1" DROP		TIME
			START	STOP	START	STOP	
3/17/64	1	9 ft	<del>1050</del> 958	1000	1000 ⊕	1004	4 min.
	2	4 ft	<del>1050</del> 959	1000	1000	1004	4 min

SOIL AUGER FINDING \_\_\_\_\_

TESTED BY R.B.F DUM 3/17/64

REMARKS \_\_\_\_\_

ALSO PRESENT D. J. Stone

LOT NO. 111