

Final LAYOUT 1/8/03 1100 AM INSP 4 _____
 INSP 2 1/9/03 2pm 050 INSP 5 _____
 INSP 3 1/10/03 11am INSP 6 _____

RPS# 284824

ISSUE DATE: 12/10/2002

P 518020

APPROVAL DATE: 1/10/03

A 514908

PERMIT INDEXED

**ON-SITE SEWAGE DISPOSAL SYSTEM
 HOWARD COUNTY HEALTH DEPARTMENT
 BUREAU OF ENVIRONMENTAL HEALTH**

J E Feaga & Son Excavating IS PERMITTED TO INSTALL ALTER

ADDRESS: 1625 Henryton Rd, Marriottsville PHONE NUMBER: 410-442-5623

SUBDIVISION: _____ LOT NUMBER: _____

ADDRESS: 1615 Henryton Road PROPERTY OWNER: Ralph Feaga

SEPTIC TANK CAPACITY (GALLONS): 1000 OUTLET BAFFLE FILTER REQUIRED

PUMP CHAMBER CAPACITY (GALLONS): N/A COMPARTMENTED TANK REQUIRED

NUMBER OF BEDROOMS: 3

SQUARE FEET PER BEDROOM: 180

LINEAR FEET OF TRENCH REQUIRED: 180 HOUSE SERVED BY PUBLIC WATER

TRENCHES:	Trench to be 3.0 feet wide. Inlet 4.0 feet below original grade. Bottom maximum depth 6.0 feet below original grade. Effective area begins at 4.0 feet below original grade. 2.0 feet of stone below distribution pipe.
LOCATION:	Place the distribution box as shown on the approved site plan. Run trenches on contour. If better location of distribution box exists, its location to be determined in field at time of layout inspection.
NOTES:	Maintain 10' from public water line to septic house connection, septic tank and all parts of septic system.

PLANS APPROVED: Steven R. Krieg OK SRK 12/10/02 DATE: 9/30/2002

NOTES: PERMIT VOID AFTER 2 YEARS
 CONTRACTOR IS RESPONSIBLE FOR SCHEDULING A PRE-CONSTRUCTION INSPECTION FOR ALL INSTALLATIONS
 WATERTIGHT SEPTIC TANKS REQUIRED
 ALL PARTS OF SEPTIC SYSTEM SHALL BE 100 FEET FROM ANY WATER WELL UNLESS SPECIFICALLY AUTHORIZED
 MANHOLE RISERS REQUIRED ON ALL SEPTIC TANKS AND PUMP CHAMBERS UNLESS SPECIFICALLY AUTHORIZED
 CONTRACTOR RESPONSIBLE FOR COMPLIANCE WITH APPLICABLE REGULATIONS, GUIDELINES AND THE TERMS OF THIS PERMIT


NEITHER THE HOWARD COUNTY COUNCIL NOR THE HEALTH DEPARTMENT IS RESPONSIBLE FOR THE SUCCESSFUL OPERATION OF ANY SYSTEM PERMITTEE RESPONSIBLE FOR OBTAINING FINAL APPROVAL ON THIS PERMIT

BUILDING PERMIT SIGNED AND RETURNED

1-14-03-800139927-46 LP TANK

A514908

NOT TO SCALE

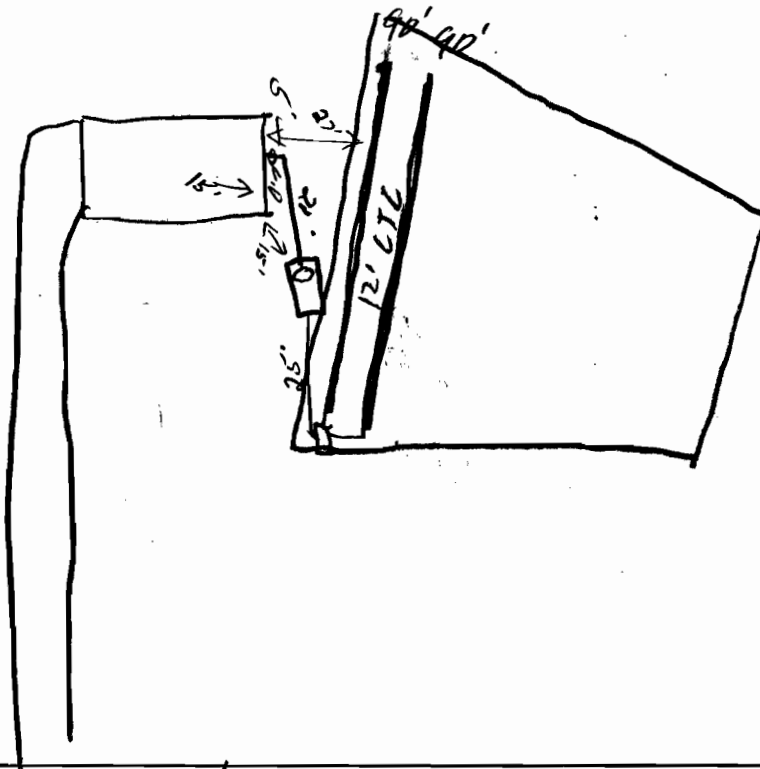

Henry ton

ROAD

TRENCH/DRAINFIELD DATA		
WIDTH	INLET	BOTTOM
3'	4'	6'
NUMBER OF TRENCHES		2
TOTAL LENGTH		180'
ABSORPTION AREA		540 #
DISTRIBUTION BOX LEVEL		✓
DISTRIBUTION BOX BAFFLE		✓
DISTRIBUTION BOX PORT		—

SEPTIC TANK DATA	
SEPTIC TANK 1 LEVEL	
CAPACITY	1000 GAL
SEAM LOC	Top
TANK LID DEPTH	2'
BAFFLES	✓
BAFFLE FILTER	—
MANHOLE LOC	Front
6" PORT LOC	—
WATERTIGHT TEST	—
SEPTIC TANK 2 LEVEL	
CAPACITY	_____ GAL
SEAM LOC	_____
TANK LID DEPTH	_____
BAFFLES	MA
BAFFLE FILTER	_____
MANHOLE LOC	_____
6" PORT LOC	_____
WATERTIGHT TEST	_____

PRE-CONSTRUCTION 1/8/03 Lot staked, house corr changed, OK to place D.B. in corner of SRA & run (2) 90' trenches

INSTALLATION 1/9/03 Tank set (SO)


1/10/03 OK to cover all work (SO)

AND RETURNED
REPRODUCED RIGHTS

FINAL INSPECTOR

DATE OF APPROVAL

1/10/03

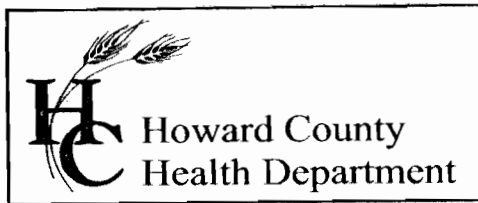

3525 H Ellicott Mills Drive, Ellicott City, MD 21043
(410) 313-2640 Fax (410) 313-2648
TDD (410) 313-2323 Toll Free 1-866-313-6300
website: www.hchealth.org

Penny E. Borenstein, M.D., M.P.H., Health Officer

January 16, 2003

Ralph Feaga
1615 Henryton Road
Marriottsville, MD 21104

RE: 1615 Henryton Road
BP# B00138553
**Public Water, Private Sewerage
W/Residential Non-Potable Irrigation Well**

Dear Mr. Feaga:

This is to advise you that the septic system for the above referenced property has been installed and inspected. **Final approval of the septic system was granted on January 10, 2003.**

The property is served by public water and is therefore exempt from the Health Department water sampling requirements; however, a well designated for residential non-potable irrigation exists on the property, which is not and will not be connected to the dwelling.

If you have any further questions, please call me directly at (410) 313-1771. **By issuance of this letter, this office recommends release of the Use and Occupancy permit for the referenced property.**


Approving Authority

Steven R. Krieg,
Registered Environmental Sanitarian
Well & Septic Program

SN
cc: Building Inspector's Office
File

TAX MAP 10
 PARCEL 121
 4.45 AC± (DEED)

Maryland State

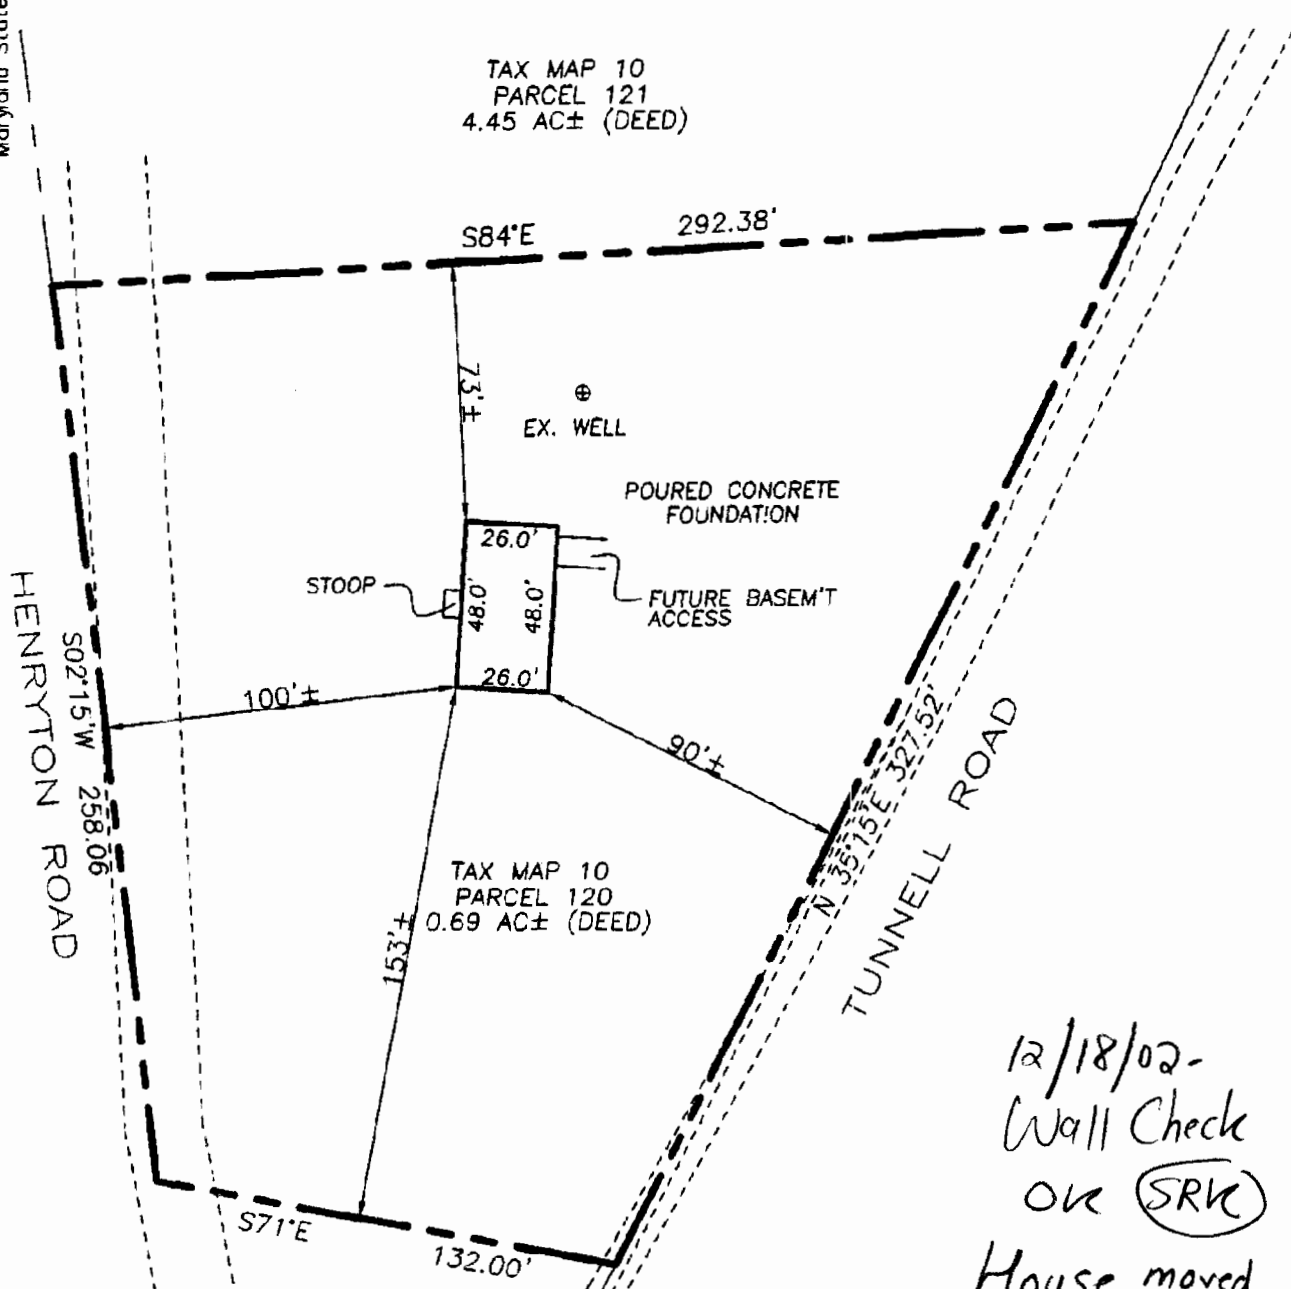

TAX MAP 10
 PARCEL 120
 0.69 AC± (DEED)

12/18/02 -
 Wall Check
 OK (SRV)
 House moved
 closer to well
 but still is
 35'±

I HEREBY CERTIFY TO THE BEST OF MY KNOWLEDGE,
 INFORMATION AND BELIEF THAT THE IMPROVEMENTS ARE
 LOCATED AS SHOWN AND THERE ARE NO ENCROACHMENTS
 EXCEPT AS SHOWN.




James R. Meeks


12/18/02

DEED ERROR OF CLOSURE:
 N 77°45'53"W 13.2287'

JAMES ROBERT MECKS, PROFESSIONAL LAND SURVEYOR #10857 DATE

FINISHED FIRST FLOOR ELEV.= 635.83'

PLAT No.	DATE 12/18/02	 FREDERICK WARD ASSOCIATES, INC. ENGINEERS ARCHITECTS SURVEYORS 7125 Riverwood Drive Columbia, Maryland 21046-2354 Phone: 410-290-9550 Fax: 410-720-6226 Bel Air, Maryland Warrenton, Virginia	WALL CHECK FEAGA PROPERTY 1615 HENERYTON ROAD LIBER 4870, FOLIO 484 T.M. 10, GRID 14, PAR. 120 3RD ELECTION DISTRICT HOWARD COUNTY, MARYLAND
DR. BY BDA	CH. BY JRM		
SCALE: 1"=50'	JOB NO. 2014038		

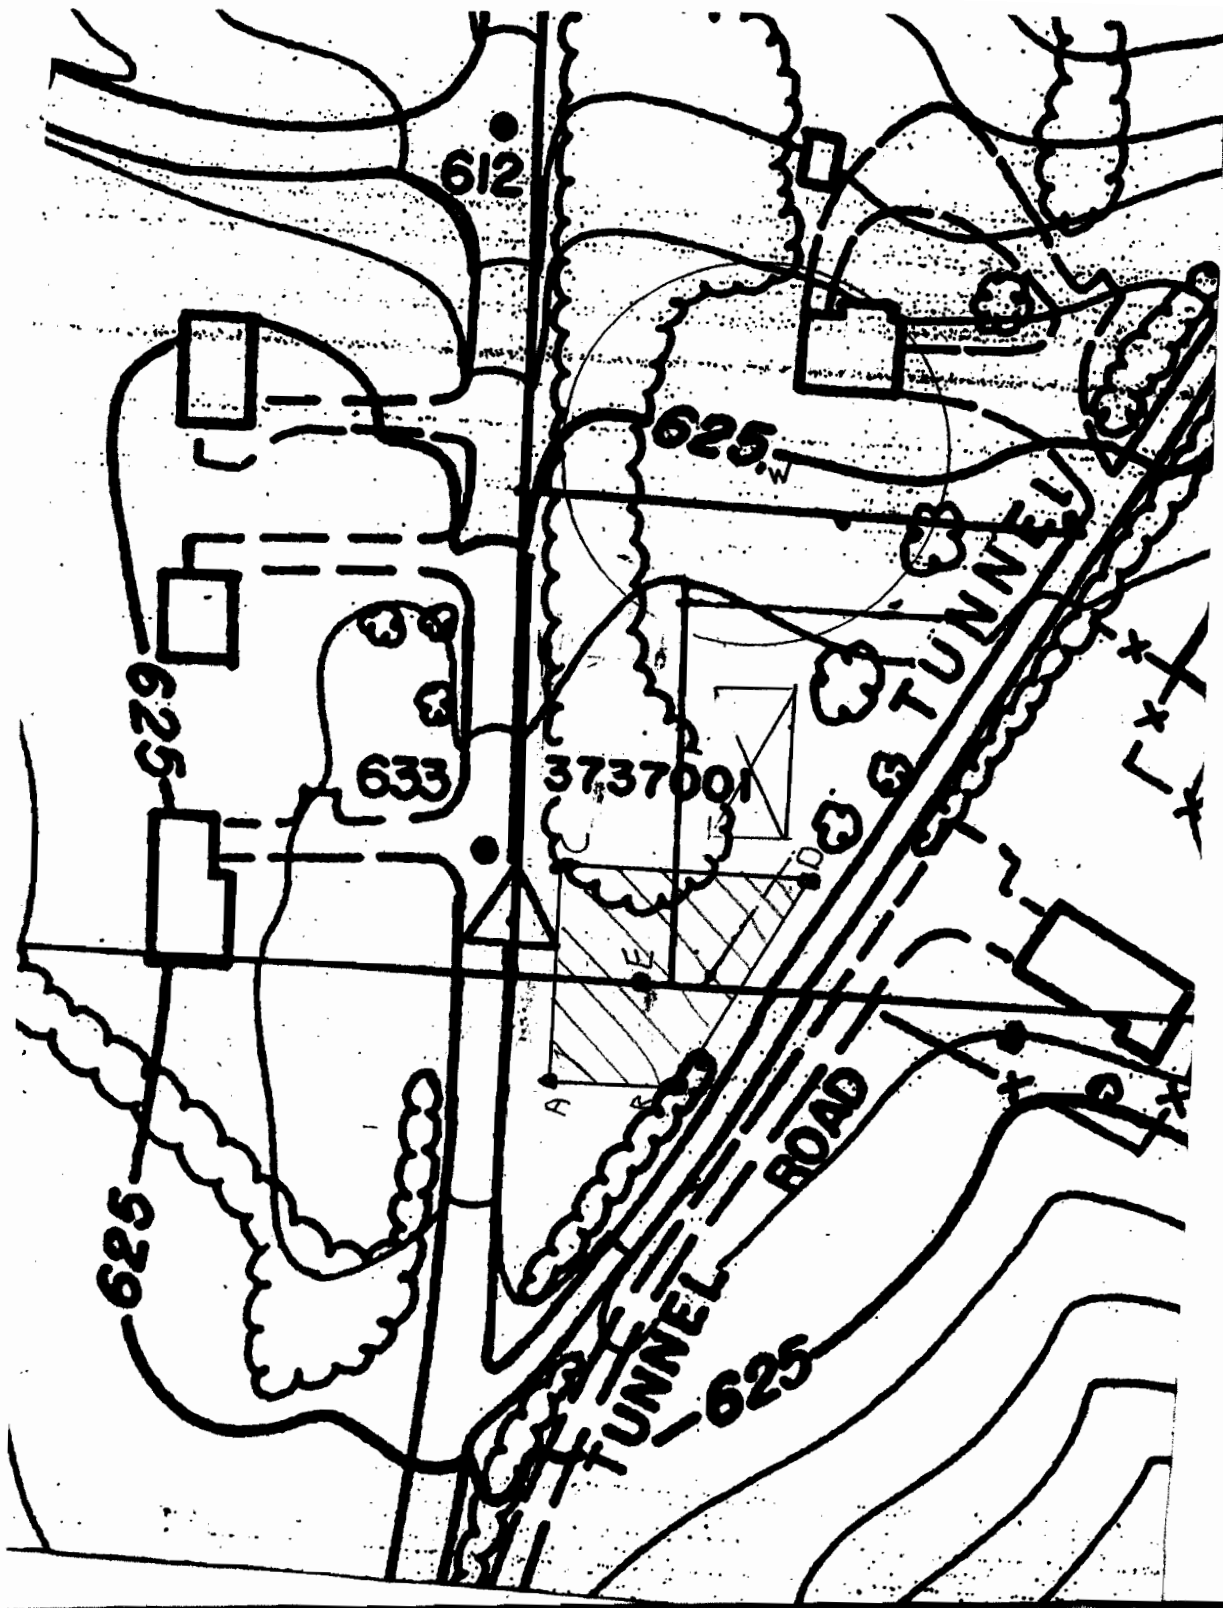

Ralph Feaga Property
1625 Henryton Road
Marriottsville, MD 21104
Tax Map 10, Parcels 120 and 121