


Harold Ball
 1516 Round Gate Ct.
 Woodbine MD 21797

OLD FREDERICK RD
 $R=1040.00'$ $A=120.00'$

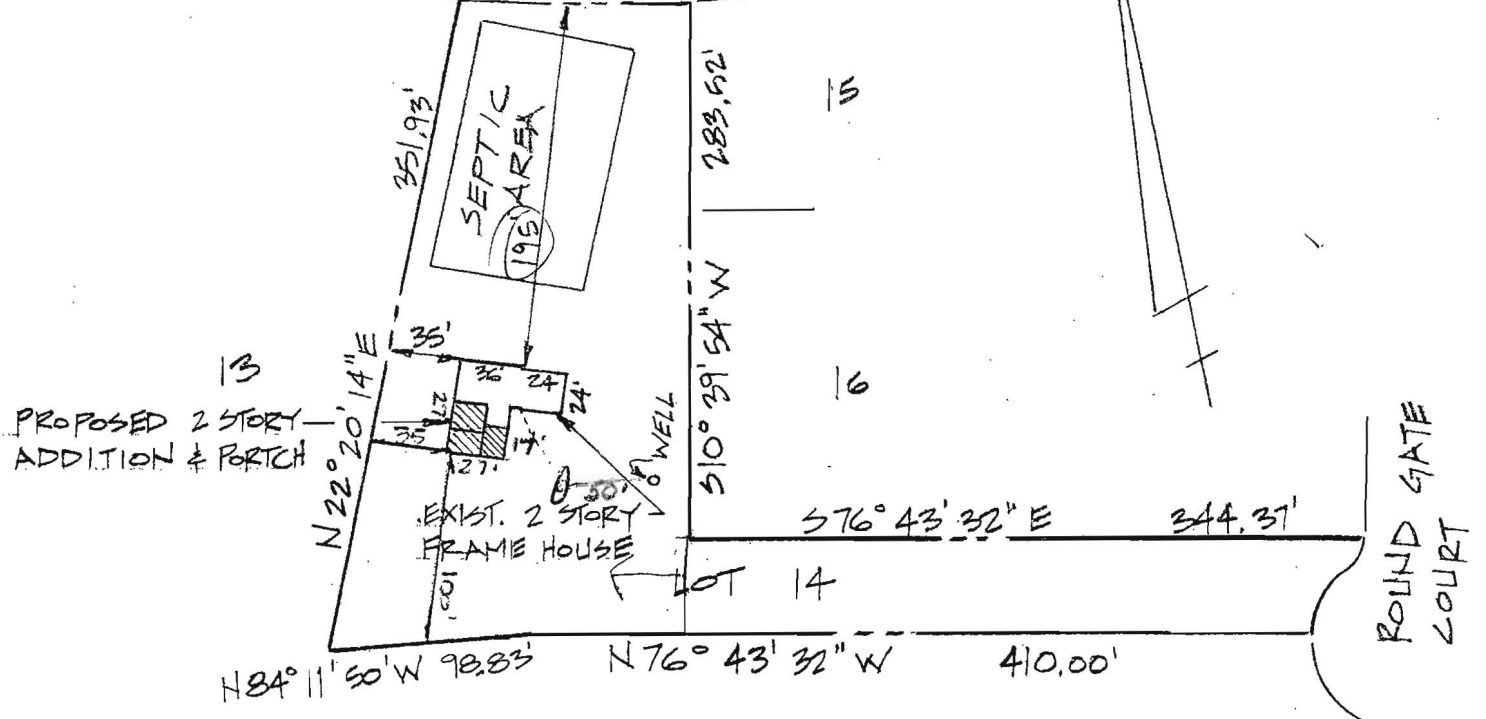


PLOT PLAN

1"=100'


9/29/04 BOV150443
 Prepare tank location ok

(KJB)

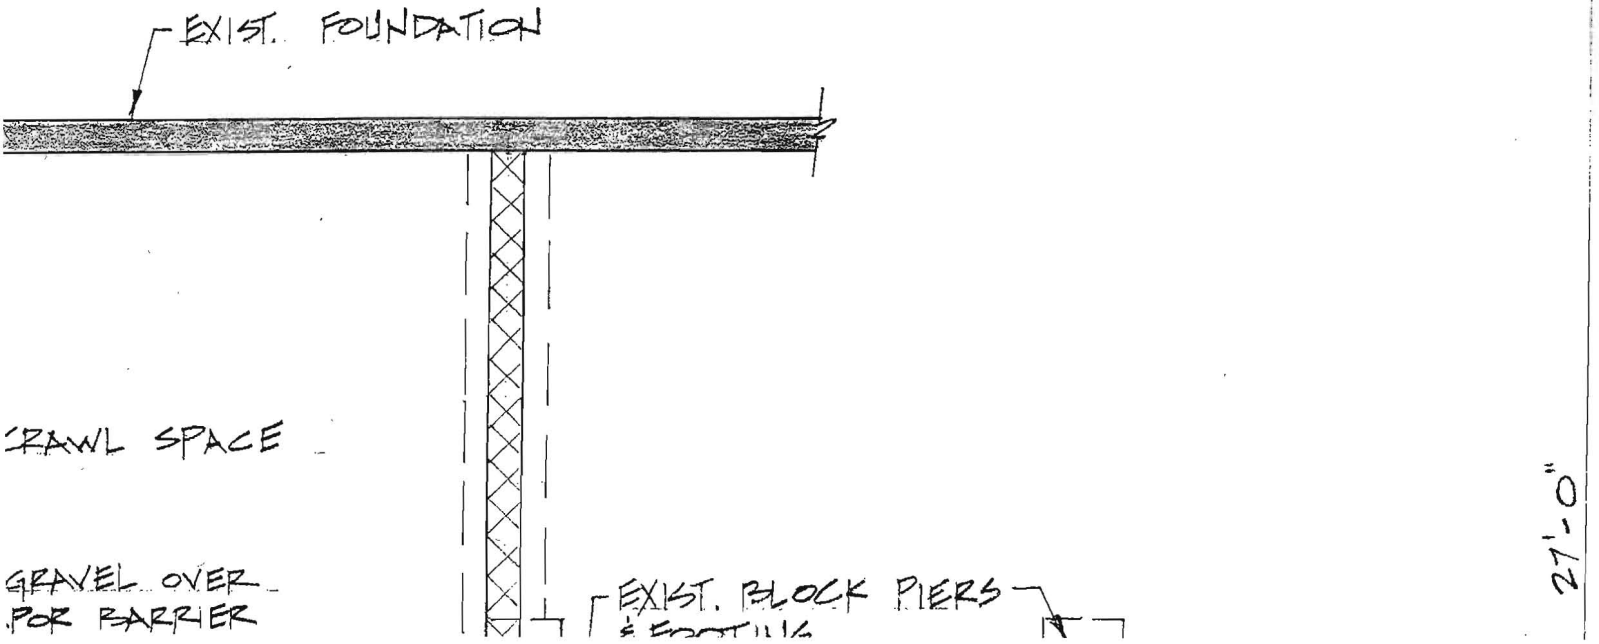

OLD FREDERICK RD


R=1040.00' A=120.00'

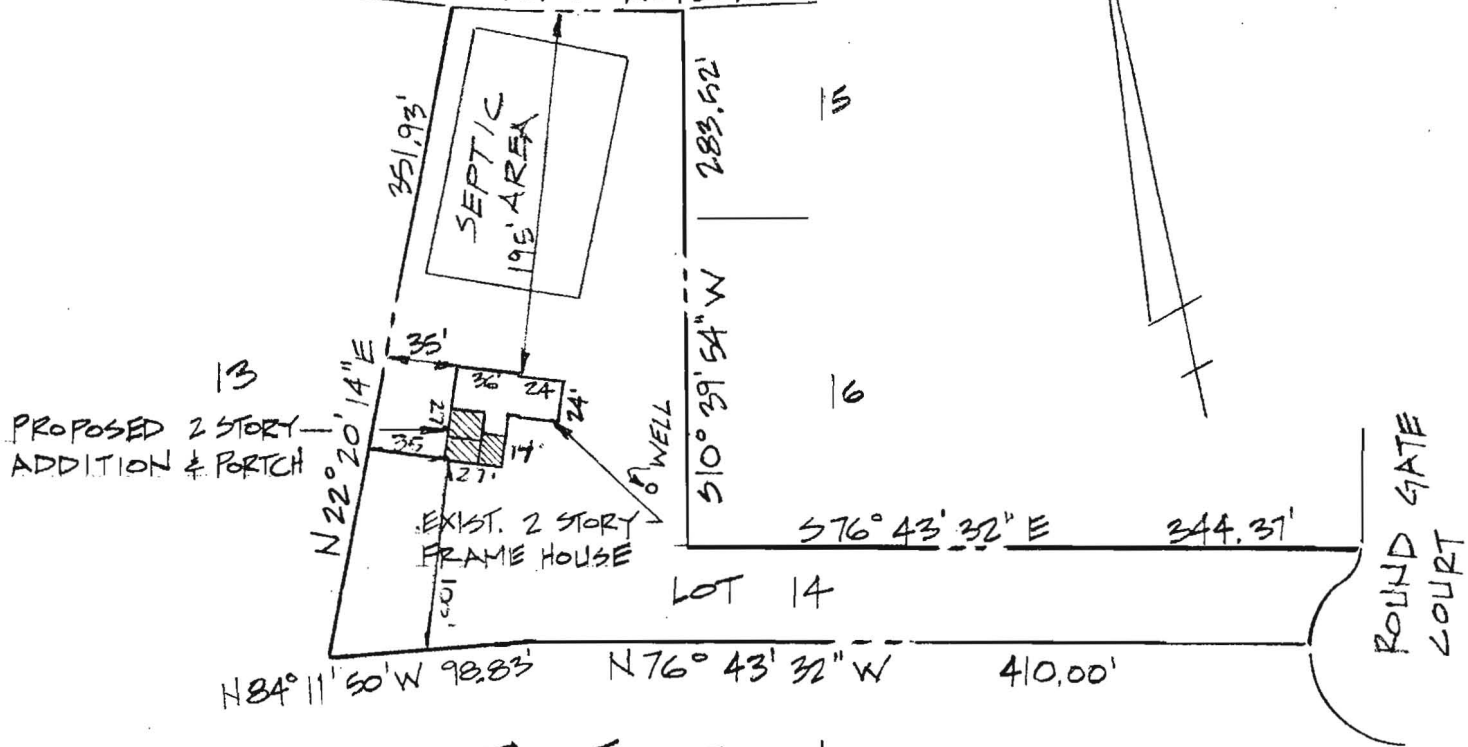

LOT PLAN

1"=100'

6/25/04
 Expansion of
 Master bedroom,
 sunroom & deck ok'd
 (KN)

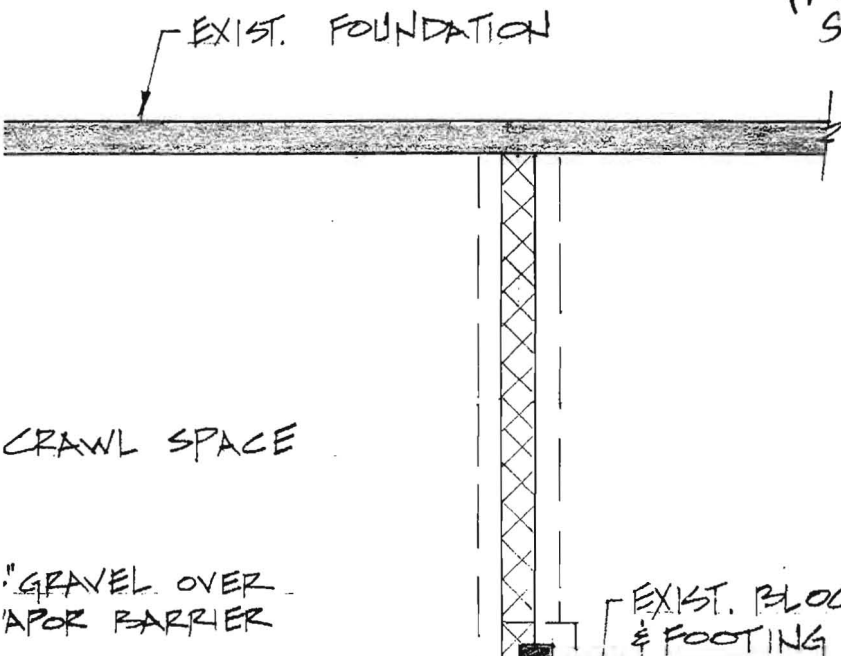

27'-0"