

13586 Argo Dr.

Linden Chapel Hills Dayton Md.

Lot 25 Block C

Donalds Executive Center


14567 Triadelphia Rd

Dayton Md 21036

256 3108

Section 4

56,221 sqft. ±

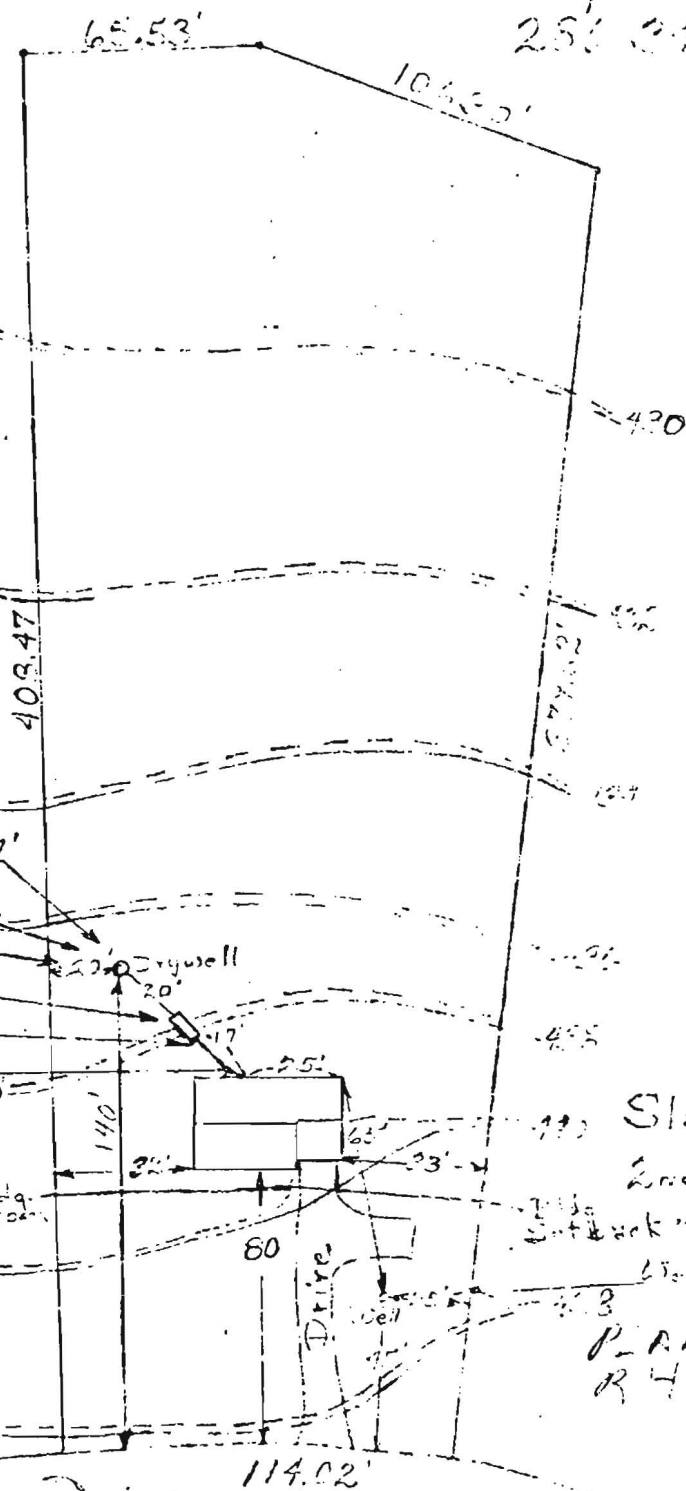

EXIST. grade  
Finish grade

Elev. at Time of perc 437'  
Exist. Elev. 437  
Low Elev. 433  
Exist. Elev. 438  
Inv. Elev. 435  
Inv. Elev. 437

Slab Elev. 440  
2nd F. Elev. 449

Scale 1" = 50'

PLANS OK  
R4 2/9/76

Argo Drive