

7-12' E.D. 10,000 ft

APPLICATION

A 19680

SEWAGE DISPOSAL TESTING

P _____

STATE OF MARYLAND - DEPARTMENT OF HEALTH AND MENTAL HYGIENE

HOWARD COUNTY HEALTH DEPARTMENT
ENVIRONMENTAL HEALTH SERVICES
P. O. BOX 476, ELLICOTT CITY, MARYLAND 21043
TELEPHONE: 465-5000, EXT. 356

DISTRICT 3

DATE 3/21/74

3/22/74
9:30

TO: THE COUNTY HEALTH OFFICER
ELLICOTT CITY, MARYLAND

I, HEREBY, APPLY FOR THE NECESSARY TEST IN ORDER TO CONSTRUCT (OR RECONSTRUCT) A SEWAGE DISPOSAL SYSTEM.

PROPERTY OWNER Everett L. Ramsburg

ADDRESS 1450 Henryton Road, Marriottsville, Md. PHONE 328-2696

PROPERTY LOCATION:

SUBDIVISION Parcel 2

ROAD AND DESCRIPTION Henryton Road

SIZE OF LOT 5,000 acres TYPE BLDG. 3 or 4

NUMBER OF BEDROOMS
(Single Fmly. Dwllg.)

IF NOT SINGLE RESIDENCE DESCRIBE _____

THE SYSTEM INSTALLED UNDER THIS APPLICATION IS ACCEPTABLE ONLY UNTIL PUBLIC FACILITIES BECOME AVAILABLE.

SIGNATURE OF APPLICANT /s/ Everett L. Ramsburg

APPROVED BY _____ FOR _____ DATE _____
(KIND OF SYSTEM)


REJECTED BY _____ FOR _____ DATE _____
(KIND OF SYSTEM)

HOLD PENDING FURTHER TESTS _____ DATE _____

REASONS FOR REJECTION OR HOLDING _____

THIS IS NOT A PERMIT

MOISTURE

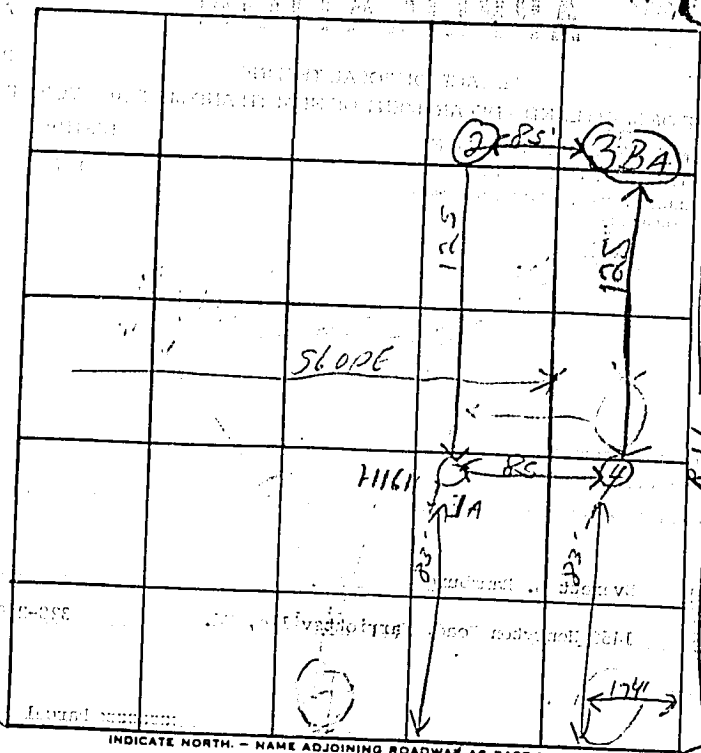

INDICATE NORTH - NAME ADJOINING ROADWAY AS BASE LINE

DATE	TEST NO.	DEPTH	PRE-WET		TEST - 1" DROP		TIME
			START	STOP	START	STOP	
11/14	1	(42)	1208	1210	1210	1210	4
11/14	1A	(120)	1211	1213	1213	1217	4
11/14	2	12'	GOOD	SOIL	AFTER TAMPING		4
	3	4'	1150	1152	1152	1157	5
	3A	12'	1153	1155	1155	1158	3
	4	12'	LEAN +	SHALL	OK		

HIGHWAY

3-22

4
4
5
3
16

4 MW
AVG

REMARKS _____

TYPE OF SOIL SANDY SHALE

TESTED BY _____

ALSO PRESENT: _____