

04-336070

LAYOUT \_\_\_\_\_ INSP 4 \_\_\_\_\_  
INSP 2 \_\_\_\_\_ INSP 5 \_\_\_\_\_  
INSP 3 \_\_\_\_\_ INSP 6 \_\_\_\_\_

ISSUE DATE: \_\_\_\_\_  
APPROVAL DATE: \_\_\_\_\_

**PERMIT**  
**INDEXED**

P 52088FB  
A \_\_\_\_\_

**ON-SITE SEWAGE DISPOSAL SYSTEM  
HOWARD COUNTY HEALTH DEPARTMENT  
BUREAU OF ENVIRONMENTAL HEALTH**

\_\_\_\_\_ IS PERMITTED TO INSTALL  ALTER

ADDRESS: \_\_\_\_\_ PHONE NUMBER: \_\_\_\_\_

SUBDIVISION: Lisbon Acres LOT NUMBER: 5, Sec 1

ADDRESS: 1221 Adgate Court PROPERTY OWNER: \_\_\_\_\_

SEPTIC TANK CAPACITY (GALLONS): \_\_\_\_\_ OUTLET BAFFLE FILTER REQUIRED

PUMP CHAMBER CAPACITY (GALLONS): \_\_\_\_\_ COMPARTMENTED TANK REQUIRED

NUMBER OF BEDROOMS: \_\_\_\_\_

SQUARE FEET PER BEDROOM: \_\_\_\_\_

LINEAR FEET OF TRENCH REQUIRED: \_\_\_\_\_

TRENCHES:	Trench to be _____ feet wide. Inlet _____ feet below original grade. Bottom maximum depth _____ feet below original grade. Effective area begins at _____ feet below original grade. _____ feet of stone below distribution pipe.
LOCATION:	_____
NOTES:	_____

PLANS APPROVED: \_\_\_\_\_ DATE: \_\_\_\_\_

- NOTE: PERMIT VOID AFTER 2 YEARS
- NOTE: CONTRACTOR RESPONSIBLE FOR SCHEDULING A PRE-CONSTRUCTION INSPECTION FOR ALL INSTALLATIONS
- NOTE: WATERTIGHT SEPTIC TANKS REQUIRED
- NOTE: ALL PARTS OF SEPTIC SYSTEM SHALL BE 100 FEET FROM ANY WATER WELL
- NOTE: MANHOLE RISERS REQUIRED ON ALL SEPTIC TANKS AND PUMP CHAMBERS UNLESS SPECIFICALLY AUTHORIZED

**NEITHER THE HOWARD COUNTY COUNCIL NOR THE HEALTH DEPARTMENT IS  
RESPONSIBLE FOR THE SUCCESSFUL OPERATION OF ANY SYSTEM  
PERMITTEE RESPONSIBLE FOR OBTAINING FINAL APPROVAL ON THIS PERMIT  
CALL 410-313-2640 FOR INSPECTION OF SEPTIC SYSTEM**

**BUILDING PERMIT SIGNED**

**AND RETURNED**

9/9/2004 800 150 271 FRONT PORCH

P 520881-B

Will Hopkins  
around 2-30 ft

4/14/78 (1) P.C.O.  
C.F.D.  
P 27996  
A 20711  
4/23/78 (1) P.C.O.  
C.F.D.

# PERMIT

SEWAGE DISPOSAL SYSTEM  
MARYLAND STATE DEPARTMENT OF HEALTH

HOWARD COUNTY

ELLICOTT CITY  
DISTRICT 4th  
DATE 5/4/78

## INDEXED

Will Hopkins IS PERMITTED TO INSTALL  ALTER  
ADDRESS 2724 Jennings Chapel Road, Woodbine, Md. PHONE 489-4711  
SUBDIVISION Lisbon Acres ROAD 1221 Adgate Court LOT 5, Sec. 1  
PROPERTY OWNER Smith Brothers  
ADDRESS

SPECIFICATIONS 3 bedrooms  
SEPTIC TANK CAPACITY 1000 GALLONS  
DRAIN FIELD DEPTH FEET. BOTTOM AREA SQ. FT.  
DEEP TRENCH DEPTH FEET. BOTTOM AREA SQ. FT.  
SEEPAGE PITS ABSORBENT SIDE WALL AREA 140 SQ. FT. sidewall absorption area per bedroom  
INLET PIPE 4 1/2 FT. BELOW ORIGINAL GRADE. MAXIMUM DEPTH 10 1/2 FT. BELOW ORIGINAL GRADE  
EFFECTIVE DEPTH AT FT. BELOW ORIGINAL GRADE  
LOCATE DISPOSAL AREA 130 FT. FROM front LOT LINE AND 60 FT. FROM right LOT LINE AS SEEN WHEN  
FACING LOT FROM Adgate Court

NOTE: Septic tank needs manhole type cleanout to grade level.

OK for trench 90 ft long 10 1/2 ft deep 6 ft stone & follow center  
of ground - 2 in sp. start in some location as per DW.


PLANS APPROVED BY Frank Skinner DATE 1/10/77

- COVER NO WORK UNTIL INSPECTED AND APPROVED
- NEITHER THE HOWARD COUNTY COUNCIL NOR THE HEALTH DEPARTMENT IS RESPONSIBLE FOR THE SUCCESSFUL OPERATION OF ANY SYSTEM
- NOTE IF TRENCH IS USED CALL FOR INSPECTION BEFORE PLACING GRAVEL IN TRENCH
- NOTE NO DRY WELL SHALL EXCEED 15 FOOT IN DIAMETER
- NOTE ALL PIPE FROM HOUSE TO DISPOSAL AREA MUST BE CAST IRON
- PERMIT VOID AFTER THREE YEARS
- NOTE INSTALL STAND PIPE ON SEPTIC TANK AND DRY WELL. STAND PIPES MUST BE 6 INCHES IN DIAMETER. CAST IRON, CONCRETE OR TERRA  
COTTA ACCEPTED

\*INSTALLER IS RESPONSIBLE FOR OBTAINING FINAL APPROVAL ON THIS PERMIT.

A 20711

E.C. ← 2370 → 100 Feet 180 200 250 20711

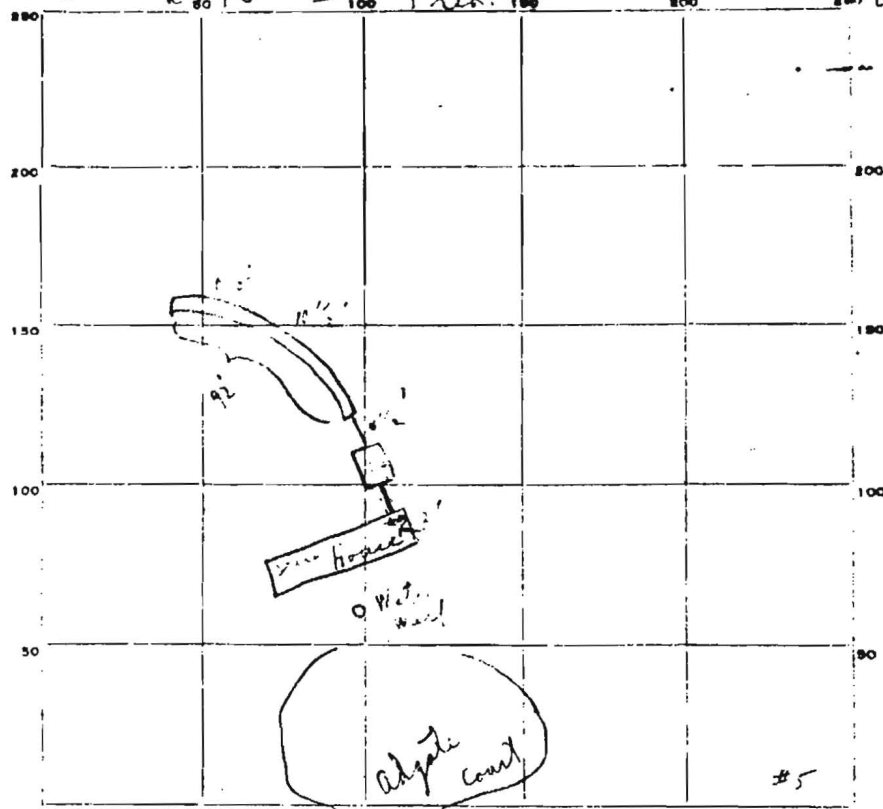

#5

#5

PERMIT CARD  6/16 U20 10/10 10/10

SEPTIC TANK LEVEL \_\_\_\_\_ CLEANOUTS \_\_\_\_\_

DISTRIBUTION BOX LEVEL V/A

TILE FIELD, DEPTH 10 1/2' FT. TRENCH WIDTH \_\_\_\_\_ FT.

GRAVEL DEPTH 6 +' IN. TOTAL LENGTH 92 FT.

NUMBER OF TRENCHES 1 TOTAL BOTTOM AREA ←

SEEPAGE PITS, INSIDE DIAMETER N/A FT. DEPTH BELOW INLET N/A FT.

ABSORBENT AREA 552 ± SQ. FT.

REMARKS: 6/16/70 ok for start in trenching  
6/23/70 still need house connection from septic tank  
to house - need to cover trench  
7/17/70 - house connection made (G.N.)

DATE SYSTEM APPROVED 17 July 70 INSPECTOR \_\_\_\_\_