


20711

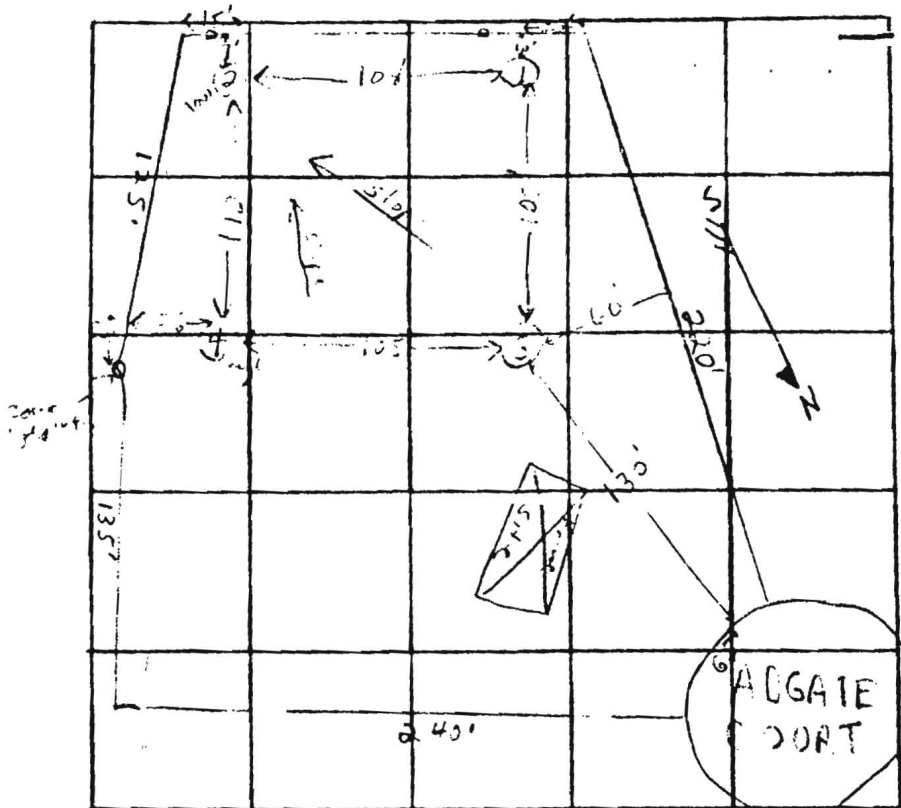

LOT #6
new 5

| DATE | TEST NO. | DEPTH | PRE-WET | | TEST - 1" DROP | | TIME |
|--------|----------|------------------------|----------------------------------|-------|----------------|-------|--------|
| | | | START | STOP | START | STOP | |
| | 1 | 5' | 10:55 | 11:20 | OVER | NE | 11:20 |
| | 1A | 12' | 10:56 | 11:29 | 10:59 | 11:24 | 5 min |
| | 2 low | 6' | 11:07 | 11:29 | 11:09 | 11:15 | 6 min |
| | 2A | 12' | 11:08 | 11:16 | 11:16 | 11:27 | 11 min |
| | 3 | 13 1/2' | 11:20 | 11:20 | 11:20 | 11:20 | 11 min |
| | 4 | 5' | 2:13 | 2:15 | 2:15 | 12:17 | 2 min |
| | 4A | 10' | 2:17 | 2:17 | 12:17 | 12:25 | 8 min |
| | 1B | 6' | 12:37 | 12:41 | 12:41 | 12:50 | 9 min |
| HO-73- | 2122 | 52' casing, 48' grout, | 15 bags C, 2 bags of reg. of CBS | | | | 3-7-78 |

5/11/78
11
material
inlet

REMARKS _____
 TYPE OF SOIL silt
 TESTED BY FC ALSO PRESENT: _____