


Permit #
B00149798


SITE SURVEY

NAME: William Hahn ADDRESS: 3690 Daisy Rd. ACCOUNT #: _____ DONE BY: Pierce DATE: 9/15/04

- WELL
- PUBLIC WATER
- DELIVERY ACCESS
- PROPERTY LINE SETBACKS
- NEW/EXISTING CONSTRUCTION
- SEPTIC
- PUBLIC SEWER
- LANDMARKS/OBSTACLES
- IGNITION SOURCE SETBACKS
- DIRECTIONAL COMPASS

Existing base
Scale: 40

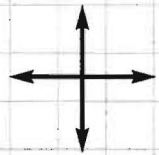3-613
How.

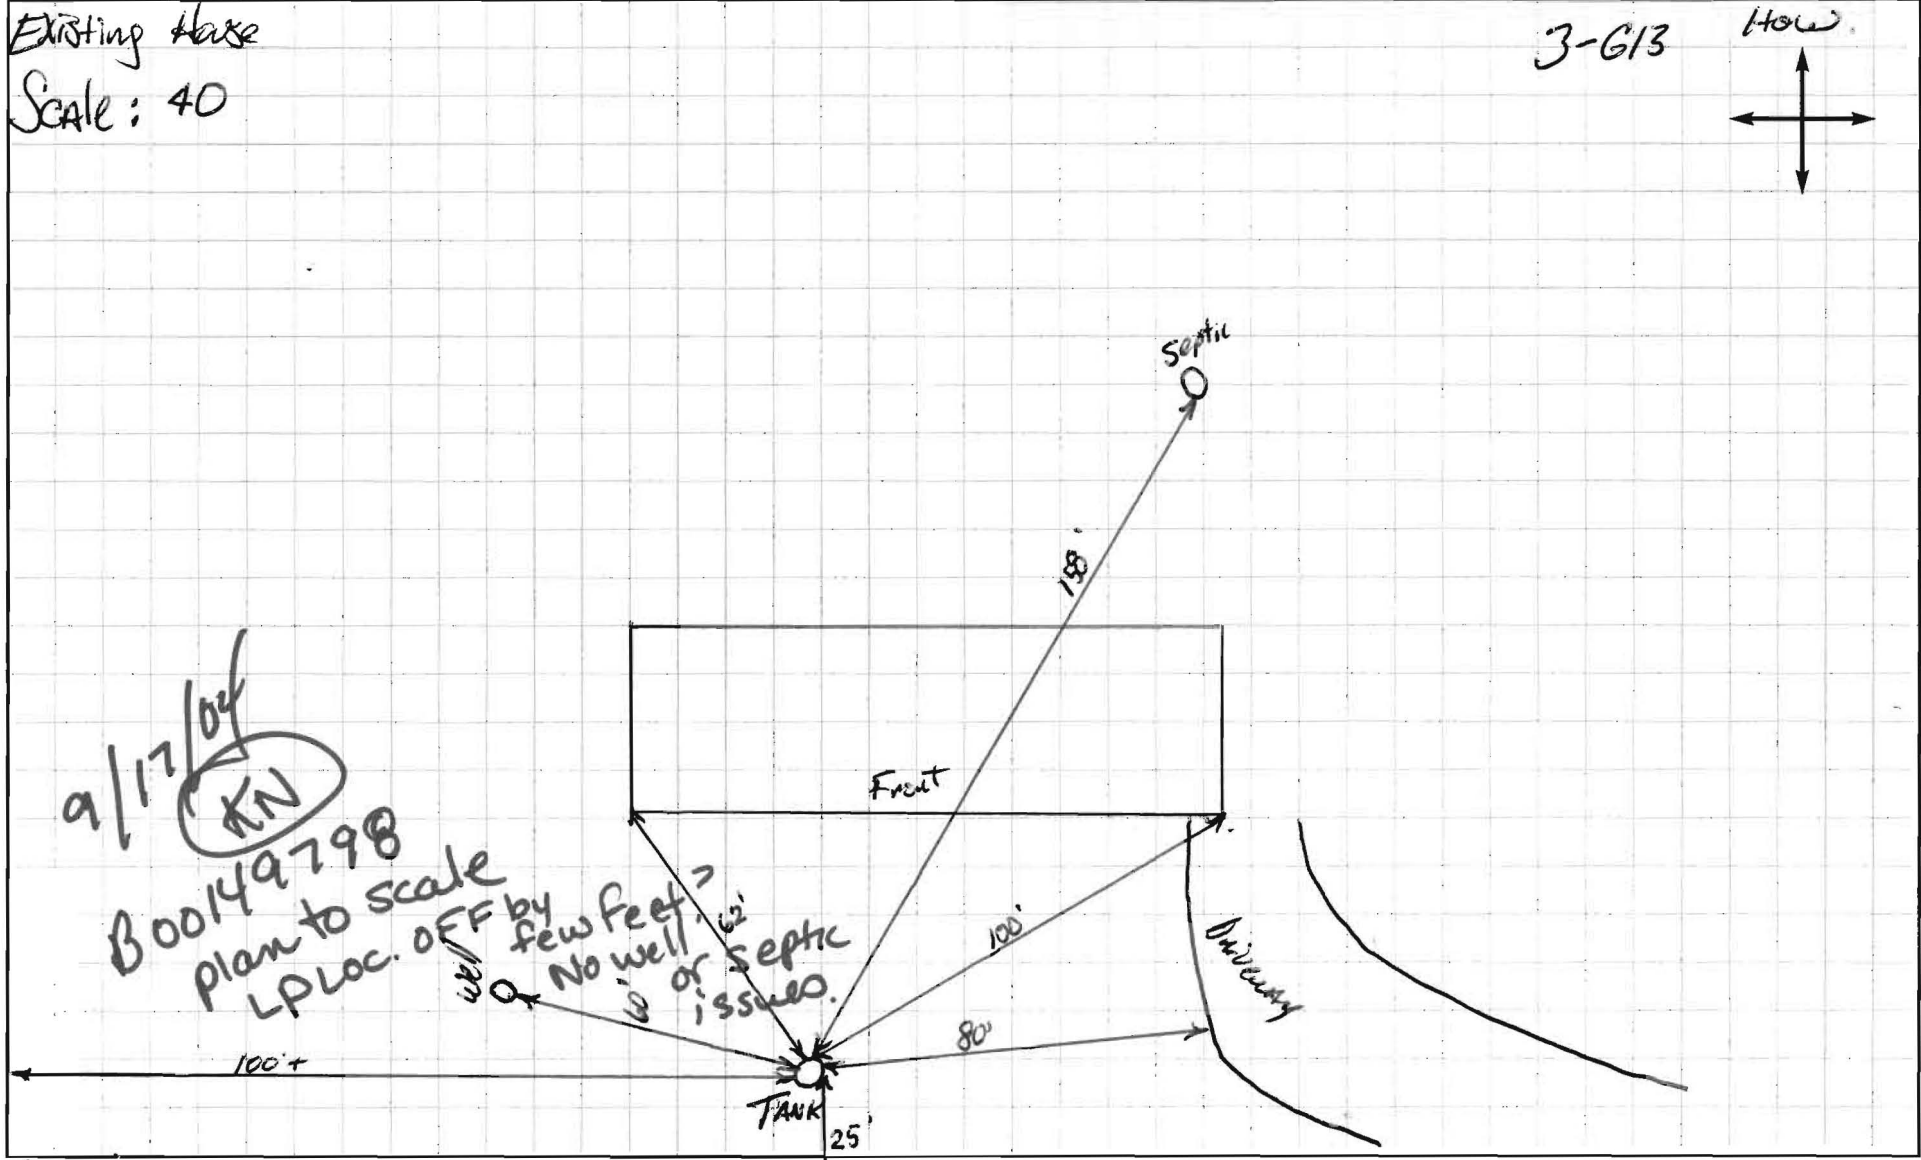


* BUILDING PERMIT NOT APPROVED - LP TANK ALREADY PLACED IN THE GROUND

SITE INSPECTION SHEET

OWNER: William Hahn PHONE #: _____


ADDRESS: 3690 Daisy Road CONTRACTOR: _____

WELL TAG #: H0-73-1196

SUBDIVISION: _____ LOT: _____ COUNTY #: _____

PROPOSAL: LP installation - Submitted drawing incorrect

LOCATION DIAGRAM

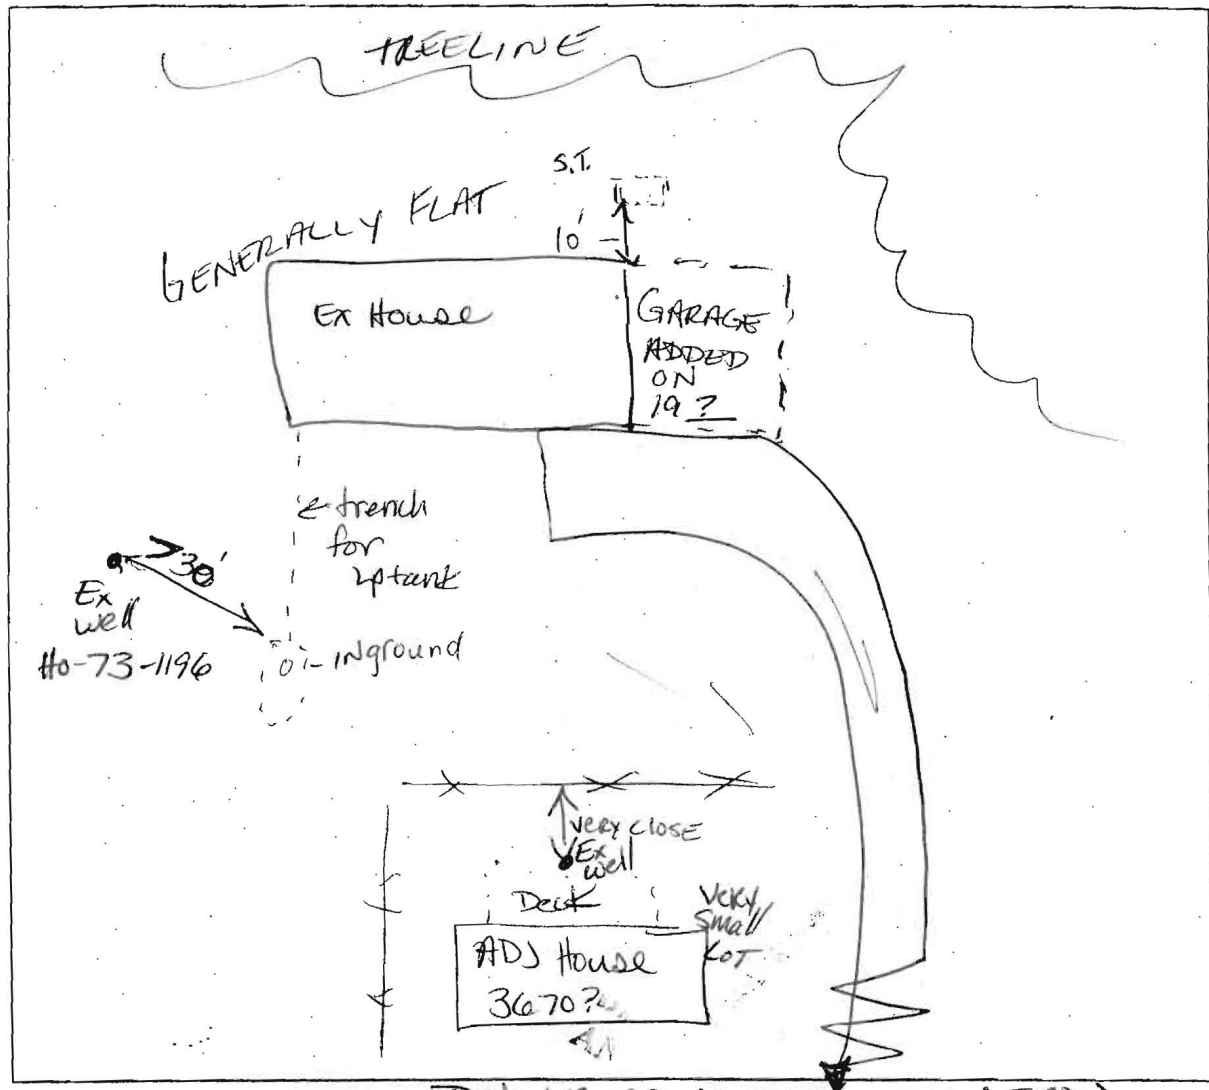

COMMENTS: 1976 septic installation notes appear accurate due to ground indentations. However, there aren't any cleanouts. LP tank already in ground but owner says not hooked up to electric yet. BPO0149798 wasn't signed

DATE: 8/30/04 INSPECTOR: Racie Noonan