

Handwritten notes:
2/11/76
2/11/76
2/11/76

PERMIT

SEWAGE DISPOSAL SYSTEM

MARYLAND STATE DEPARTMENT OF HEALTH

HOWARD COUNTY

INDEXED

P 22808
A 19871
Inter. Check 100
ELLICOTT CITY *CBS*
DISTRICT *4th 421 to 21*
DATE 2/11/76 *CBS*

John & Kathryn Byrne _____ IS PERMITTED TO INSTALL ALTER _____

ADDRESS 705 Chesapeake Avenue, Silver Spring, Md. PHONE 587 5259

A SEWAGE DISPOSAL SYSTEM LOCATED AT _____

SUBDIVISION _____ ROAD 3690 Daisy Road LOT _____
Woodbine, Md.

PROPERTY OWNER John and Kathryn Byrne

ADDRESS same as above

SPECIFICATIONS 3 bedrooms

DRAIN FIELD _____ DEPTH _____ FEET, BOTTOM AREA _____ SQ. FT.

SEEPAGE PITS _____ ABSORBENT SIDE-WALL AREA _____ SQ. FT.

SEPTIC TANK CAPACITY 1000 GALLONS

FOR GARBAGE GRINDER, INCREASE DISPOSAL AREA 25% & TANK CAPACITY 50%.

OTHER DRY WELL - To have 125 sq. ft. effective sidewall absorption area per bedroom. Effective sidewall absorption area starts at 4 ft. below original grade and maximum depth of dry well is 11 ft. Place dry well 11 ft. from the lot line which is 237.80 ft. long and runs 50 degrees 21 ft. W and 13 ft. from the lot line which is 210.24 ft. long and runs S 76 degrees 22 ft. E, when facing the lot from Daisy Road.

NOTE: ALL PIPE FROM HOUSE TO DISPOSAL AREA MUST BE CAST IRON.

PERMIT VOID AFTER THREE YEARS.

NOTE: INSTALL STAND PIPE ON SEPTIC TANK AND DRY WELL. STAND PIPES MUST BE 6 INCHES IN DIAMETER. CAST IRON, CONCRETE OR TERRA COTTA ACCEPTED.

PLANS APPROVED BY Frank Skinner DATE 5/7/74

FILL SEPTIC TANK AND DISTRIBUTION BOX WITH WATER BEFORE CALLING FOR AN INSPECTION. COVER NO WORK UNTIL INSPECTED AND APPROVED.


NEITHER THE HOWARD COUNTY COMMISSIONERS NOR THE HEALTH DEPARTMENT IS RESPONSIBLE FOR THE SUCCESSFUL OPERATION OF ANY SYSTEM.

See attached letter

19871

3690 DAISY ROAD

1987

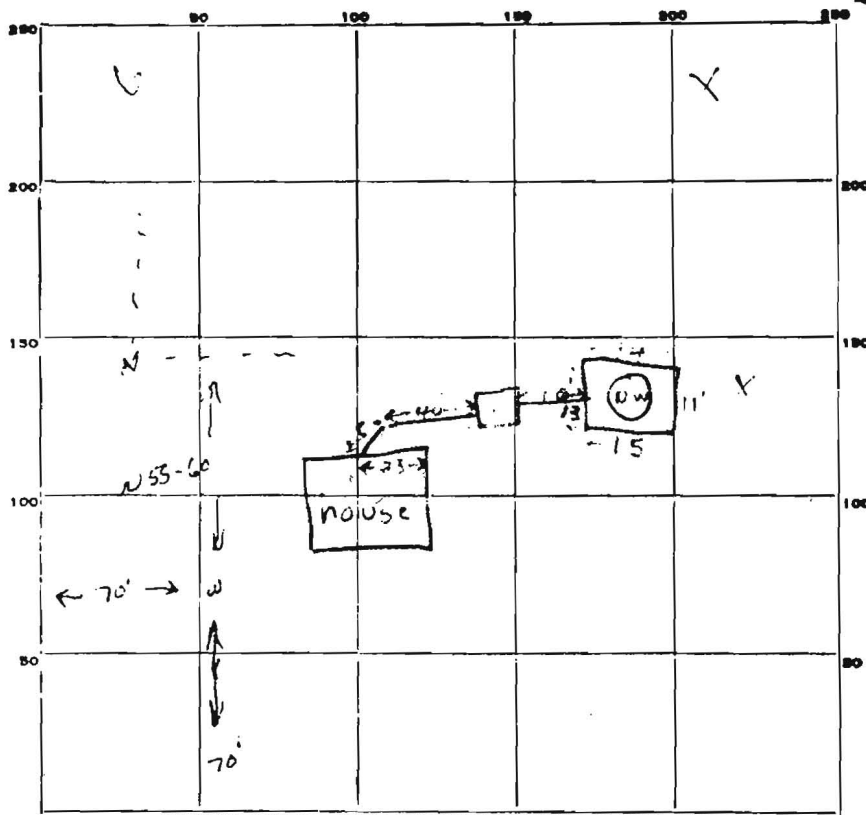

INDICATE NORTH - NAME ADJOINING ROADWAY AS BASE LINE.

PERMIT CARD (signed) indicates contains 1/2/77 signed work certificate certificate DAISY ROAD ST D.W. C.R.D.

SEPTIC TANK, LEVEL 1250 CLEANOUTS _____

DISTRIBUTION BOX, LEVEL _____

TILE FIELD, DEPTH _____ FT. TRENCH WIDTH _____ FT.

GRAVEL DEPTH _____ IN. TOTAL LENGTH _____ FT.

NUMBER OF TRENCHES _____ TOTAL BOTTOM AREA _____

SEEPAGE PITS, OUTSIDE PERIMETER 53 FT. DEPTH BELOW INLET 7 FT.

ABSORBENT AREA 371 SQ. FT.

REMARKS 1/20/76 Pond excavated & 4' deep & now slow seepage well 2' x 4'
excavated 2' in base to septic tank 4' x 4' 2/23/76 No seepage
of line - hold - no change in Dry Well
Septic Tank, Stone in Dry Well 1/2/77 C.R.D.

DATE SYSTEM APPROVED 2/26/76 INSPECTOR R. J. [Signature]