

4-12' Poles
in 10,000 ft.

APPLICATION

By William Swann
A 1987

Pre-approval

SEWAGE DISPOSAL TESTING

P _____

STATE OF MARYLAND - DEPARTMENT OF HEALTH AND MENTAL HYGIENE

HOWARD COUNTY HEALTH DEPARTMENT
ENVIRONMENTAL HEALTH SERVICES

DISTRICT 4

P. O. BOX 476, ELLICOTT CITY, MARYLAND 21043
TELEPHONE: 465-5000, EXT. 356

DATE 4/30/74

4/30/74 *1000 gal. septic tank* *+ B.R.*
250 gal. septic tank
9:30 area just below road. Expective side wall absorption area starts
at 4 ft. below original grade, maximum depth of dugwell
4 ft. below original grade.
Place dugwell 114 ft. from the lot line which is 237.80 ft long
and runs S 06° 11' W and 13 ft from the lot line which is 210.24 ft
long and runs S 76° 22' E when facing the lot from Daisy Rd.

TO: THE COUNTY HEALTH OFFICER
ELLICOTT CITY, MARYLAND

I, HEREBY, APPLY FOR THE NECESSARY TEST IN ORDER TO CONSTRUCT (OR RECONSTRUCT) A SEWAGE DISPOSAL SYSTEM.

PROPERTY OWNER William Swann

ADDRESS Route 108, Highland, Maryland 20777 PHONE 286-2608

PROPERTY LOCATION _____

SUBDIVISION _____ LOT NO. _____

ROAD AND DESCRIPTION Daisy Road (see plat for directions)

SIZE OF LOT 1.000 acres TYPE BLDG. 3 or 4
NUMBER OF BEDROOMS _____

IF NOT SINGLE RESIDENCE DESCRIBE _____

THE SYSTEM INSTALLED UNDER THIS APPLICATION IS ACCEPTABLE ONLY UNTIL PUBLIC FACILITIES BECOME AVAILABLE.

SIGNATURE OF APPLICANT /s/ William Swann

BLDG. PERMIT SIGNED
AND RETURNED 9/24/75

APPROVED BY Frank Quinn FOR Dugwell DATE 5/7/74
(KIND OF SYSTEM)


REJECTED BY _____ FOR _____ DATE _____
(KIND OF SYSTEM)

HOLD PENDING FURTHER TESTS _____ DATE _____

REASONS FOR REJECTION OR HOLDING _____

THIS IS NOT A PERMIT

19871

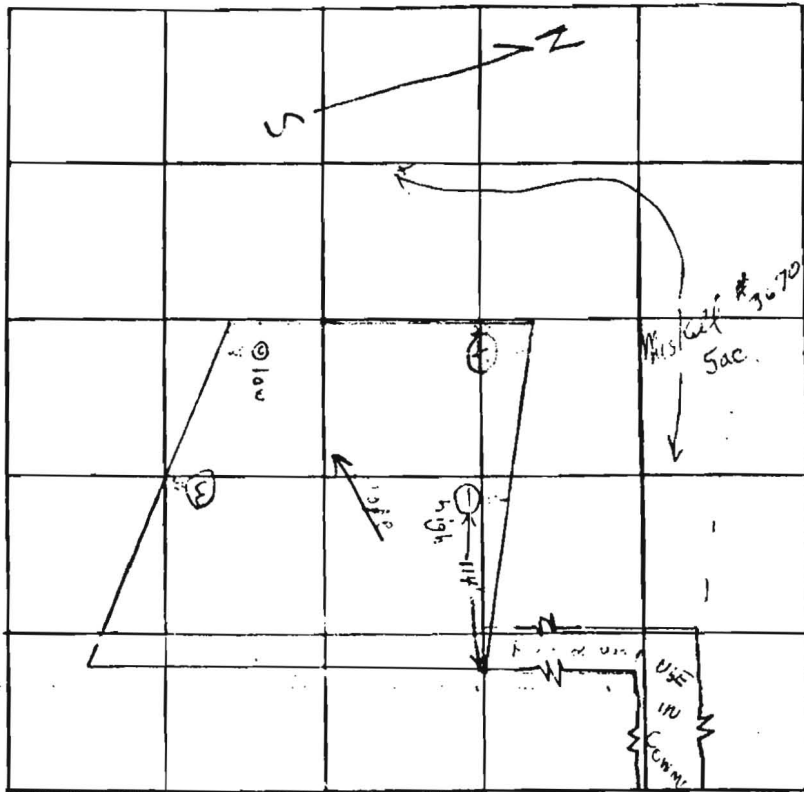

INDICATE NORTH - NAME ADJOINING ROADWAY AS BASE LINE
3690 Dossy Rd.

DATE	TEST NO.	DEPTH	PRE-WET		TEST - 1" DROP		TIME
			START	STOP	START	STOP	
4/30/74	1 a	4'	10:14	10:21	10:21	10:26	5 min
	1 b	11'	10:18	10:20	10:20	10:24	4 min
	2 a low	5 1/2'	10:27	10:10	10:10	10:16	6 min
	2 b	11 1/2'	10:23	10:29	10:29	10:11	2 min
	3	10 1/2'	top 4" clay		10:00	10:00	1 sec
	4	10 1/2'	top 4" clay		10:00	10:00	1 sec

17.4.25

REMARKS _____

TYPE OF SOIL _____

TESTED BY F.S. Jones ALSO PRESENT: A.B. Wilson