

file

PERMIT

*Final
OK
K. [unclear]*

P 27261
A 13305

SEWAGE DISPOSAL SYSTEM

MARYLAND STATE DEPARTMENT OF HEALTH
HOWARD COUNTY

INDEXED

ELLICOTT CITY
DISTRICT 3

DATE 5/19/72

Liberty Sewer Service IS PERMITTED TO INSTALL X ALTER

ADDRESS NEEDLESVILLE, MARYLAND PHONE 775-2643

A SEWAGE DISPOSAL SYSTEM LOCATED AT _____

SUBDIVISION KINGSTON ROAD TRINIDAD BL. LOT 3, BLK. B, SEC.

PROPERTY OWNER HOWARD COUNTY

ADDRESS _____

SPECIFICATIONS - 3 bedrooms

DRAIN FIELD _____ DEPTH _____ FEET, BOTTOM AREA _____ SQ. FT.

SEEPAGE PITS _____ ABSORBENT SIDE-WALL AREA _____ SQ. FT.

SEPTIC TANK CAPACITY 1,000 GALLONS

FOR GARBAGE GRINDER, INCREASE DISPOSAL AREA 22% & TANK CAPACITY 50%.

OTHER dry well - 200 sq. ft. absorbent sidewall area to begin below the floor - 4 ft. of

non-absorbent gravel. MIN. depth permitted for dry well is 11 ft. below original grade.

Place dry well 20 ft. from front lot line and 67 ft. from left side line as shown when

facing lot from Conchita Drive.

NOTE: ALL PIPES FROM HOUSE TO SEPTIC TANK MUST BE CAST IRON.

PERMIT VOID AFTER THREE YEARS. DETAIL STAND BY ON DRY WELL AND SEPTIC TANK.

PLANS APPROVED BY D. W. [unclear] DATE 11/26/71

FILL SEPTIC TANK AND DISTRIBUTION BOX WITH WATER BEFORE CALLING FOR AN INSPECTION. COVER NO WORK UNTIL INSPECTED AND APPROVED.

NEITHER THE HOWARD COUNTY COMMISSIONERS NOR THE HEALTH DEPARTMENT IS RESPONSIBLE FOR THE SUCCESSFUL OPERATION OF ANY SYSTEM.

3590 CONCHITA DRIVE

File

PERMIT

*Final
OK
R Town*

P 17161

A 13386

SEWAGE DISPOSAL SYSTEM

MARYLAND STATE DEPARTMENT OF HEALTH

HOWARD COUNTY

INDEXED

ELLICOTT CITY

DISTRICT 3

DATE 6/19/72

Liberty Backhole Service IS PERMITTED TO INSTALL ALTER

ADDRESS Marriottsville, Maryland PHONE 795-2642

A SEWAGE DISPOSAL SYSTEM LOCATED AT _____

SUBDIVISION Kingston ROAD Triadelphia Rd. LOT 3, Blk. B, Sec. 2

PROPERTY OWNER Roswell Conway

ADDRESS _____

SPECIFICATIONS - 3 bedrooms

DRAIN FIELD _____ DEPTH _____ FEET. BOTTOM AREA _____ SQ. FT.

SEEPAGE PITS _____ ABSORBENT SIDE-WALL AREA _____ SQ. FT.

SEPTIC TANK CAPACITY 1,000 GALLONS

FOR GARBAGE GRINDER, INCREASE DISPOSAL AREA 22% & TANK CAPACITY 50%.

OTHER Dry well - 300 sq. ft. absorbent sidewall area to begin below the first 4 ft. of

non-absorbent ground. Max. depth permitted for dry well is 11 ft. below original grade.

Place dry well 30 ft. from front lot line and 87 ft. from left side line as seen when

facing lot from Conchita Drive.

NOTE: ALL PIPE FROM HOUSE TO SEPTIC TANK MUST BE CAST IRON.


PERMIT VOID AFTER THREE YEARS. INSTALL STAND PIPE ON DRY WELL AND SEPTIC TANK.

PLANS APPROVED BY D. W. Monaghan DATE 11/26/71

FILL SEPTIC TANK AND DISTRIBUTION BOX WITH WATER BEFORE CALLING FOR AN INSPECTION. COVER NO WORK UNTIL INSPECTED AND APPROVED.

NEITHER THE HOWARD COUNTY COMMISSIONERS NOR THE HEALTH DEPARTMENT IS RESPONSIBLE FOR THE SUCCESSFUL OPERATION OF ANY SYSTEM.

A
13386

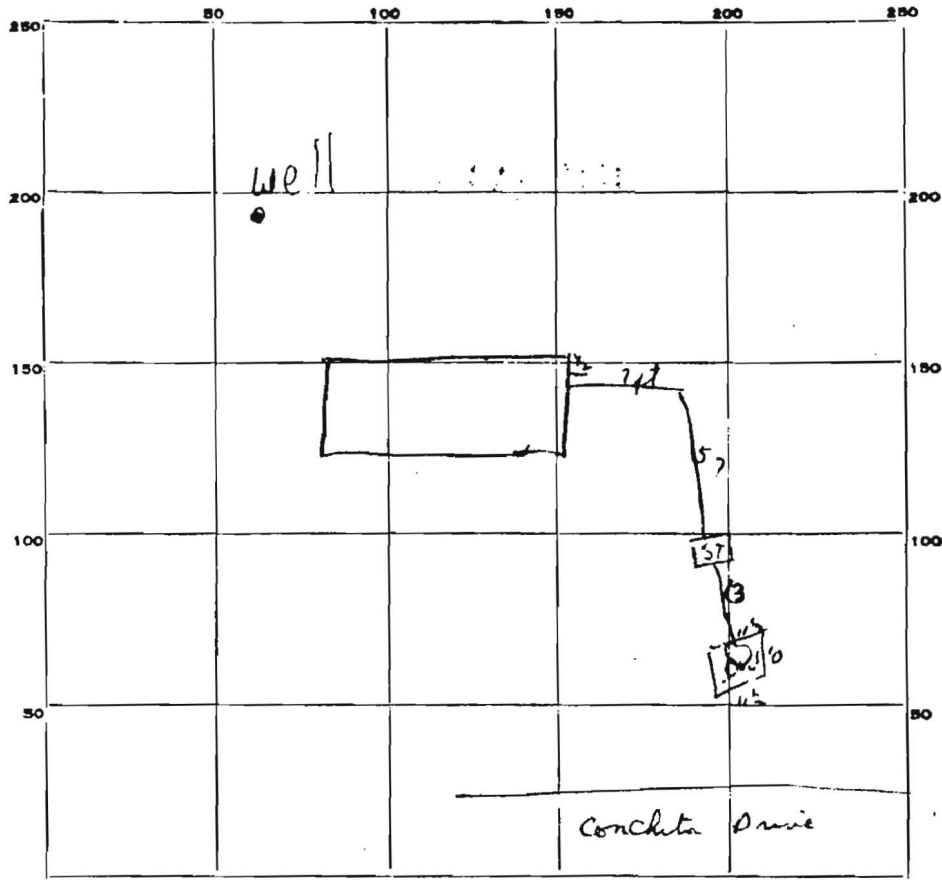

INDICATE NORTH. - NAME ADJOINING ROADWAY AS BASE LINE.

PERMIT CARD Signed

SEPTIC TANK, LEVEL 1000 gal ok CLEANOUTS 0 t

DISTRIBUTION BOX, LEVEL -

TILE FIELD, DEPTH - FT. TRENCH WIDTH - FT.

GRAVEL DEPTH - IN. TOTAL LENGTH - FT.


NUMBER OF TRENCHES - TOTAL BOTTOM AREA -

SEEPAGE PITS. outside perimeter INSIDE DIAMETER 11 1/2 x 11 1/2 FT. DEPTH BELOW INLET 8 FT.

ABSORBENT AREA 348 SQ. FT.

REMARKS _____

DATE SYSTEM APPROVED 9/18/72 INSPECTOR Robert V. Torre

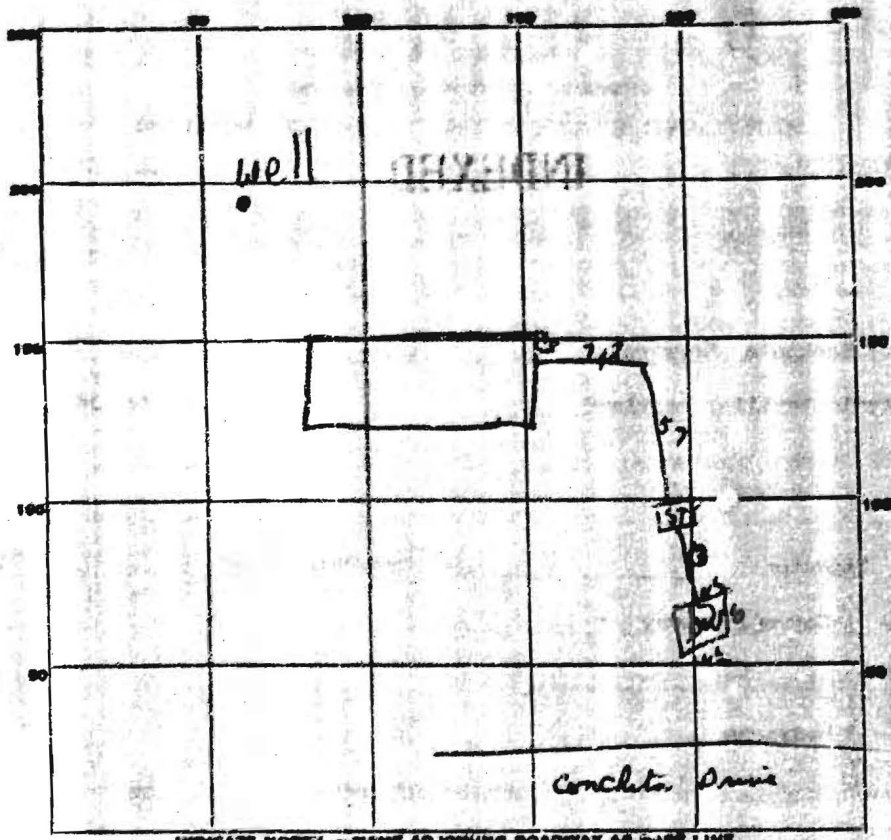

INDICATE NORTH - NAME ADJOINING ROADWAY AS BASE LINE.

PERMIT CARD Signed

SEPTIC TANK, LEVEL 1000 gal 02 CLEANOUTS 01

DISTRIBUTION BOX, LEVEL -

TILE FIELD, DEPTH - FT. TRENCH WIDTH - FT.

GRAVEL DEPTH - IN. TOTAL LENGTH - FT.

NUMBER OF TRENCHES - TOTAL BOTTOM AREA -

SEEPAGE PITS, outside INSIDE DIAMETER 11 1/2 x 11 1/2 FT. DEPTH BELOW INLET 8 FT.

ABSORBENT AREA 348 SQ. FT.

REMARKS _____

DATE SYSTEM APPROVED 9/18/72 INSPECTOR Robert V. Tone