

APPLICATION

SEWAGE DISPOSAL TESTING

A 13386

P _____

MARYLAND STATE DEPARTMENT OF HEALTH

HOWARD COUNTY

ELLICOTT CITY

DISTRICT 3

DATE 12-8-67

TO: THE COUNTY HEALTH OFFICER
ELLICOTT CITY, MARYLAND

I, HEREBY, APPLY FOR THE NECESSARY TESTS IN ORDER TO CONSTRUCT OR RECONSTRUCT A SEWAGE DISPOSAL SYSTEM.

PROPERTY OWNER James W. King, Sr.

ADDRESS 304 Frestona Road PHONE 286-2757

PROPERTY LOCATION:

SUBDIVISION Kingston LOT NO. 3 Block 2

ROAD AND DESCRIPTION Triadelphia Road

Glenslg, Maryland

OCCUPANT _____ PHONE _____

PERSON TO CONSTRUCT SYSTEM _____

ADDRESS _____ PHONE _____

SIZE OF LOT 1 ACRES (2751 x 1701) TYPE BLDG. 1
NUMBER OF DWELLINGS

IF NOT SINGLE RESIDENCE DESCRIBE _____

SIGNATURE OF APPLICANT James W. King, Sr. /s/


APPROVED BY _____ FOR _____ DATE _____
(KIND OF SYSTEM)

REJECTED BY _____ FOR _____ DATE _____
(KIND OF SYSTEM)

HOLD PENDING FURTHER TESTS _____ DATE _____

REASONS FOR REJECTION OR HOLDING _____

THIS IS NOT A PERMIT

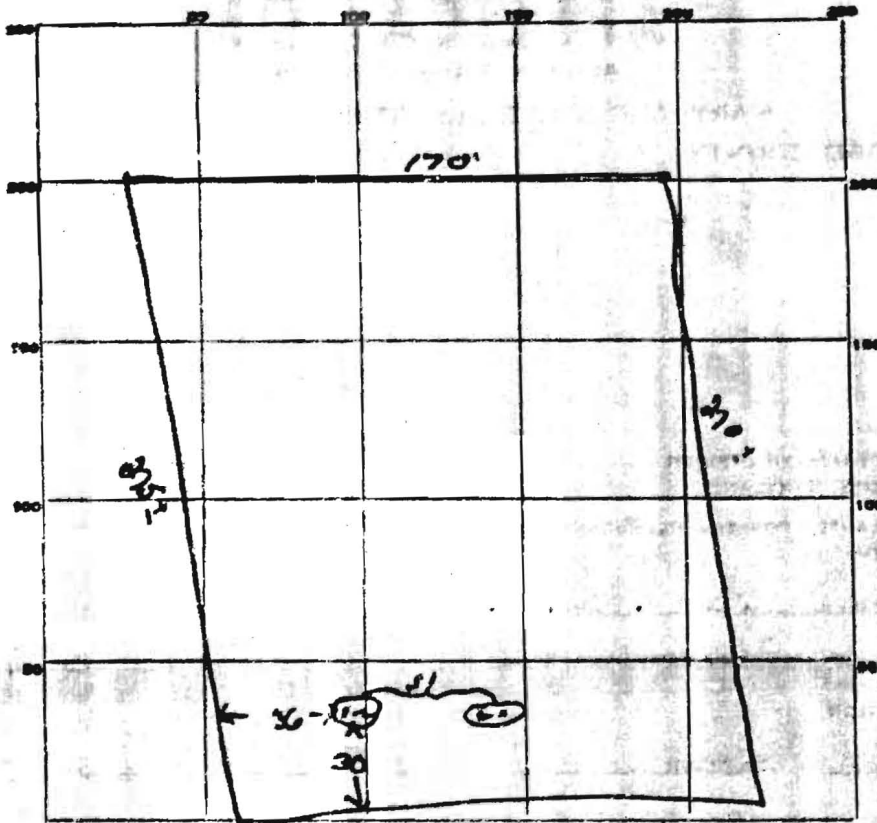

INDICATE NORTH - NAME ADJOINING ROADWAY AS BASE LINE.

Road.

DATE	TEST NO.	DEPTH	PRE-WET		TEST - 1" DROP		TIME
			START	STOP	START	STOP	
4/9/66	1	5ft	1 50	1 52	1 52	1 56	4 min
	2	11 1/2 ft	1 54	1 55	1 55	1 57	2 min
	3	4 ft	1 58	2 00	2 00	2 04	4 min
	4	14 ft	2 00	2 05	2 05	2 14	9 min

4.75
4ft

SOIL AUGER FINDING _____

TESTED BY DJM _____

REMARKS _____

203

APPLICATION

SEWAGE DISPOSAL TESTING

A 13386

F _____

MARYLAND STATE DEPARTMENT OF HEALTH
HOWARD COUNTY

ELLICOTT CITY

DISTRICT 3

DATE 12-8-67

TO: THE COUNTY HEALTH OFFICER
ELLICOTT CITY, MARYLAND

I, HEREBY, APPLY FOR THE NECESSARY TESTS IN ORDER TO CONSTRUCT (OR RECONSTRUCT) A SEWAGE DISPOSAL SYSTEM.

PROPERTY OWNER James W. King, Sr.

ADDRESS 304 Prestown Road PHONE 286-2757

PROPERTY LOCATION:

SUBDIVISION Kingston LOT NO. 3 B. Sec 2

ROAD AND DESCRIPTION Triadelphia Road

Glenelg, Maryland

OCCUPANT _____ PHONE _____

PERSON TO CONSTRUCT SYSTEM _____

ADDRESS _____ PHONE _____

SIZE OF LOT 1 Acre (275' x 170') TYPE BLDG. 3
NUMBER OF BEDROOMS

IF NOT SINGLE RESIDENCE DESCRIBE... 4"

SIGNATURE OF APPLICANT James W. King, Sr. /s/


APPROVED BY _____ FOR _____ DATE _____
(KIND OF SYSTEM)

REJECTED BY _____ FOR _____ DATE _____
(KIND OF SYSTEM)

HOLD PENDING FURTHER TESTS _____ DATE _____

REASONS FOR REJECTION OR HOLDING _____

THIS IS NOT A PERMIT

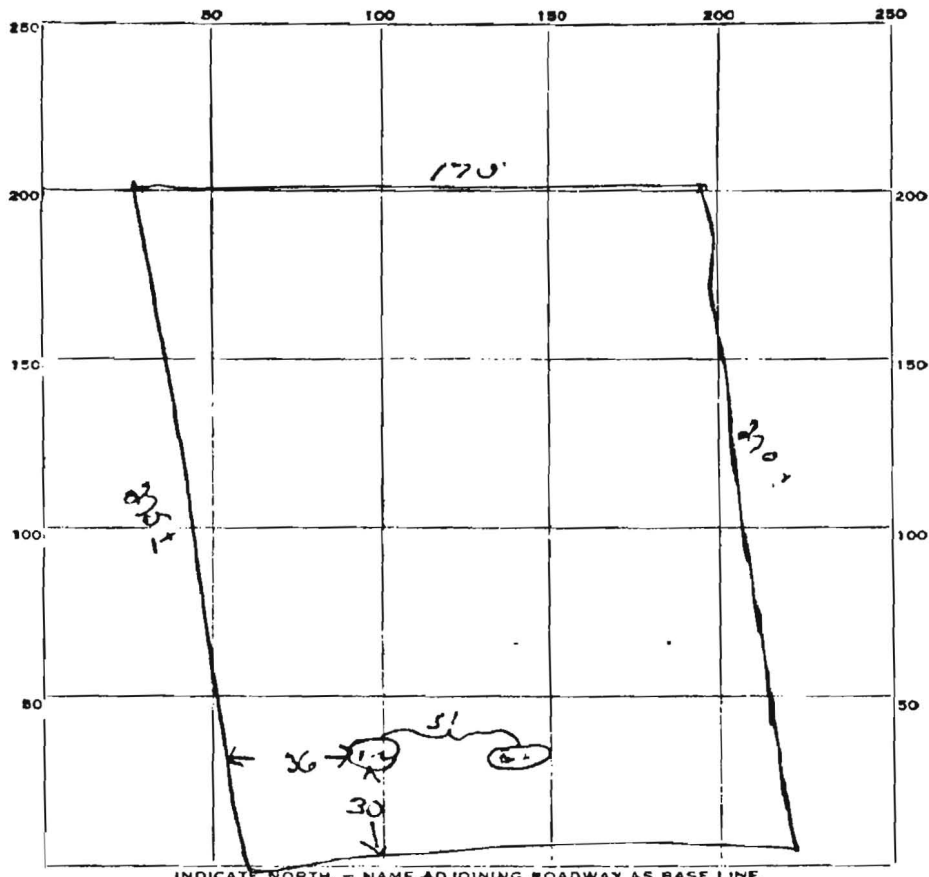

INDICATE NORTH. - NAME ADJOINING ROADWAY AS BASE LINE.

Road

DATE	TEST NO.	DEPTH	PRE-WET		TEST - 1" DROP		TIME
			START	STOP	START	STOP	
4/10/66	1	5ft	1 50	1 52	1 52	1 56	4 min
	2	11 1/2 ft	1 54	1 55	1 55	1 57	2 min
	3	4ft	1 58	2 00	2 00	2 04	4 min
	4	11ft	2 00	2 05	2 05	2 14	9 min

4.75 m
4ft

SOIL AUGER FINDING _____
 TESTED BY WPA
 REMARKS _____

Set 3

A13386

DRIVE

L=15.55

L=34.45

LOT NO. 4

LOT NO. 2

S 71° 59' 02" W 277.43'

S 67° 52' 23" W 280.52'

N 22° 56' 25" W 170.00'

EXIST. 12" DIA. WATER MAIN
 EXIST. 12" DIA. SEWER MAIN
 INV. EL. 91
 EXIST. 12" DIA. WATER MAIN
 EXIST. 12" DIA. SEWER MAIN
 INV. EL. 85

PROP. DWLG.
 F.F. EL. 102
 BASE EL. 94
 44.7'

WATER VALVE
 EXIST. EL. 100

NOTE:
 INDICATED WATER SUPPLY AND
 SEWER DISPOSAL SYSTEMS TO MEET
 LOCAL HEALTH DEPT. REQ.

LOT NO. 3
 AREA = 43,180 SQ. FT.

