

APPLICATION

PERCOLATION TESTING

A 38/60
P _____

HOWARD COUNTY HEALTH DEPARTMENT
BUREAU OF ENVIRONMENTAL HEALTH
P.O. BOX 476 ELLICOTT CITY, MARYLAND 21043
TELEPHONE: 461-9933

DISTRICT _____
DATE 11/28/86

TO: THE COUNTY HEALTH OFFICER
ELLICOTT CITY, MARYLAND

I, HEREBY, APPLY FOR THE NECESSARY TEST IN ORDER TO CONSTRUCT (OR RECONSTRUCT) A SEWAGE DISPOSAL SYSTEM.

PROPERTY OWNER Paul + Elisa Rusonis
Springhill Associates - c/o D.S. Thaler & Associates, Inc.

ADDRESS 11 Warren Road, Baltimore, MD 21208 PHONE (301) 484-4100

PROSPECTIVE BUYER N/A

ADDRESS _____ PHONE _____

PROPERTY LOCATION:

SUBDIVISION Meadowood LOT NO. 53 30

ROAD AND DESCRIPTION Henryton Road - approximately 4000' north of Tunnel Road
Howard County, Maryland (1206 Crystal Ridge Lane)

TAX MAP 10 PARCEL # 139

SIZE OF LOT 3⁺ Acres TYPE BLDG. Single Family
(SINGLE FAMILY DWELLING OR COMMERCIAL)

THE SYSTEM INSTALLED UNDER THIS APPLICATION IS ACCEPTABLE ONLY UNTIL PUBLIC FACILITIES BECOME AVAILABLE. I FULLY UNDERSTAND THE FEE CONNECTED WITH THE FILING OF THIS PERC TEST APPLICATION IS NON-REFUNDABLE UNDER ANY CIRCUMSTANCES. I ALSO AGREE TO COMPLY WITH ALL M.O.S.H.A. REQUIREMENTS IN TESTING THIS LOT.

Mike Sealf
(SIGNATURE OF APPLICANT)

APPROVED BY _____ FOR _____ DATE _____

REJECTED BY _____ FOR _____ DATE _____

HOLD PENDING FURTHER TESTS _____ DATE _____


REASONS FOR REJECTION OR HOLDING 12/11/86 Perc Satisfactory, Hold For Subdivision Plans - 8000

BLDG. PERMIT SIGNED
AND RETURNED 9/4/92
Serial # 45142 - SFD
H. Bedwans

THIS IS NOT A PERMIT

SOIL PROFILE

A1-3
 Yellowed
 silt loam
 9-12% clay
 41% frags
 3.5'
 4.5-5'
 yellowish
 sandy silt
 loam
 25-30%
 miscellaneous
 fragments
 increasing
 to
 40%
 11/07/2

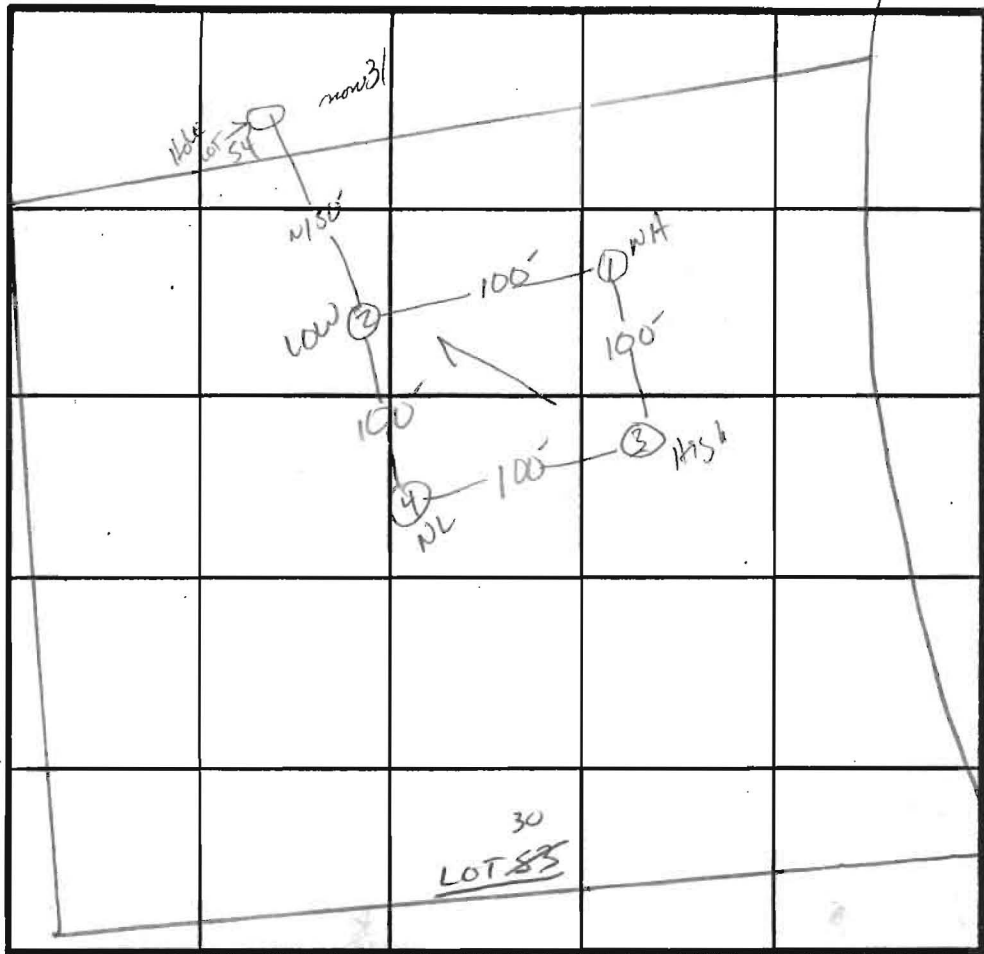

X PERC
 10 min
 210 φ BT
 194 φ BT
 INLET 4 1/2'
 BOTTOM 7'

INDICATE NORTH - NAME ADJOINING ROADWAY AS BASE LINE.

↓ TO HENRYTON Rd.

DATE	TEST NO.	DEPTH	PRE-WET		TEST - 1" DROP		TIME	
			START	STOP	START	STOP		
12/1/86	1V	5" 12.5"	10:35 UNIFORM	10:50 SOIL	10:50 LOW 5"	11:18	28min	
	2V	9.5" 13"	10:36 SAME AS	10:40 #1 WITH	10:40 TEST CLAY	10:46	6min	
	3V	5" 7.5"	10:55 10:52	10:59 10:53	10:59 10:53	11:03	4min	
	3M					10:55	2min	
	3V	13"	SAME AS #2 w/ 3.5' CLAY					
	4V	12.5"	SIMILAR TO HOLE #3					

REMARKS HOLES DIFF FROM PLAT

TYPE OF SOIL Glenalg

TESTED BY S. Abel

OWNER FYOCK & CO.

ALSO PRESENT