

C 1 6086

SEQUENCE NO. (MDE USE ONLY)

STATE OF MARYLAND WELL COMPLETION REPORT

THIS REPORT MUST BE SUBMITTED WITHIN 45 DAYS AFTER WELL IS COMPLETED.

(THIS NUMBER IS TO BE PUNCHED IN COLS. 3-6 ON ALL CARDS)

COUNTY NUMBER 13

ST/CO USE ONLY DATE RECEIVED

DATE WELL COMPLETED 07 18 97

Depth of Well 400 (TO NEAREST FOOT)

PERMIT NO. FROM "PERMIT TO DRILL WELL" HO-94-1191

OWNER Allison Pindell School Richard TOWN Simpsonville

WELL LOG table with columns: DESCRIPTION, FEET (FROM, TO), check if water bearing. Includes entries for top soil, shale, brown mica, gray mica.

GROUTING RECORD form with fields for WELL HAS BEEN GROUTED, TYPE OF GROUTING MATERIAL, CEMENT, BENTONITE CLAY, NO. OF BAGS, NO. OF POUNDS, GALLONS OF WATER, DEPTH OF GROUT SEAL.

CASING RECORD form with fields for casing types, MAIN CASING TYPE, Nominal diameter, Total depth.


OTHER CASING (if used) form with fields for diameter, depth.

SCREEN RECORD form with fields for screen type, diameter, slot size.

DEPTH (nearest ft.) table with columns for depth intervals and diameter of screen.

PUMPING TEST form with fields for HOURS PUMPED, PUMPING RATE, METHOD USED TO MEASURE PUMPING RATE, WATER LEVEL, TYPE OF PUMP USED.

PUMP INSTALLED form with fields for DRILLER WILL INSTALL PUMP, TYPE OF PUMP INSTALLED, CAPACITY, PUMP HORSE POWER, PUMP COLUMN LENGTH, CASING HEIGHT.

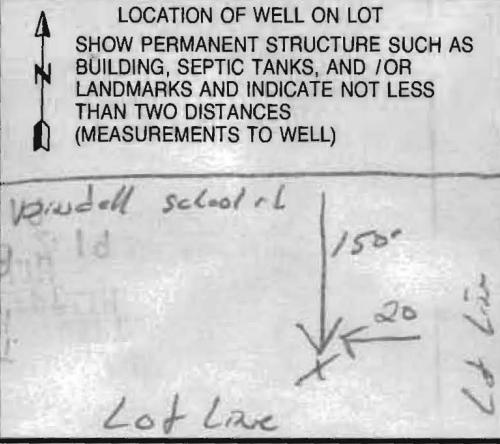

NUMBER OF UNSUCCESSFUL WELLS: 0

WELL HYDROFRACTURED form with YES/NO options.

CIRCLE APPROPRIATE LETTER form with options A, E, P.

DRILLERS LIC. NO. and SIGNATURE form.

SITE SUPERVISOR form.

MDE USE ONLY (NOT TO BE FILLED IN BY DRILLER) form with fields for T, W, Q, TELESCOPE CASING, LOG INDICATOR, OTHER DATA.

B 1 9322

SEQUENCE NO. (MDE USE ONLY)

STATE OF MARYLAND PERMIT TO DRILL WELL

STATE PERMIT NUMBER

HO-94-1191

fill in this form completely

Date Received (APA)

4/25/97

OWNER INFORMATION

RN 7064 B 3

Howard

LOCATION OF WELL


Allison Richard G. 7167 Pindell School Rd, Fulton, Md. 20759

Howard 8 COUNTY 21 73 76 77 78

DRILLER INFORMATION

George F. Easterday MWD 040 L. Franklin Easterday, Inc. 9265 Brown Church Rd., MT. Airy, Md. 21771

DIRECTION OF WELL FROM TOWN

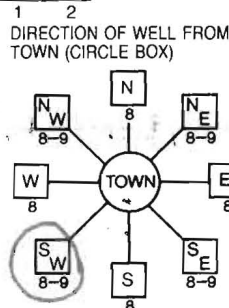

7167 Pindell School Rd

NEAR WHAT ROAD 11 30 ON WHICH SIDE OF ROAD NORTH 200 SOUTH 37 DISTANCE FROM ROAD ENTER FT OR MI 38 39 TAX MAP: BLK: PARCEL

WELL INFORMATION APPROX. PUMPING RATE 5 GAL. PER MIN. AVERAGE DAILY QUANTITY NEEDED 500 GAL. PER DAY

- USE FOR WATER (CIRCLE APPROPRIATE BOX) [D] HOME (SINGLE OR DOUBLE HOUSEHOLD UNIT ONLY) [F] FARMING [I] INDUSTRIAL, COMMERCIAL, STATE AND FEDERAL GOV. OTHER [P] PUBLIC OR PRIVATE WATER COMPANY [T] TEST, OBSERVATION, MONITORING

NOT TO BE FILLED IN BY DRILLER HEALTH DEPARTMENT APPROVAL

Howard 13 COUNTY NAME COUNTY NO. STATE SIGNATURE DATE ISSUED 6-6-97 CO SIGNATURE EXP. DATE 6-6-98 NORTH GRID 488 000 EAST GRID 825 000

APPROXIMATE DEPTH OF WELL 300 FEET APPROXIMATE DIAMETER OF WELL 6 INCH NEAREST

SHOW MAJOR FEATURES OF BOX & LOCATE WELL WITH AN X SOURCES OF DRILLING WATER 1. wells

7/18/97 11:00 GROUT TAG ON WELL LOCATION OK CHART COMPLETE NO ONE ON SITE + 12 GROUT BAGS ON SITE


METHOD OF DRILLING (circle one) BORED (or Augered) JETTÉD Jetted & DRIVEN AIR-ROTARY AIR-PERCussion ROTARY (Hydraulic Rotary) CABLE REVERSE-ROTARY DRIVE-POINT other

WRITE THE BOX NUMBER FROM THE MAP HERE E 8205 N 4808

REPLACEMENT OR DEEPEMED WELLS (CIRCLE APPROPRIATE BOX) [Y] THIS WELL WILL REPLACE A WELL THAT WILL BE ABANDONED AND SEALED [S] THIS WELL WILL REPLACE A WELL THAT WILL BE USED AS A STANDBY-CONTACT LOCAL APPROVING AUTHORITY FOR POLICY ON STANDBY WELLS [D] THIS WELL WILL DEEPEM AN EXISTING WELL PERMIT NUMBER OF WELL TO BE REPLACED OR DEEPEMED (IF AVAILABLE) 41 52

DRAW A SKETCH BELOW SHOWING LOCATION OF WELL IN RELATION TO NEARBY TOWNS AND ROADS AND GIVE DISTANCE FROM WELL TO NEAREST ROAD JUNCTION

Not to be filled in by driller (MDE OR COUNTY USE ONLY) APPROP. PERMIT NUMBER 54 G A P FORCE Km INITIALS IN BOX PERMIT No. HO-94-1191

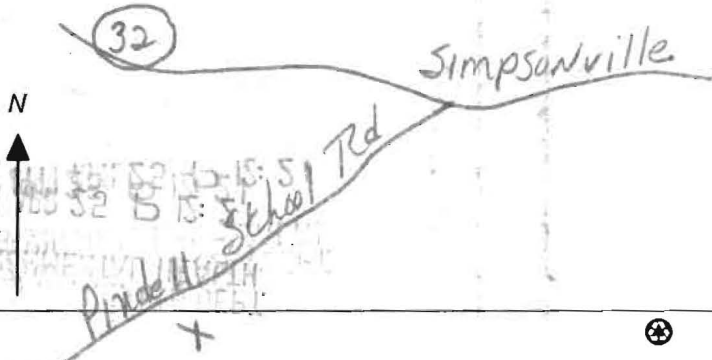

SPECIAL CONDITIONS NOTE - APPROVING AUTHORITIES SHOULD USE SEPARATE SHEET IF NEEDED -

To: mark - 410-313-2648

6/9/99 - 10:10

HOWARD COUNTY HEALTH DEPARTMENT
Bureau of Environmental Health
3525-H Ellicott Mills Drive
Ellicott City, MD 21043
461-9933

APPLICATION FOR PITLESS ADAPTER, WELL PUMP AND PRESSURE TANK INSTALLATION

New Installation
Replacement

Receipt # _____
Date 6-8-99

Name of Installer Darren Wilson (Easterday)

Telephone 301-831-7057

License Number _____

Certified Well Pump Installer _____ Well Driller

Registered Plumber _____

Name of Property Owner Richard Allison

Telephone 301-725-6400

Subdivision _____ Lot # _____

Well Tag # HO-94-1191

Site Address 7167 Pindell School Rd

Pump

- 1. Type
 - a. Deep well jet _____
 - b. Shallow well jet _____
 - c. Submersible

Motor

- 1. Horsepower 3/4
- 2. RPM _____
- 3. Voltage _____
 - a. 110 _____
 - b. 220

Pitless Adapter

- 1. Make Martinson
- 2. Model # B-10X
- 3. Depth 48"

2. Make Goulds

3. Model # SG507422

4. Capacity 5 GPM

5. Pump exceeds well capacity Yes _____ No

6. If Yes, is low pressure cutoff switch installed? Yes _____ No _____

7. What methods are used to protect the pump and electrical wiring from vibrations? Torque arrestors _____ Cable guards Other _____

Tank

- 1. Capacity N/A
- 2. Pressure relief valve?

Piping

- 1. Type PE
- 2. Size 1"
- 3. NSF and/or BOCA Code approved
- 4. Depth of supply line 48"

Well data

- 1. Depth 400 ft.
- 2. Yield 4 GPM
- 3. Static water level _____ ft.
- 4. Will water supply be disinfected by installer?

6/8/99 P.A. COVERED @ TIME OF ARRIVAL (4:30+)

WELL AB. EXPECTED IN NEAR FUTURE

I understand that it is my responsibility to notify the Howard County Health Department when the installation is ready for inspection (otherwise this permit is null and void).

All information given above is true to the best of my knowledge.

Signature of Applicant: Darren Wilson (skc)

Date: 6-8-99

Note: A sticker indicating approval/status of the installation will be placed on the well casing at the time of the inspection.

 WATER WELL ABANDONMENT-SEALING REPORT FORM

W58909-B

SUBMIT COPIES OF COMPLETED FORM TO:

- * COUNTY ENVIRONMENT AGENCY (contact MDE, WMA if address needed)
- * WELL OWNER
- * MDE, WATER MANAGEMENT ADMINISTRATION, WELL PROGRAM

DATE WELL ABANDONED: 3/17/00 (month/day/year)

* PERMIT NUMBER OF ABANDONED WELL (if any) _____

* PERMIT NUMBER OF REPLACEMENT WELL _____

* PERSON ABANDONING WELL: Lester Simmons Jr.

WELL DRILLERS LICENSE NUMBER: _____

CIRCLE: MWD/MSD/MGD

* OWNER'S NAME: Richard Allison

SITE LOCATION MAP

* WELL LOCATION:

COUNTY: Howard


NEAREST TOWN: _____

TAX MAP 41 BLOCK _____ PARCEL 321

SUBDIVISION: _____

SECTION: _____ LOT: _____

NEAREST ROAD: 7167 Pindell School Rd.

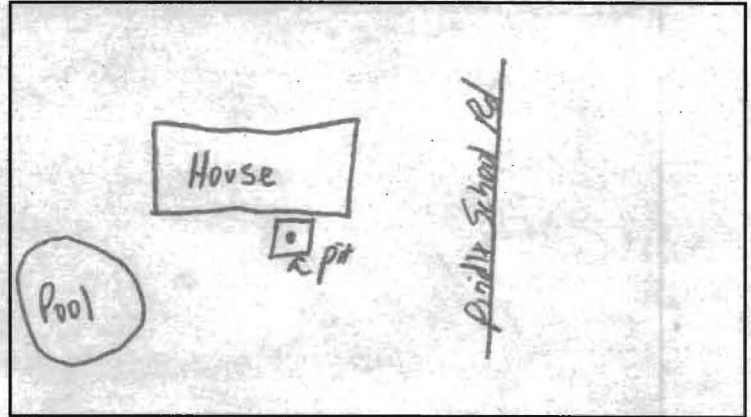

* TYPE OF WELL BEING ABANDONED:

- DRILLED JETTED
- BORED/AUGERED HAND DUG
- OTHER (specify) _____

* USE CODE:

- DOMESTIC MUNICIPAL/PUBLIC
- IRRIGATION INDUSTRIAL
- TEST/OBSERVATION GEOTHERMAL

* TYPE OF CASING:

- STEEL PLASTIC
- CONCRETE OTHER (specify) _____

* SIZE OF CASING: 6 INCHES IN DIAMETER

* DEPTH OF WELL: 92 FEET DEEP

* WAS ANY CASING REMOVED? YES NO
 if yes, length removed, in feet: _____

* WAS CASING RIPPED OR PERFORATED? YES NO

LOG OF SEALING MATERIAL

MATERIAL	FEET	
	FROM	TO
Gravel	92	34
Cement/Bentonite	34	4
Pit	4	0
VOLUME OF MATERIAL USED		

SIGNATURE-MASTER WELL DRILLER OR SUPERVISING SANITARIAN

LICENSE # 269

MWD/MSD/MGD CIRCLE ONE

DATE 3-17-00




4-30-97
existing hand dug well
to be abandoned
and replaced with new well

ALLISON/KIM
LOCATION SURVEY
7167 PINDELL SCHOOL ROAD
5th ELECTION DISTRICT
HOWARD COUNTY, MD
SCALE 1" = 70' 4/8/97



LARRY OWEN ENGINEERING, INC.
2333 COLONY LANE
WILKES BARRE, PA 18702
DAKOTA 50 7109

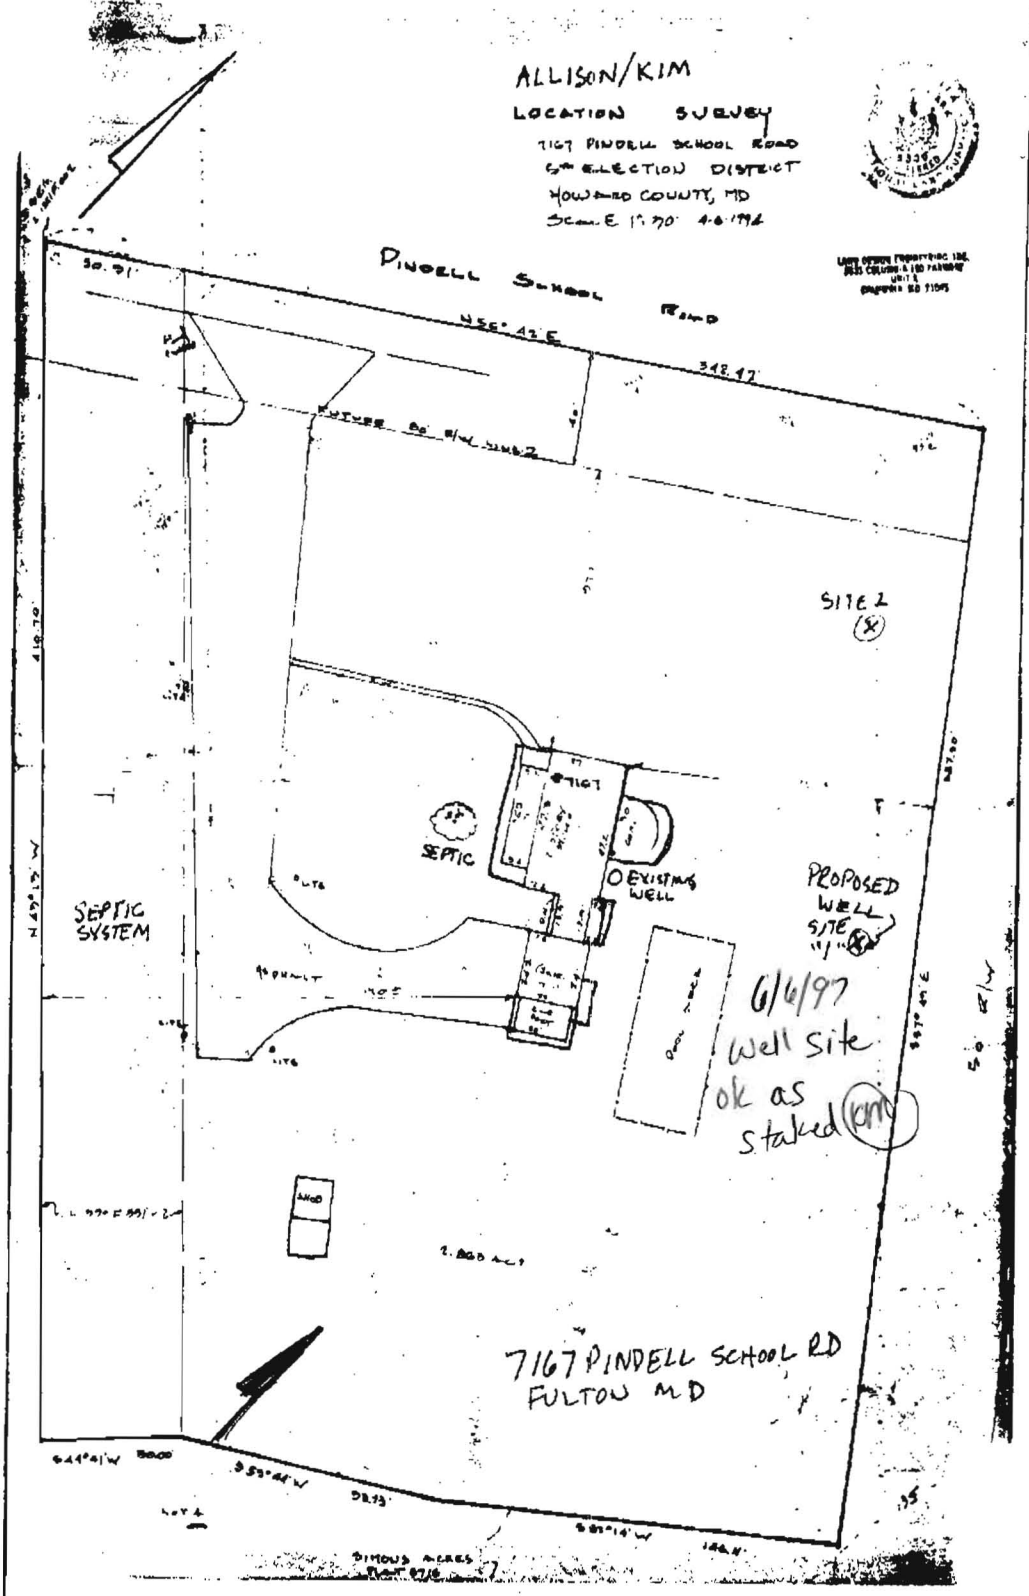


7167 PINDELL SCHOOL ROAD
5th ELECTION DISTRICT
HOWARD COUNTY, MD
SCALE 1" = 70' 4.6.1792



LAND DESIGN ENGINEERING, INC.
8825 COLLEGE & 100 PARKWAY
UNIT B
GALVESTON, MD 21048
4-3

PINDELL SCHOOL ROAD

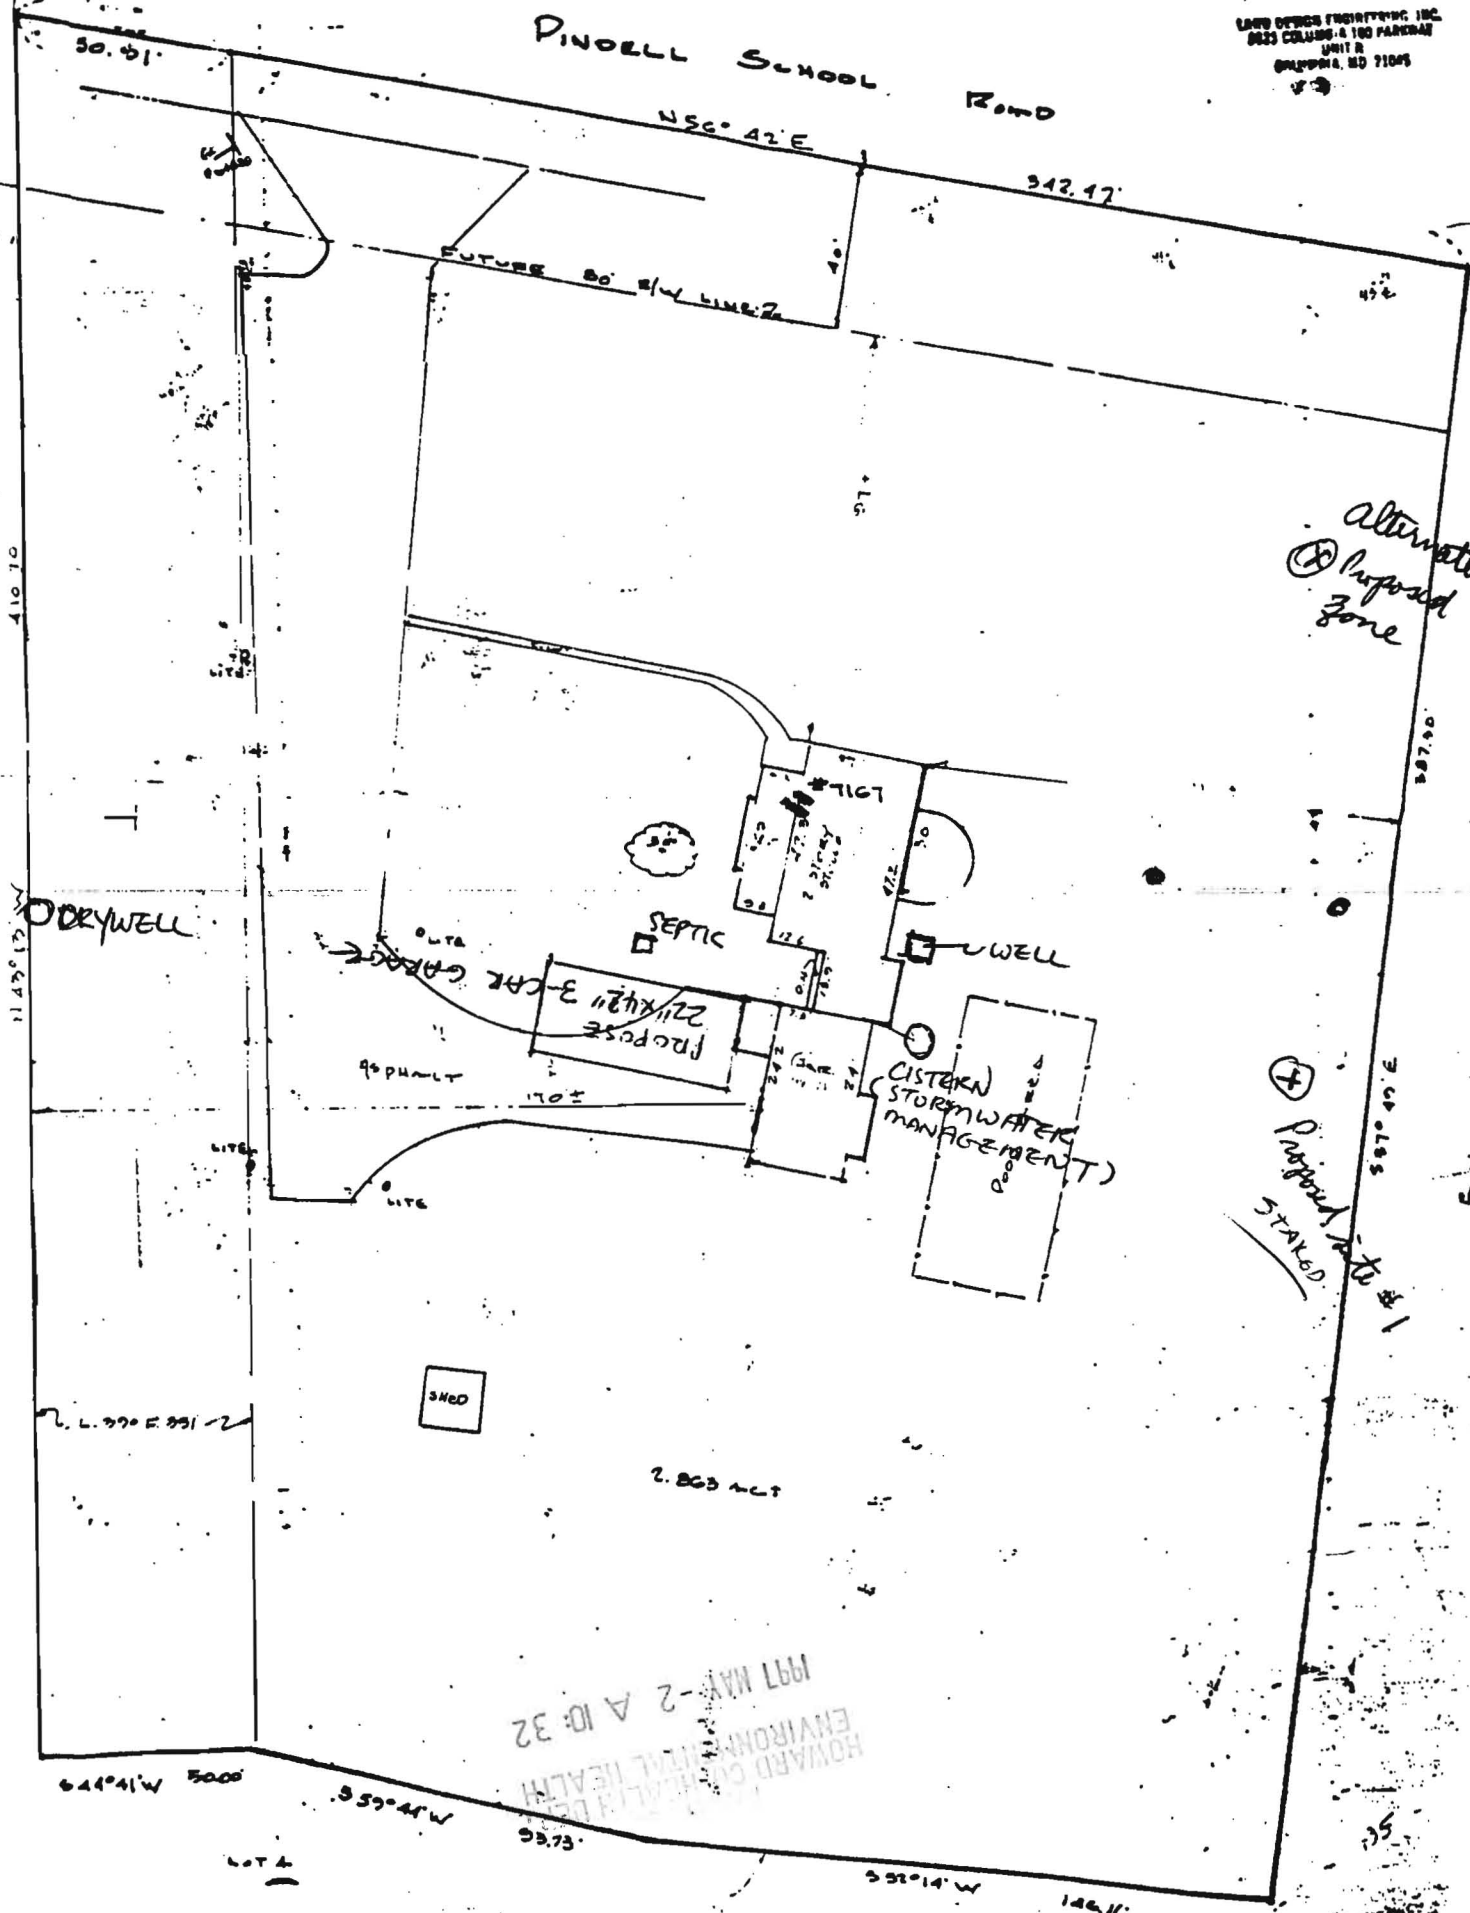

Alternate
Proposed
Zone

Proposed
Staked

1997 MAR - 2 A 10: 32
HOWARD COUNTY HEALTH
ENVIRONMENTAL DESIGN

5005 W 141' 19"
555' 41" W

552' 14" W
146.11'

SIMONS ACRES

SITE INSPECTION

OWNER RICH ALLISON 301-725-6406 DATE REQUESTED 4-22-97


ADDRESS 7167 PINDELL SCHOOL ROAD

MAP 41 GRID 9 PARCEL 321 WELL TAG# _____

NO RECORDS, BUILT 1951 COUNTY# _____

2/14/00 T/C TO OWNERS
MR REQUESTING WELL AB.

LOCATION DIAGRAM

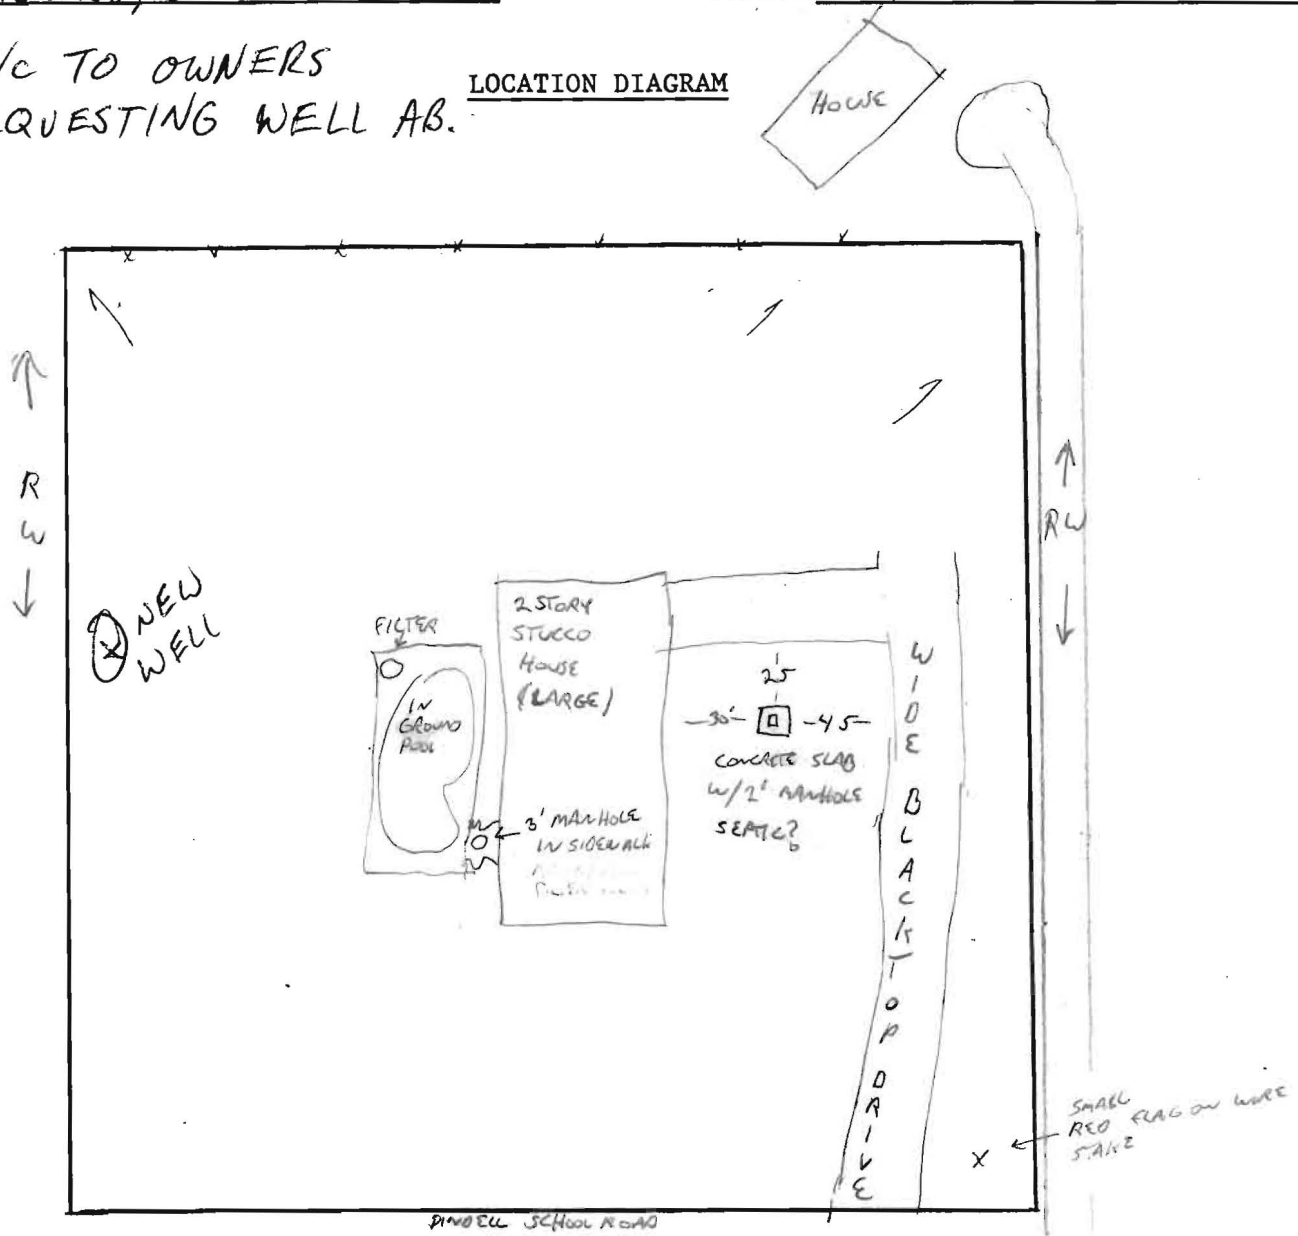

COMMENTS: EMERGENCY WELL SITE INSPECTION REQUESTED BY EASTERDAY WELL DRILLING.

HOUSE IS MODERN, NOT COMPLETE, LOOKS OCCUPIED. NO OBVIOUS WELL STAKES,

NEED SEPTIC LOCATION. T/C w/ EASTERDAY, PROPOSAL IS FOR A REPLACEMENT

WELL TO ACCOMMODATE BUILDING PERMIT, EASTERDAY WILL SUBMIT PAPERWORK TO

US ONCE THEY RECEIVE A PLOT PLAN

M 589097B