

5/3/79

Approved
(GCK)
3 MAY 79

PERMIT

P 29589
A _____

SEWAGE DISPOSAL SYSTEM
MARYLAND STATE DEPARTMENT OF HEALTH*

HOWARD COUNTY

ELLICOTT CITY
DISTRICT 5th

DATE 3/20/79

INDEXED

Olen Ketterman IS PERMITTED TO INSTALL ALTER

ADDRESS 6119 Jerry's Drive, Columbia, Md. 21044 PHONE 997-8740

SUBDIVISION 4971 Greenbridge Road ROAD LOT

PROPERTY OWNER ~~Mrs. Sarah Curran~~ Teresa Logan 443-8888

ADDRESS Greenbridge Road, Dayton, Md. 21036 Fax 443-548-0012

SPECIFICATIONS

- SEPTIC TANK CAPACITY _____ GALLONS
- DRAIN FIELD _____ DEPTH _____ FEET, BOTTOM AREA _____ SQ. FT.
- DEEP TRENCH _____ DEPTH _____ FEET, BOTTOM AREA _____ SQ. FT.
- SEEPAGE PITS _____ ABSORBENT SIDE-WALL AREA _____ SQ. FT.
- INLET PIPE _____ FT. BELOW ORIGINAL GRADE. MAXIMUM DEPTH _____ FT. BELOW ORIGINAL GRADE
- EFFECTIVE DEPTH AT _____ FT. BELOW ORIGINAL GRADE.
- LOCATE DISPOSAL AREA _____ FT. FROM _____ LOT LINE AND _____ FT. FROM _____ LOT LINE AS SEEN WHEN FACING LOT FROM


REPAIR - Call for an appointment when ground is opened up and Sanitarian will recommend the repair system.

PLANS APPROVED BY Palmer F. Wine DATE 3/20/79

- COVER NO WORK UNTIL INSPECTED AND APPROVED.
- NEITHER THE HOWARD COUNTY COUNCIL NOR THE HEALTH DEPARTMENT IS RESPONSIBLE FOR THE SUCCESSFUL OPERATION OF ANY SYSTEM.
- NOTE: IF TRENCH IS USED CALL FOR INSPECTION BEFORE PLACING GRAVEL IN TRENCH.
- NOTE: NO DRY WELL SHALL EXCEED 15 FOOT IN DIAMETER.
- NOTE: ALL PIPE FROM HOUSE TO DISPOSAL AREA MUST BE CAST IRON.
- PERMIT VOID AFTER THREE YEARS.
- NOTE: INSTALL STAND PIPE ON SEPTIC TANK AND DRY WELL. STAND PIPES MUST BE 6 INCHES IN DIAMETER. CAST IRON, CONCRETE OR TERRA COTTA ACCEPTED.

*INSTALLER IS RESPONSIBLE FOR OBTAINING FINAL APPROVAL ON THIS PERMIT.

P 29589

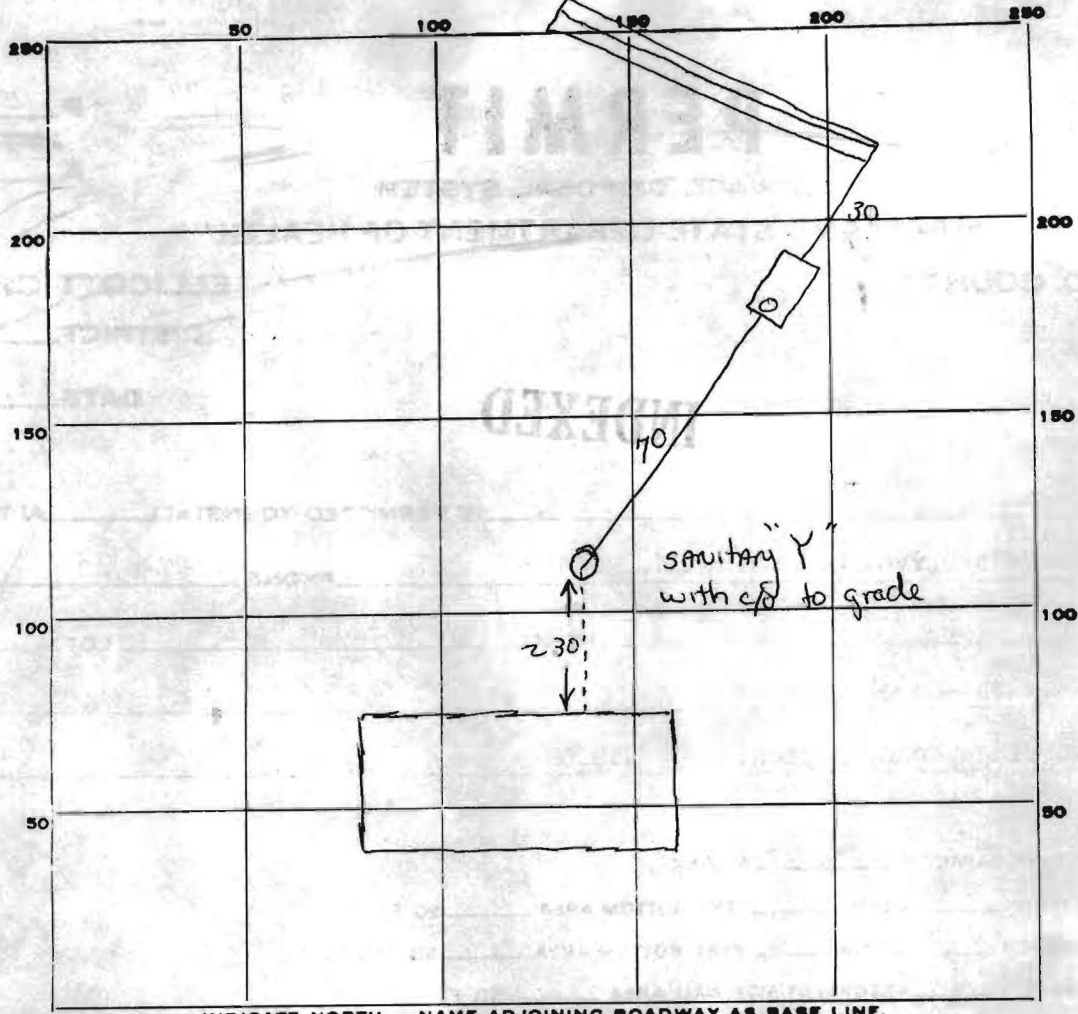

DAYTON ←

INDICATE NORTH. - NAME ADJOINING ROADWAY AS BASE LINE.
GREEN BRIGDE RD

PERMIT CARD msdellers

SEPTIC TANK, LEVEL 1000 gallons CLEANOUTS

ST	Sewer
✓	✓

CAST IRON

DISTRIBUTION BOX, LEVEL Na

TILE FIELD, DEPTH 11 FT. TRENCH WIDTH 2 FT.

GRAVEL DEPTH 8 ~~X~~ TOTAL LENGTH 60 FT.

NUMBER OF TRENCHES 1 TOTAL BOTTOM AREA ± 480

SEEPAGE PITS, INSIDE DIAMETER NA FT. DEPTH BELOW INLET _____ FT.

ABSORBENT AREA _____ SQ. FT.

REMARKS 3 May 79 - Trench excavated & partially grouted on arrival - micaceous SANDY loam - waited for gravel. Final OK. (GLK)

DATE SYSTEM APPROVED 3 May 79 INSPECTOR George Keller