

11am 8/25/04

PUB. SEWER STATUS VERIFIED BY \_\_\_\_\_

ISSUE DATE: 8/18/2004

P 520834-A

APPROVAL DATE: 8/25/04

A REPAIR

# PERMIT INDEXED

## ON-SITE SEWAGE DISPOSAL SYSTEM HOWARD COUNTY HEALTH DEPARTMENT BUREAU OF ENVIRONMENTAL HEALTH

Hatfields Equipment IS PERMITTED TO INSTALL  ALTER

ADDRESS: 13785 Burntwoods Road, Glenelg PHONE NUMBER: 301-854-6172

SUBDIVISION: Palmer Property LOT NUMBER: 2

ADDRESS: 2735 Daisy Road PROPERTY OWNER: Robin Horton

SEPTIC TANK CAPACITY (GALLONS): Ex, 1000 add 500 gal

PUMP CHAMBER CAPACITY (GALLONS): N/A

NUMBER OF BEDROOMS: 4

SQUARE FEET PER BEDROOM: 210

LINEAR FEET OF TRENCH REQUIRED: Ex 162

TRENCHES:	Trench to be _____ feet wide. Inlet _____ feet below original grade. Bottom maximum depth _____ feet below original grade. Effective area begins at _____ feet below original grade. _____ feet of stone below distribution pipe.
LOCATION:	
PURPOSE:	Existing septic system has failed. Call for inspection when ground is opened so sanitarian can recommend repair. TO RELOCATE SEPTIC TANK FOR UPGRADE. SUPPORTS BP00149760 - ↑ 1 bdrm

PLANS APPROVED: KN DATE: 8/18/04

- NOTE: PERMIT VOID AFTER 2 YEARS
- NOTE: CONTRACTOR RESPONSIBLE FOR SCHEDULING A PRE-CONSTRUCTION INSPECTION FOR ALL INSTALLATIONS
- NOTE: WATERTIGHT SEPTIC TANKS REQUIRED
- NOTE: ALL PARTS OF SEPTIC SYSTEM SHALL BE 100 FEET FROM ANY WATER WELL
- NOTE: MANHOLE RISERS REQUIRED ON ALL SEPTIC TANKS AND PUMP CHAMBERS

NEITHER THE HOWARD COUNTY COUNCIL OR THE HEALTH DEPARTMENT IS RESPONSIBLE FOR THE SUCCESSFUL OPERATION OF ANY SYSTEM PERMITTEE RESPONSIBLE FOR OBTAINING FINAL APPROVAL ON THIS PERMIT


**BUILDING PERMIT SIGNED AND RETURNED**

10-313-2640 FOR INSPECTION OF SEPTIC SYSTEM

2-25-04 BDD150006 - Bldg + FINISH BASEMENT

P 520834-A

11/16/12  
(SEE permit P47587)

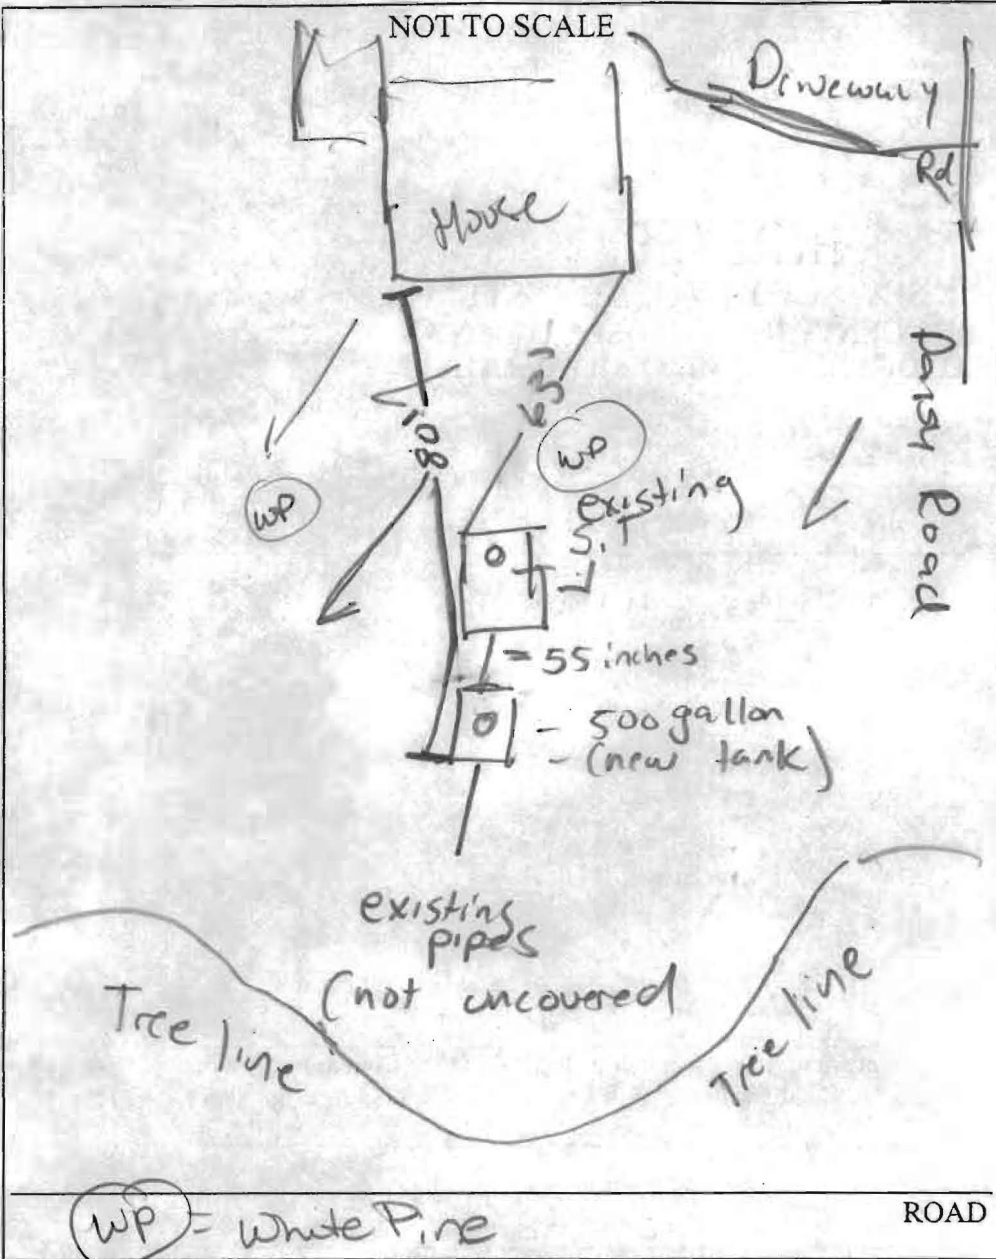

TRENCH/DRAINFIELD DATA		
WIDTH	INLET	BOTTOM
Existing 2	4	8
NUMBER OF TRENCHES		2
TOTAL LENGTH		162'
ABSORPTION AREA		648 ft <sup>2</sup>
DISTRIBUTION BOX LEVEL		==
DISTRIBUTION BOX BAFFLE		==
DISTRIBUTION BOX PORT		==

SEPTIC TANK DATA	
SEPTIC TANK 1 LEVEL <input checked="" type="checkbox"/>	
uncovered for insp	CAPACITY <u>1,000</u> GAL
	SEAM LOC <u>top</u>
	TANK LID DEPTH <u>18</u>
	BAFFLES <u>concrete, PVC</u>
	BAFFLE FILTER <u>N/A</u>
	MANHOLE LOC <u>front</u>
	6" PORT LOC <u>N/A</u>
	WATERTIGHT TEST <u>NO</u>
SEPTIC TANK 2 LEVEL <input checked="" type="checkbox"/>	
	CAPACITY <u>500</u> GAL
	SEAM LOC <u>top</u>
	TANK LID DEPTH <u>2'</u>
	BAFFLES <u>PVC</u>
	BAFFLE FILTER <u>N/A</u>
	MANHOLE LOC <u>center</u>
	6" PORT LOC <u>N/A</u>
	WATERTIGHT TEST <u>NO</u>

PRE-CONSTRUCTION \_\_\_\_\_

INSTALLATION 8/25/04 - Installation of 500 gallon septic tank. Existing tank has new exit baffles, lids 18" to 2' below grade. 2 man hole rises, 1 on front of existing septic + centered in the new 500 gal. Existing 1,000 gal tanks integrity in good condition; no organic material surrounding existing tank. (KN) (PY)

FINAL INSPECTOR K.N P.Y DATE OF APPROVAL 8/25/04

AND RETURNED BUILDING PERMIT SIGNING