

APPLICATION

SEWAGE DISPOSAL TESTING

STATE OF MARYLAND - DEPARTMENT OF HEALTH AND MENTAL HYGIENE

HOWARD COUNTY HEALTH DEPARTMENT
ENVIRONMENTAL HEALTH SERVICES
P. O. BOX 476 ELLICOTT CITY, MARYLAND 21043
TELEPHONE: 992-2330

A 34939

P _____

DISTRICT 3rd

DATE 2-6-85

TO: THE COUNTY HEALTH OFFICER
ELLICOTT CITY, MARYLAND

I, HEREBY, APPLY FOR THE NECESSARY TEST IN ORDER TO CONSTRUCT (OR RECONSTRUCT) A SEWAGE DISPOSAL SYSTEM.

PROPERTY OWNER Garry, Dayton Jr., Paul Bernard

ADDRESS 1035 34 Michael Rd Mt. Airy MD 21751 PHONE 489-7621

PROPERTY LOCATION: Service Rd off 144 East 32

SUBDIVISION Mathis Property LOT NO. 8

ROAD AND DESCRIPTION M 970 (970 E) (Mathis Drive) 12470 BARNARD WAY

BLDG. PERMIT SIGNED
AND RETURNED 11/18/86
S. Abel

SIZE OF LOT 3.2 Ac. ± TYPE BLDG. Res

(NUMBER OF BEDROOMS) 6PH8994

THE SYSTEM INSTALLED UNDER THIS APPLICATION IS ACCEPTABLE ONLY UNTIL PUBLIC FACILITIES BECOME AVAILABLE. I FULLY UNDERSTAND THE FEE CONNECTED WITH THE FILING OF THIS PERC TEST APPLICATION IS NON-REFUNDABLE UNDER ANY CIRCUMSTANCES. I ALSO AGREE TO COMPLY WITH ALL M.O.S.H.A. REQUIREMENTS IN TESTING THIS LOT.

Garry M. Bernard
(SIGNATURE OF APPLICANT)

APPROVED BY Sickey Abel FOR Deep Trucks DATE 2-10-86


REJECTED BY _____ FOR _____ DATE _____

HOLD PENDING FURTHER TESTS _____ DATE _____


REASONS FOR REJECTION OR HOLDING 2-26-85 Incomplete PERC. To complete AT LATER DATE S. Abel
4/9/85 PERC SATISFACTORY - HOLD FOR SUBDIVISION PLAT. CLW

THIS IS NOT A PERMIT

I-70

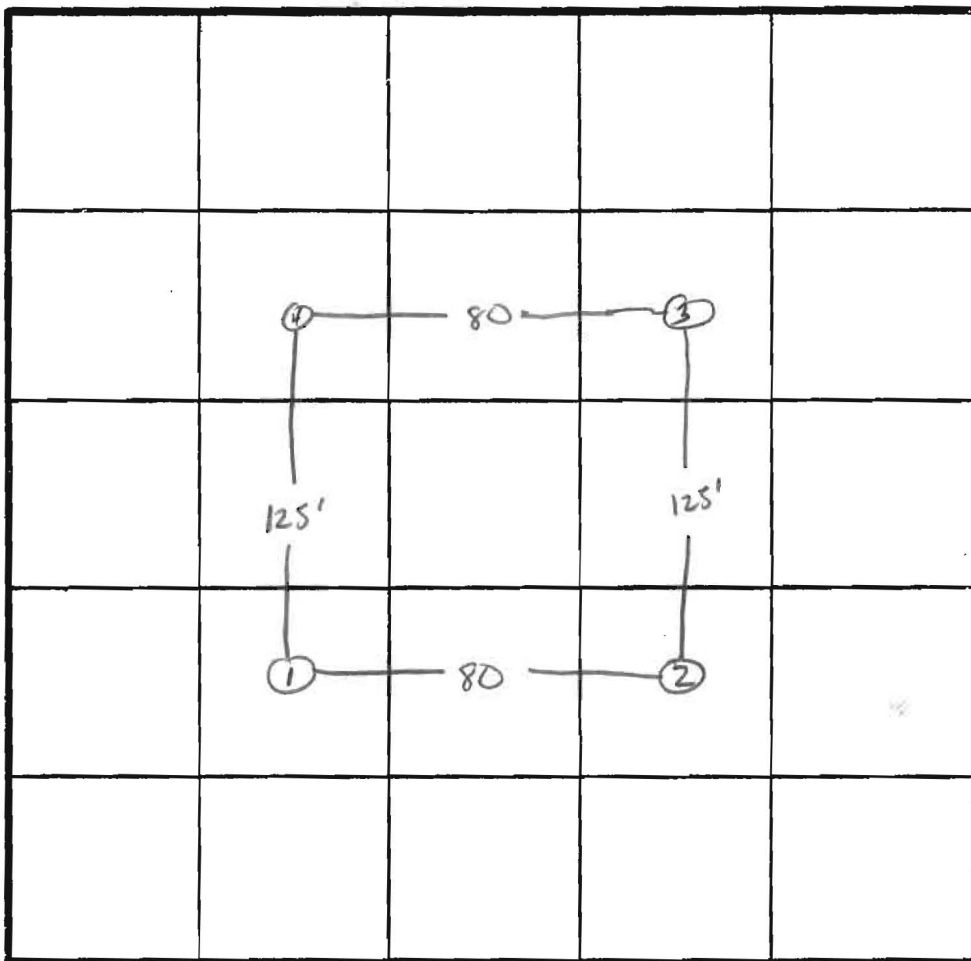


X PER TIME
2 min
INLET 3 FT
BOTTOM MAX
8 FT

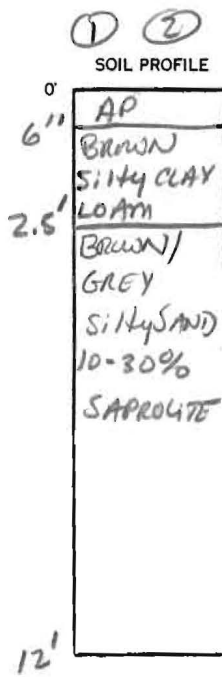

INDICATE NORTH - NAME ADJOINING ROADWAY AS BASE LINE.

RT 144

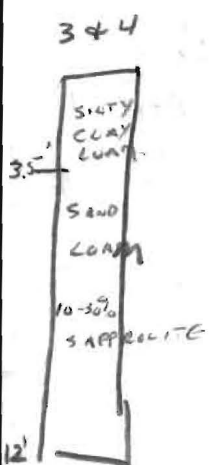

DATE	TEST NO.	DEPTH	PRE-WET		TEST - 1" DROP		TIME
			START	STOP	START	STOP	
2/24/85	1S 1V	3' 12'	2:00	2:00:30	2:00:30	2:01:30	1 min
2/24/85	2S 2V	3' 12'	2:02	2:02:45	2:02:45	2:03:45	1 min
3/9/85	3S 3V	3' 12'	1:32	1:33	1:33	1:35	2 min
3/9/85	4S 4V	3' 12'	1:34	1:42	1:42	?	MOVING

OK CW
SLOWLY FAST SAND AT 4'
OK CW

HOLD 3RD/4TH HOLE UNTIL SOD REMOVED BY OWNER / 3 & 4TH HOLES OK 7/9/85 CW

REMARKS
TYPE OF SOIL Glennville / Chester Association
TESTED BY S. Hall
ALSO PRESENT GARY, DAYTON, PAUL WILL HOPKINS - EXCAVATOR