

C 1 4884 SEQUENCE NO. (WRA USE ONLY)

STATE OF MARYLAND WELL COMPLETION REPORT FILL IN THIS FORM COMPLETELY PLEASE PRINT OR TYPE

THIS REPORT MUST BE SUBMITTED WITHIN 30 DAYS AFTER WELL IS COMPLETED

COUNTY NUMBER 424521

Date Received (WRA use only) Mar 9, 1981 DATE WELL COMPLETED

Depth of Well 265 (TO NEAREST FOOT)

PERMIT NO. FROM "PERMIT TO DRILL WELL" 40-73-3812

OWNER Marker G. F. Inc. last name first name STREET OR RFD Flamewood Apt 11 TOWN Fulton SUBDIVISION Flamewood III SECTION D LOT 3

WELL LOG Not required for driven wells STATE THE KIND OF FORMATIONS PENETRATED, THEIR COLOR, DEPTH, THICKNESS AND IF WATER BEARING

Table with columns: DESCRIPTION (Use additional sheets if needed), FEET (FROM, TO), Check if water bearing. Handwritten entries: Sand 0-65, Gray mica rock 65-265.

GROUTING RECORD WELL HAS BEEN GROUTED (Circle Appropriate Box) TYPE OF GROUTING MATERIAL CEMENT CM BENTONITE CLAY BC NO. OF BAGS 22 NO. OF POUNDS 2,068 GALLONS OF WATER 132 DEPTH OF GROUT SEAL (to nearest foot) from 0 ft. to 60 ft.

CASING RECORD casing types insert appropriate code below MAIN CASING TYPE S+H Nominal diameter top(main)casing (nearest inch) 6 Total depth of main casing (nearest foot) 7.3

OTHER CASING (if used) diameter inch depth (feet) from to

SCREEN RECORD screen type or open hole insert appropriate code below ST BR HO STEEL BRASS, BRONZE OPEN HOLE PL OT PLASTIC OTHER

DEPTH (nearest ft.) 40 71 265

SLOT SIZE 2 DIAMETER OF SCREEN (NEAREST INCH) from 56 to 60 GRAVEL PACK IF WELL DRILLED WAS FLOWING WELL CIRCLE BOX F

C 3 (seq no)

PUMPING TEST HOURS PUMPED (nearest hour) 2

PUMPING RATE (gal. per min. to nearest gal.) 8

METHOD USED TO MEASURE PUMPING RATE Din

WATER LEVEL (distance from land surface) BEFORE PUMPING 45

WHEN PUMPING 90

TYPE OF PUMP USED (for test) A air P piston T turbine C centrifugal R rotary O other (describe below) J jet S submersible

PUMP INSTALLED YES NO DRILLER WILL INSTALL PUMP (CIRCLE APPROPRIATE BOX) Y N

IF DRILLER INSTALLS PUMP, THIS SECTION MUST BE COMPLETED FOR ALL WELLS EXCEPT HOME USE

TYPE OF PUMP (WRITE APPROPRIATE LETTER IN BOX - SEE ABOVE: (A, C, J, P, R, S, T, O))

CAPACITY: GALLONS PER MINUTE (to nearest gallon)

PUMP HORSE POWER PUMP COLUMN LENGTH (nearest ft.)

CASING HEIGHT (circle appropriate box and enter casing height)

LAND SURFACE above below (nearest foot) 2

LOCATION OF WELL ON LOT SHOW PERMANENT STRUCTURE SUCH AS BUILDING, SEPTIC TANKS, AND/OR LANDMARKS AND INDICATE NOT LESS THAN TWO DISTANCES (MEASUREMENTS TO WELL)



CIRCLE APPROPRIATE BOX A A WELL WAS ABANDONED AND SEALED WHEN THIS WELL WAS COMPLETED E ELECTRIC LOG OBTAINED P TEST WELL CONVERTED TO PRODUCTION WELL


I HEREBY CERTIFY THAT I HAVE COMPLIED WITH ALL CONDITIONS STATED ON THE ABOVE-CAPTIONED "PERMIT TO DRILL WELL", AND THAT INFORMATION CONTAINED IN THIS REPORT IS TRUE, ACCURATE, AND COMPLETE TO THE BEST OF MY KNOWLEDGE, INFORMATION AND BELIEF.

DRILLERS IDENT. NO. 238 DRILLERS SIGNATURE (MUST MATCH SIGNATURE ON APPLICATION)

SITE SUPERVISOR (sign. of driller or journeyman responsible for sitework if different from permittee)

WRA USE ONLY (NOT TO BE FILLED IN BY DRILLER) T (E.R.O.S.) W Q TELESCOPE CASING LOG INDICATOR OTHER DATA

2/22/81
Sketch O.V.
J.S.

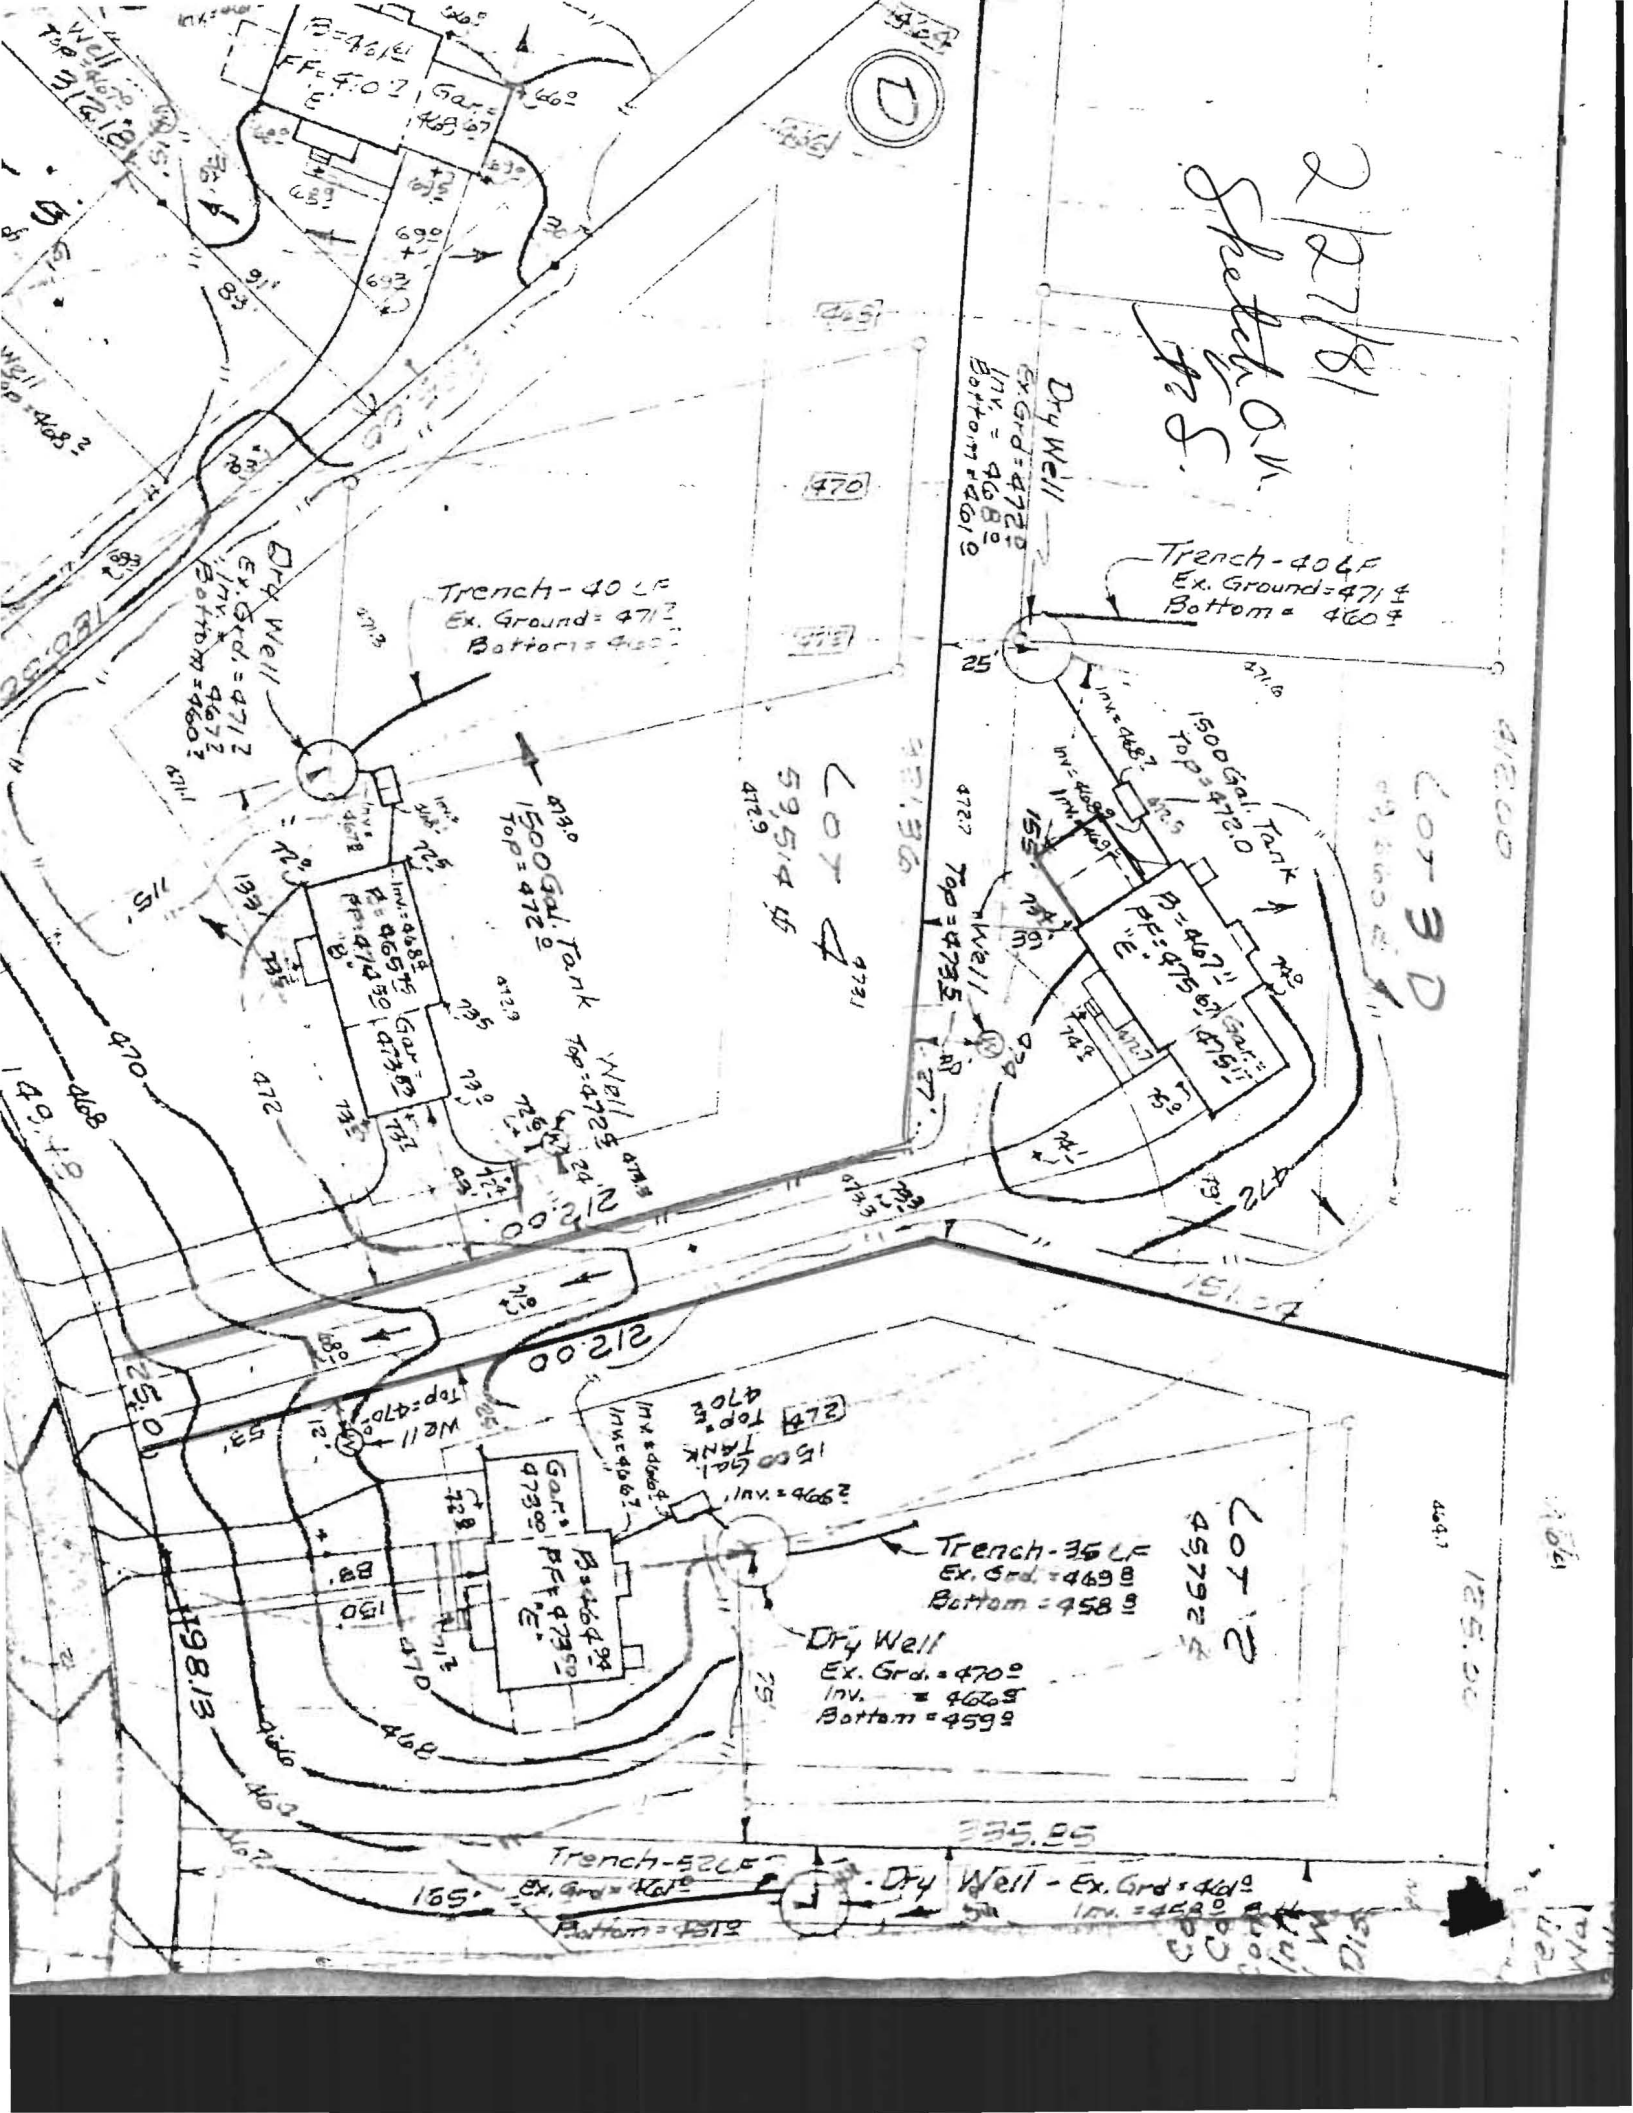

Trench-40 LF
Ex. Ground=471.2
Bottom=460.2

Trench-40 LF
Ex. Ground=471.4
Bottom=460.7

LOT 4
59,514 sq ft

LOT 3D

LOT 12
45,792 sq ft

Trench-35 LF
Ex. Grd=469.8
Bottom=458.8

Dry Well
Ex. Grd.=470.0
Inv. = 466.8
Bottom = 459.8

Trench-52 LF
Ex. Grd=461.5
Bottom=451.2

Dry Well - Ex. Grd=469.8
Inv.=468.8
Bottom=459.8