

APPLICATION

A 24521

SEWAGE DISPOSAL TESTING

P _____

STATE OF MARYLAND - DEPARTMENT OF HEALTH AND MENTAL HYGIENE

HOWARD COUNTY HEALTH DEPARTMENT
ENVIRONMENTAL HEALTH SERVICES
P. O. BOX 476, ELLICOTT CITY, MARYLAND 21043
TELEPHONE: 465-5000, EXT. 356

DISTRICT 5

DATE 3-15-76

max depth of system 11 ft

BLDG. PERMIT SIGNED
AND RETURNED 3/18/81
Serial # 45767

TO: THE COUNTY HEALTH OFFICER
ELLICOTT CITY, MARYLAND

I, HEREBY, APPLY FOR THE NECESSARY TEST IN ORDER TO CONSTRUCT (OR RECONSTRUCT) A SEWAGE DISPOSAL SYSTEM.

PROPERTY OWNER Henry Dryfoos, III F.G. Markow Inc.

ADDRESS 4701 Sangamore Road, Washington, D. C. 20016 PHONE 229-5052 459-5386
*5900 Princess Garden Way
Lanham, Md 20801*

PROPERTY LOCATION:

SUBDIVISION Flamewood LOT NO. NEW LOT 3-D
5, BLOCK D

ROAD AND DESCRIPTION 7512 Flamewood Dr.

SIZE OF LOT 52,700 TYPE BLDG. 4 Bedrooms
NUMBER OF BEDROOMS

IF NOT SINGLE RESIDENCE DESCRIBE _____

THE SYSTEM INSTALLED UNDER THIS APPLICATION IS ACCEPTABLE ONLY UNTIL PUBLIC FACILITIES BECOME AVAILABLE.

SIGNATURE OF APPLICANT Henry Dryfoos III

APPROVED BY Walter H. Zapp FOR DW G. Howard DATE 1/10/78
(KIND OF SYSTEM)

REJECTED BY _____ FOR _____ DATE _____
(KIND OF SYSTEM)


HOLD PENDING FURTHER TESTS _____ DATE _____

REASONS FOR REJECTION OR HOLDING _____

THIS IS NOT A PERMIT

unnamed Rd

lot 5
D

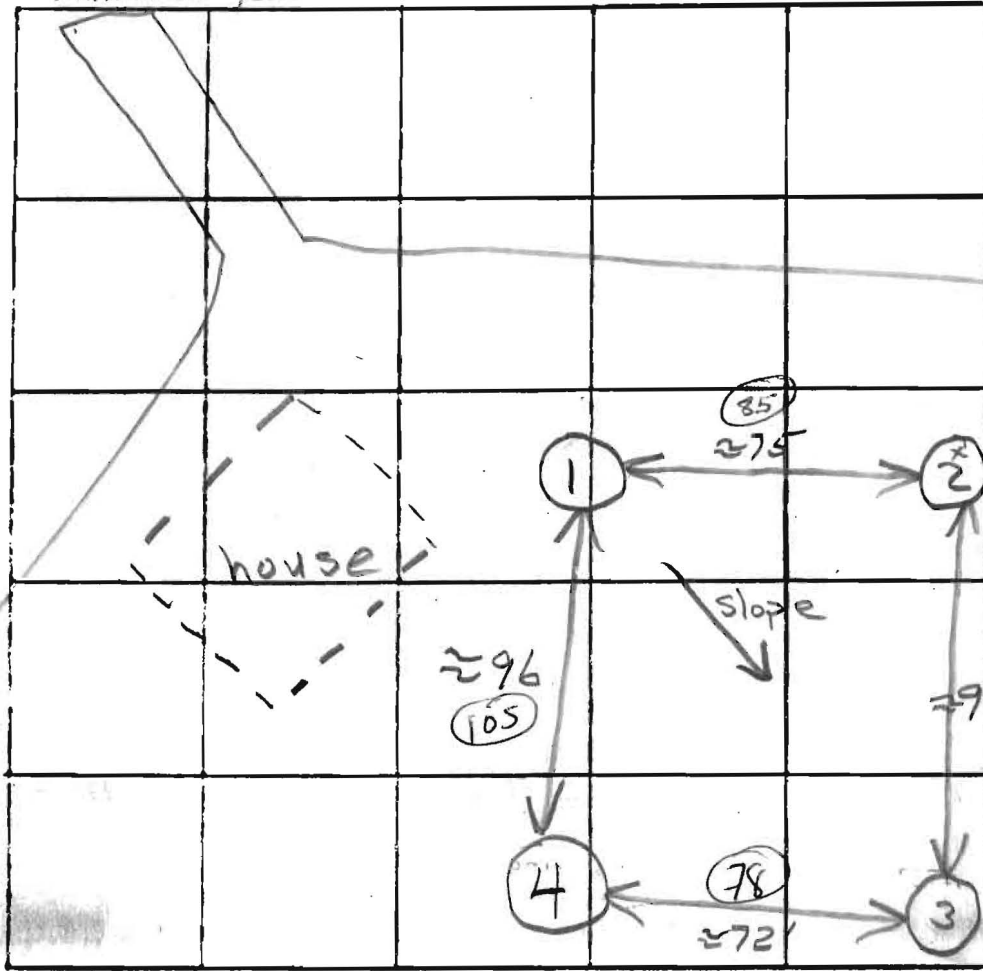

INDICATE NORTH - NAME ADJOINING ROADWAY AS BASE LINE.

DATE	TEST NO.	DEPTH	PRE-WET		TEST - 1" DROP		TIME	
			START	STOP	START	STOP		
4/23/76	1 ^s	7	10:42	10:47	10:47	10:57	10	
	1 ^d	13	10:42	10:47	10:47	10:52	5	
	2 ^{SA}	6.5	10:50	1X	Y	Failed		
	2 ^d	13	10:47	10:53	10:53	10:55	2	
	3 ^s	6.5'	10:40	10:47	10:47	10:50	3	
	3 ^d	13'	10:48	10:47	10:47	10:51	4	
	4 ^U	13	similar soil - dry					
4/23/76	2 ^{SB}	7.5'	11:10	11:21	11:21	11:35	14	

REMARKS

see plat for additional info
② & ③ same level

TYPE OF SOIL

SANDY - MICH

TESTED BY

hal benson - RH

ALSO PRESENT:

Fyock & Barnes

high
EST

LOW

LOW

NEXT HIGH