

APPLICATION

SEWAGE DISPOSAL TESTING

MARYLAND STATE DEPARTMENT OF HEALTH

HOWARD COUNTY

ELLICOTT CITY

DISTRICT 5th

DATE 309 1972

A 17505
P _____

TO: THE COUNTY HEALTH OFFICER
ELLICOTT CITY, MARYLAND

I, HEREBY, APPLY FOR THE NECESSARY TESTS IN ORDER TO CONSTRUCT OR RECONSTRUCT A SEWAGE DISPOSAL SYSTEM.

PROPERTY OWNER Pharm One, Ltd.

ADDRESS White Life Center, Columbia, Md PHONE 730-8500

PROPERTY LOCATION:

SUBDIVISION Adjacent to Clarksville Ridge LOT NO. 7

ROAD AND DESCRIPTION Intersection of 32 & Whitgate Lane

OCCUPANT _____ PHONE _____

PERSON TO CONSTRUCT SYSTEM _____

ADDRESS _____ PHONE _____

SIZE OF LOT 3 ACRES ± TYPE BLDG. 4 PERSONS BLDG.

IF NOT SINGLE RESIDENCE DESCRIBE _____

SIGNATURE OF APPLICANT *Alan C. Borg*

Alan C. Borg, Pres.

APPROVED BY _____ FOR _____ DATE _____


REJECTED BY _____ FOR _____ DATE _____

HOLD PENDING FURTHER TESTS _____ DATE _____

REASONS FOR REJECTION OR HOLDING _____

THIS IS NOT A PERMIT

21630

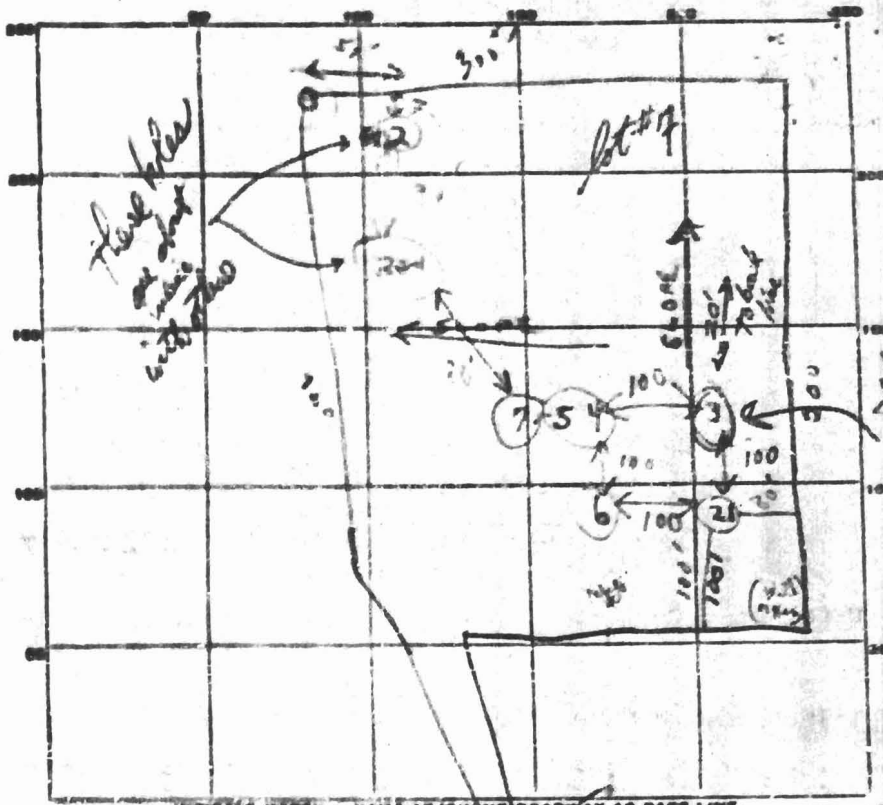

3000

INDICATE NORTH - MAKE ADJACENT ROADWAY AS BASE LINE

RT 32

287

DATE	TEST NO	DEPTH	PRE-WET		TEST - 1" DROP		TIME	
			START	STOP	START	STOP		
10/12/72	1	12 ft	11 27	11 30	11 30	11 34	4 min	
	2	3 ft	11 27	11 29	11 29	11 32	3 min	
	3	12 ft	Level level					
	4	3'	34	Full pay & lower shaft for 10/13/72 Test				main depth
	5	12'	350	352	352	358	6 min	
	6	11 ft	Level level					4 ft
10/13/72	7	6 ft	11 14	11 17	11 17	11 22	5 min	

main depth
4 ft
any test 3
5 min

SOIL AUGER FINDING

Design System 4 in 112

TESTED BY BS Breaker - partial only RT completed

REMARKS

287
7