

4/4/83 App'd J.S.

4/4/83

PERMIT

P 32583

A 31062

SEWAGE DISPOSAL SYSTEM

MARYLAND STATE DEPARTMENT OF HEALTH*

HOWARD COUNTY
BUREAU OF ENVIRONMENTAL HEALTH
992-2330

ELLICOTT CITY
DISTRICT 5th

DATE 3/23/83

INDEX

Thomas H. Simpson _____ IS PERMITTED TO INSTALL ALTER _____

ADDRESS 5300 Green Bridge Road, Dayton, Md. 21036 PHONE 988-9689

SUBDIVISION _____ ROAD 5250 Greenbridge Road LOT _____

PROPERTY OWNER Thomas H. Simpson

ADDRESS 5300 Green Bridge Road, Dayton, Md. 21036

IF GARBAGE GRINDER IS USED INCREASE SEPTIC TANK CAPACITY BY 50% AND ABSORPTION AREA BY 22%.

GARBAGE GRINDER? YES _____ NO

SEPTIC TANK CAPACITY 1000 GALLONS NUMBER OF BEDROOMS 3

DRY WELL OR DRY WELL AND TRENCH - 130 sq. ft. per bedroom. Inlet at 3-4 ft. below original grade. Maximum depth 10 ft. below original grade. Effective depth at 3 ft. below original grade. If trench is used to make absorbent sidewall area, run trench on ~~contour~~ contour and leave a 5 ft. earth buffer between dry well and trench. No trench to exceed 100 ft. in length. Trench inlet to be same as dry well with 7 ft. of stone below inlet pipe. Locate the dry well 155 ft. from the edge of Greenbridge Road and 110 ft. from the fence adjacent to the left ~~XXXXXXXXXX~~ property line, as seen when facing the lot from Greenbridge Road.

PLANS APPROVED BY Steve Kiel & Frank A. Skinner DATE 8/12/10/80 & 10/21/81

COVER NO WORK UNTIL INSPECTED AND APPROVED.

NEITHER THE HOWARD COUNTY COUNCIL NOR THE HEALTH DEPARTMENT IS RESPONSIBLE FOR THE SUCCESSFUL OPERATION OF ANY SYSTEM.

NOTE: IF TRENCH IS USED CALL FOR INSPECTION BEFORE AND AFTER PLACING GRAVEL IN TRENCH.

NOTE: NO DRY WELL SHALL EXCEED 15 FOOT IN DIAMETER. NO ABSORPTION TRENCH TO EXCEED 100 FEET IN LENGTH.

NOTE: ALL PIPE FROM HOUSE TO SEPTIC TANK MUST BE CAST IRON OR SCHEDULE 40 PVC OR ABS.

PERMIT VOID AFTER THREE YEARS.


NOTE: INSTALL STAND PIPE ON SEPTIC TANK AND DRY WELL. STAND PIPES MUST BE 6 INCHES IN DIAMETER. CAST IRON, CONCRETE OR TERRA COTTA, OR PVC OR ABS ACCEPTED. IF TOP OF SEPTIC TANK IS DEEPER THAN 3 FEET MANHOLE TO GRADE REQUIRED.

BLDG. PERMITS SIGNED AND RETURNED 11/3/80
B00127104 Deck
31062

***INSTALLER IS RESPONSIBLE FOR OBTAINING FINAL APROVAL ON THIS PERMIT**

*CALL 992-2330 FOR INSPECTION OF SEPTIC SYSTEMS.

EH - 2-1082

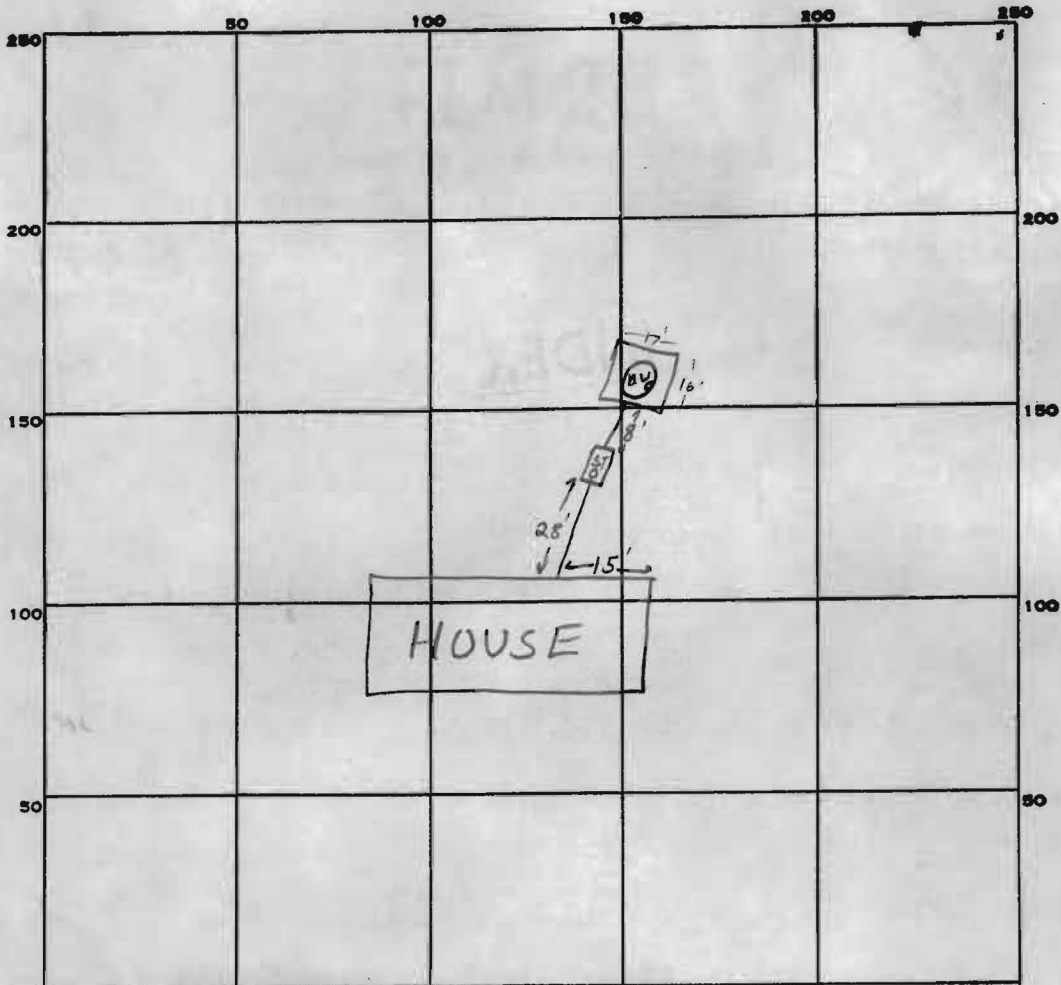

INDICATE NORTH. - NAME ADJOINING ROADWAY AS BASE LINE.

Green Bridge Rd.

PERMIT CARD ✓ signed final OK F.S.

SEPTIC TANK, LEVEL ✓

CLEANOUTS

S.T.	D.W.
✓	✓

DISTRIBUTION BOX, LEVEL n.a.

TILE FIELD, DEPTH _____ FT. TRENCH WIDTH _____ FT.

1 x 17

GRAVEL DEPTH _____ IN. TOTAL LENGTH _____ FT.

NUMBER OF TRENCHES _____ TOTAL BOTTOM AREA _____

66

SEEPAGE PITS, ^{OUTSIDE PERIMETER} INSIDE DIAMETER 66 FT. DEPTH BELOW INLET 7 FT.

ABSORBENT AREA ± 420 SQ. FT.

REMARKS 4/4/83 Ok. to cover all work

DATE SYSTEM APPROVED

4/4/83

INSPECTOR

G. Skinner