

# APPLICATION

SEWAGE DISPOSAL TESTING

STATE OF MARYLAND - DEPARTMENT OF HEALTH AND MENTAL HYGIENE

A 3/062  
P \_\_\_\_\_

HOWARD COUNTY HEALTH DEPARTMENT  
ENVIRONMENTAL HEALTH SERVICES  
P.O. BOX 476 ELLICOTT, MARYLAND 21043  
TELEPHONE: 992-2330

DISTRICT 5<sup>th</sup>  
DATE Dec 1, 1980

TO: THE COUNTY HEALTH OFFICER  
ELLICOTT CITY, MARYLAND

BLDG. PERMIT SIGNED  
AND RETURNED 10/2/81  
Serial # 47947

I HEREBY APPLY FOR THE NECESSARY TEST IN ORDER TO CONSTRUCT (OR RECONSTRUCT) A SEWAGE DISPOSAL SYSTEM.

PROPERTY OWNER Thomas H. Simpson  
ADDRESS 5300 Greenbridge Rd Dayton PHONE 988-9689

PROPERTY LOCATION:

SUBDIVISION \_\_\_\_\_ LOT NO. \_\_\_\_\_  
ROAD AND DESCRIPTION 5250 Greenbridge Rd Wooded lot 1/2 mile North of TRIDELPHIA

SIZE OF LOT 2.130 acres TYPE BLDG. House

THE SYSTEM INSTALLED UNDER THIS APPLICATION IS ACCEPTABLE ONLY UNTIL PUBLIC FACILITIES BECOME AVAILABLE.

I FULLY UNDERSTAND THE FEE CONNECTED WITH THE FILING OF THIS PERC TEST APPLICATION IS NON-REFUNDABLE UNDER

ANY CIRCUMSTANCES.

SIGNATURE OF APPLICANT Thomas H. Simpson


APPROVED BY \_\_\_\_\_ FOR \_\_\_\_\_ DATE \_\_\_\_\_

REJECTED BY \_\_\_\_\_ FOR \_\_\_\_\_ DATE \_\_\_\_\_

HOLD PENDING FURTHER TESTS \_\_\_\_\_ DATE \_\_\_\_\_

REASONS FOR REJECTION OR HOLDING \_\_\_\_\_

# THIS IS NOT A PERMIT

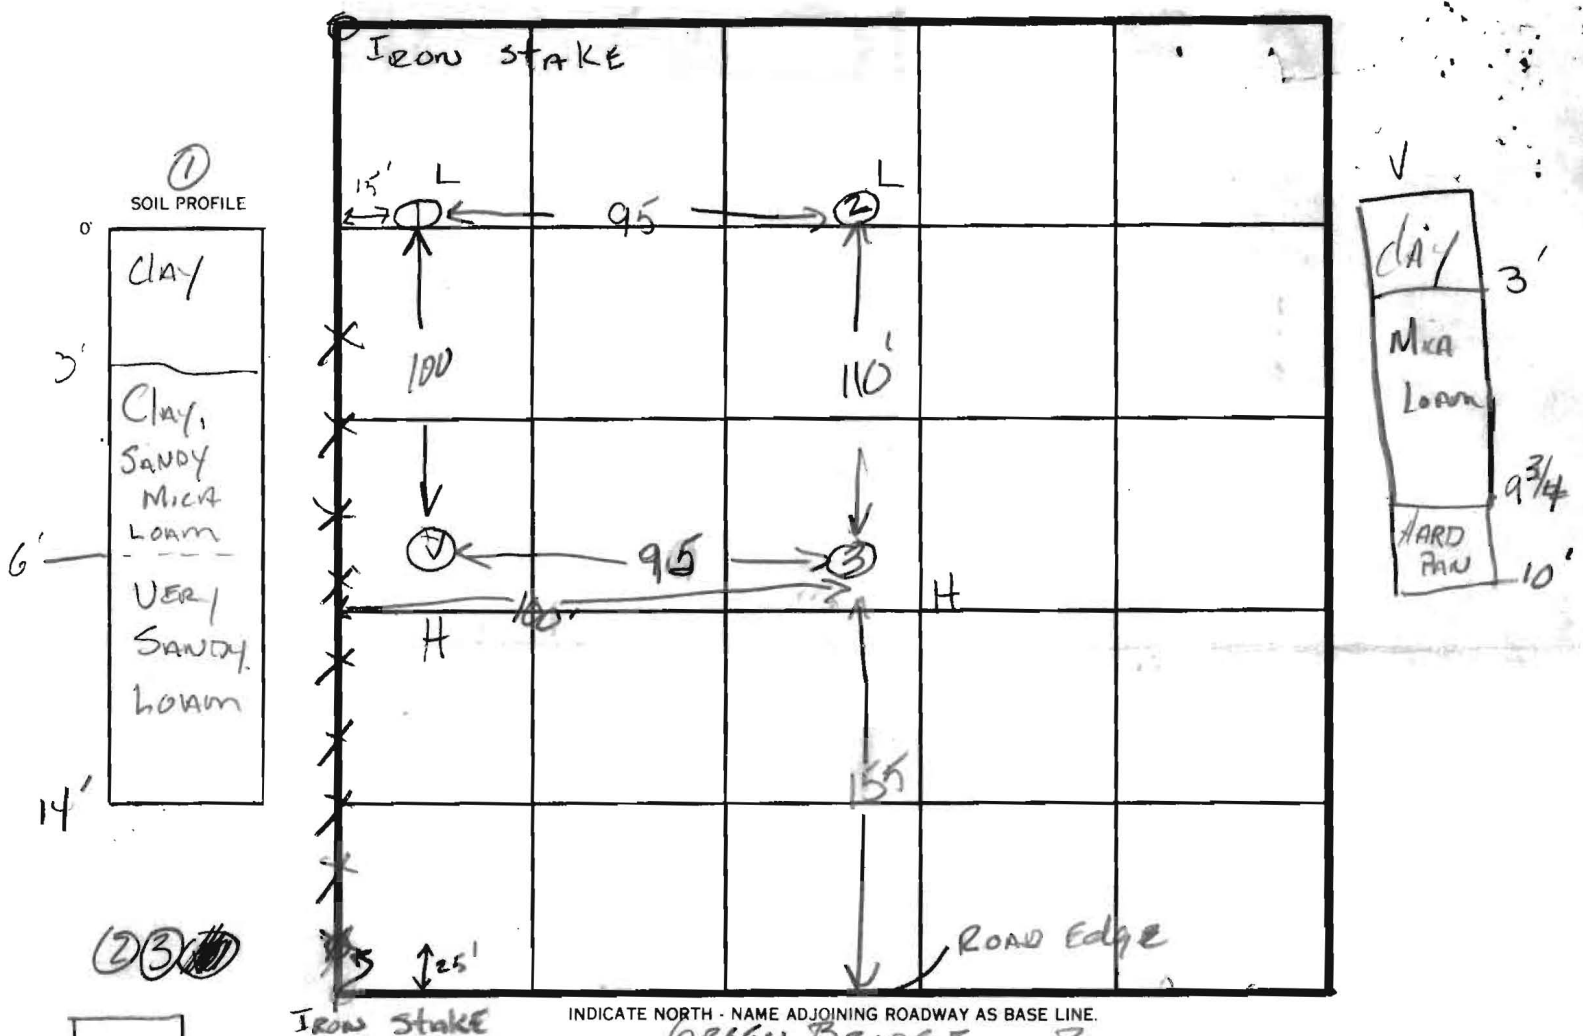

INDICATE NORTH - NAME ADJOINING ROADWAY AS BASE LINE.  
 IRON STAKE GREEN BRIDGE RD

DATE	TEST NO.	DEPTH	PRE-WET		TEST - 1" DROP		TIME
			START	STOP	START	STOP	
12-8-80	1s	3	1:24	1:27	1:27	1:35	8
	1D	12	1:24	1:27	1:27	1:33	6
	2s	3	1:27	1:28	1:28	1:29	11
	2D	12	1:27	1:29	1:29	1:36	7
	3s	3'	1:38	1:41	1:41	1:50	9
	3D	13'	1:38	1:40	1:40	1:45	5
	✓	10'	Hard Pan		Bottom		

\* Dug ① to 14'  
 \* Dug ③ to 14'

REMARKS WOODED lot high holes same ELEVATION

TYPE OF SOIL \_\_\_\_\_

TESTED BY SK 12/8/80 ALSO PRESENT J. Flock  
SKIP