

CT 4864 SEQUENCE NO. (WRA USE ONLY)

STATE OF MARYLAND WELL COMPLETION REPORT

THIS REPORT MUST BE SUBMITTED WITHIN 30 DAYS AFTER WELL IS COMPLETED

Date Received (WRA use only) 3/19/81 DATE WELL COMPLETED

Depth of Well 300 (TO NEAREST FOOT)

PERMIT NO. FROM "PERMIT TO DRILL WELL" 40-73-3792

OWNER Simpson last name Thomas first name Greenbridge Road TOWN Dayton

WELL LOG table with columns: DESCRIPTION, FEET FROM, FEET TO, Check if water bearing. Includes entries for Top Soil, Clay, Shale, Mica, Sandstone, Mica, Flint, Mica.

GROUTING RECORD. WELL HAS BEEN GROUTED (Y). TYPE OF GROUTING MATERIAL: CEMENT CM, BENTONITE CLAY BC. NO. OF BAGS 9, NO. OF POUNDS 700.

CASING RECORD. MAIN CASING TYPE: ST (STEEL). Nominal diameter 6 inch, Total depth 34 feet.

OTHER CASING (if used) table with columns for diameter and depth.

SCREEN RECORD. screen type or openhole: HO (OPEN HOLE). SLOT SIZE 2.

DEPTH (nearest ft.) table with columns for casing and screen depths.

CIRCLE APPROPRIATE BOX. A A WELL WAS ABANDONED AND SEALED WHEN THIS WELL WAS COMPLETED.

I HEREBY CERTIFY THAT I HAVE COMPLIED WITH ALL CONDITIONS STATED ON THE ABOVE-CAPTIONED "PERMIT TO DRILL WELL"...

DRILLERS IDENT. NO. 40. DRILLERS SIGNATURE: [Signature]


GRAVEL PACK IF WELL DRILLED WAS FLOWING WELL CIRCLE BOX (F).

WRA USE ONLY (NOT TO BE FILLED IN BY DRILLER). T (E.R.O.S.), W Q (74, 75, 76), TELESCOPE CASING, LOG INDICATOR, OTHER DATA.

PUMPING TEST. C 3 (seq no). HOURS PUMPED 2. PUMPING RATE 2 gal. per min. METHOD USED TO MEASURE PUMPING RATE BUCKET. WATER LEVEL BEFORE PUMPING 40, WHEN PUMPING 300. TYPE OF PUMP USED (for test) A air.

PUMP INSTALLED YES NO. DRILLER WILL INSTALL PUMP (Y). IF DRILLER INSTALLS PUMP, THIS SECTION MUST BE COMPLETED FOR ALL WELLS EXCEPT HOME USE. TYPE OF PUMP (WRITE APPROPRIATE LETTER IN BOX - SEE ABOVE: (A, C, J, P, R, S, T, O)). CAPACITY: GALLONS PER MINUTE (to nearest gallon) 31-35. PUMP HORSE POWER 37-41. PUMP COLUMN LENGTH (nearest ft) 43-47.

LOCATION OF WELL ON LOT. SHOW PERMANENT STRUCTURE SUCH AS BUILDING, SEPTIC TANKS, AND/OR LANDMARKS AND INDICATE NOT LESS THAN TWO DISTANCES (MEASUREMENTS TO WELL). GREENBRIDGE RD.

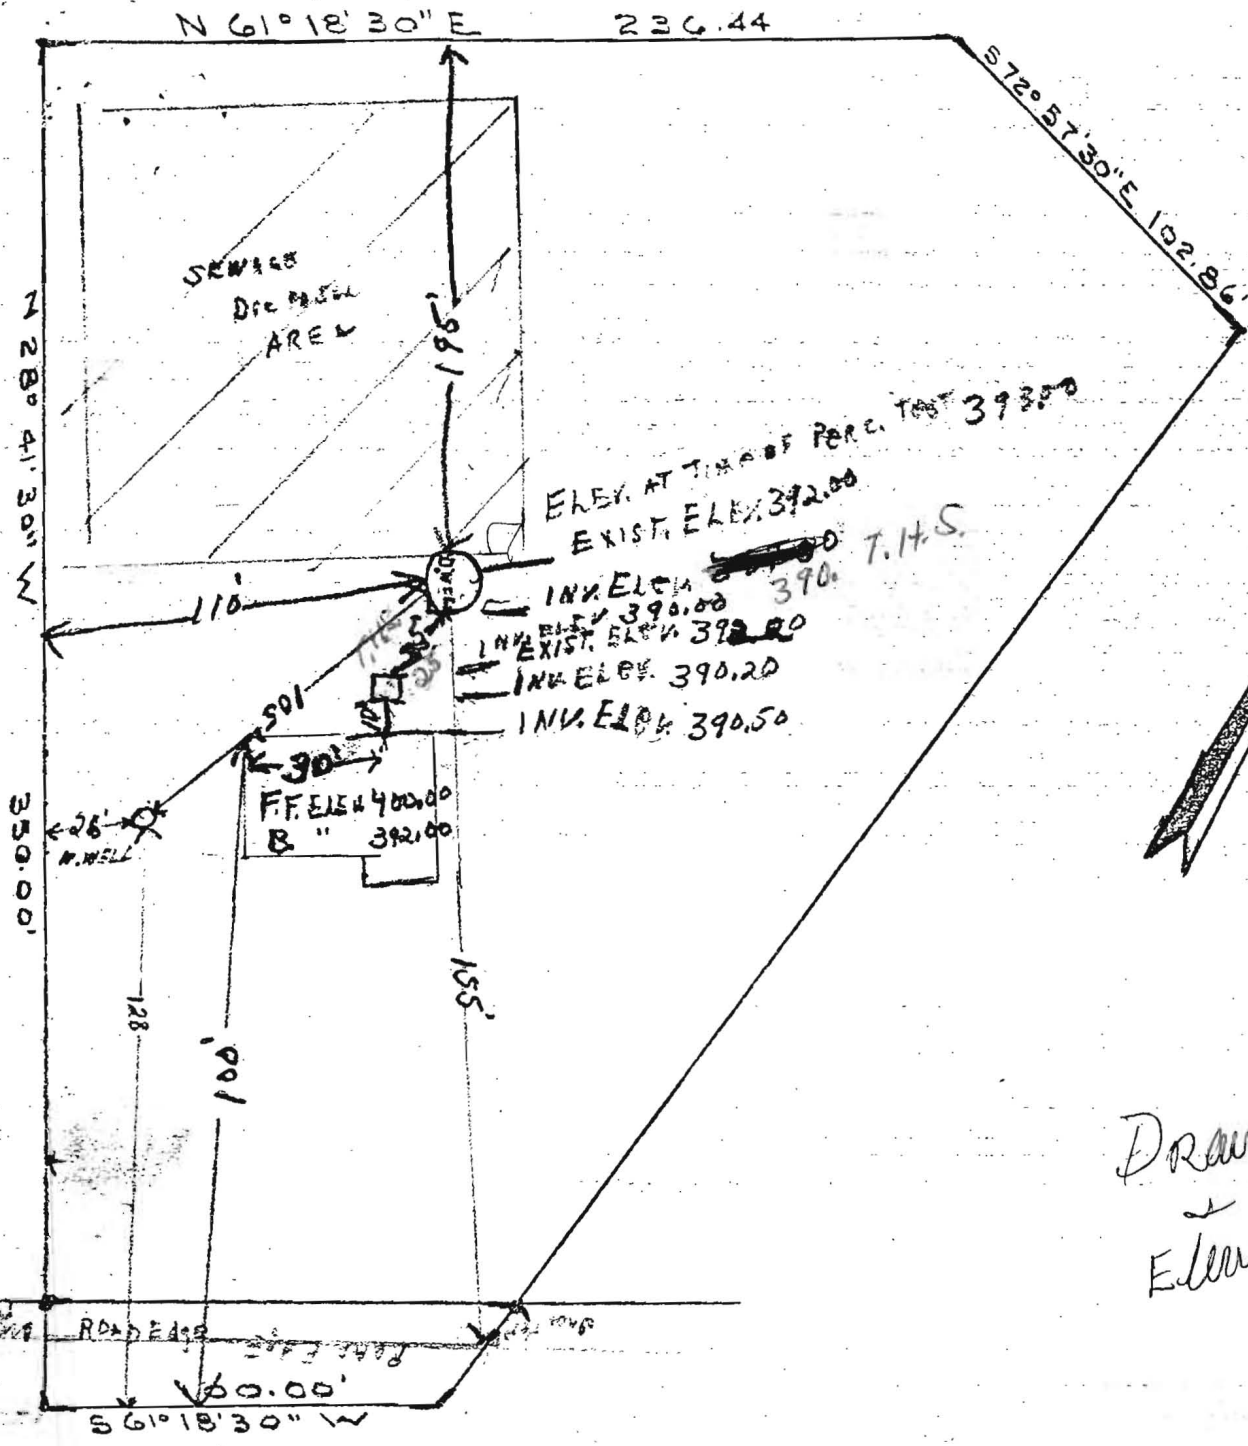

ELEV. AT TIME OF PERM. TEST 393.50
 EXIST. ELEV. 392.00

IN. ELEV. ~~390.00~~ 390.00
 IN. EXIST. ELEV. 392.00
 IN. ELEV. 390.20
 IN. ELEV. 390.50



FF. ELEV. 400.00
 B. 392.00

Drawney
 Elevations
 OK
 10/21/81
 SK

Green's Bridge Road
 To Dayton →

I CERTIFY THE ABOVE MEASUREMENTS AND
 ELEVATIONS ARE ACTUAL AND CORRECT
 FOR THIS PROPERTY

Thomas H. Simpson
 OWNER

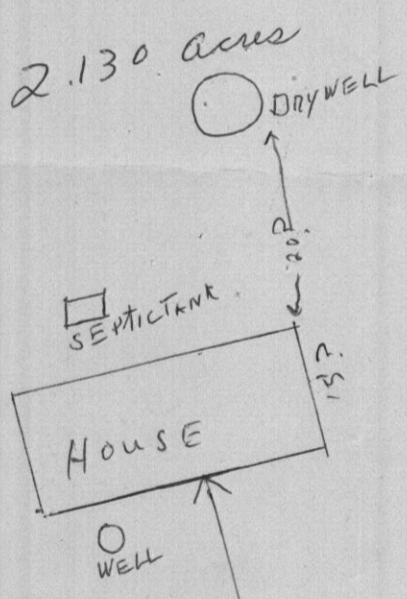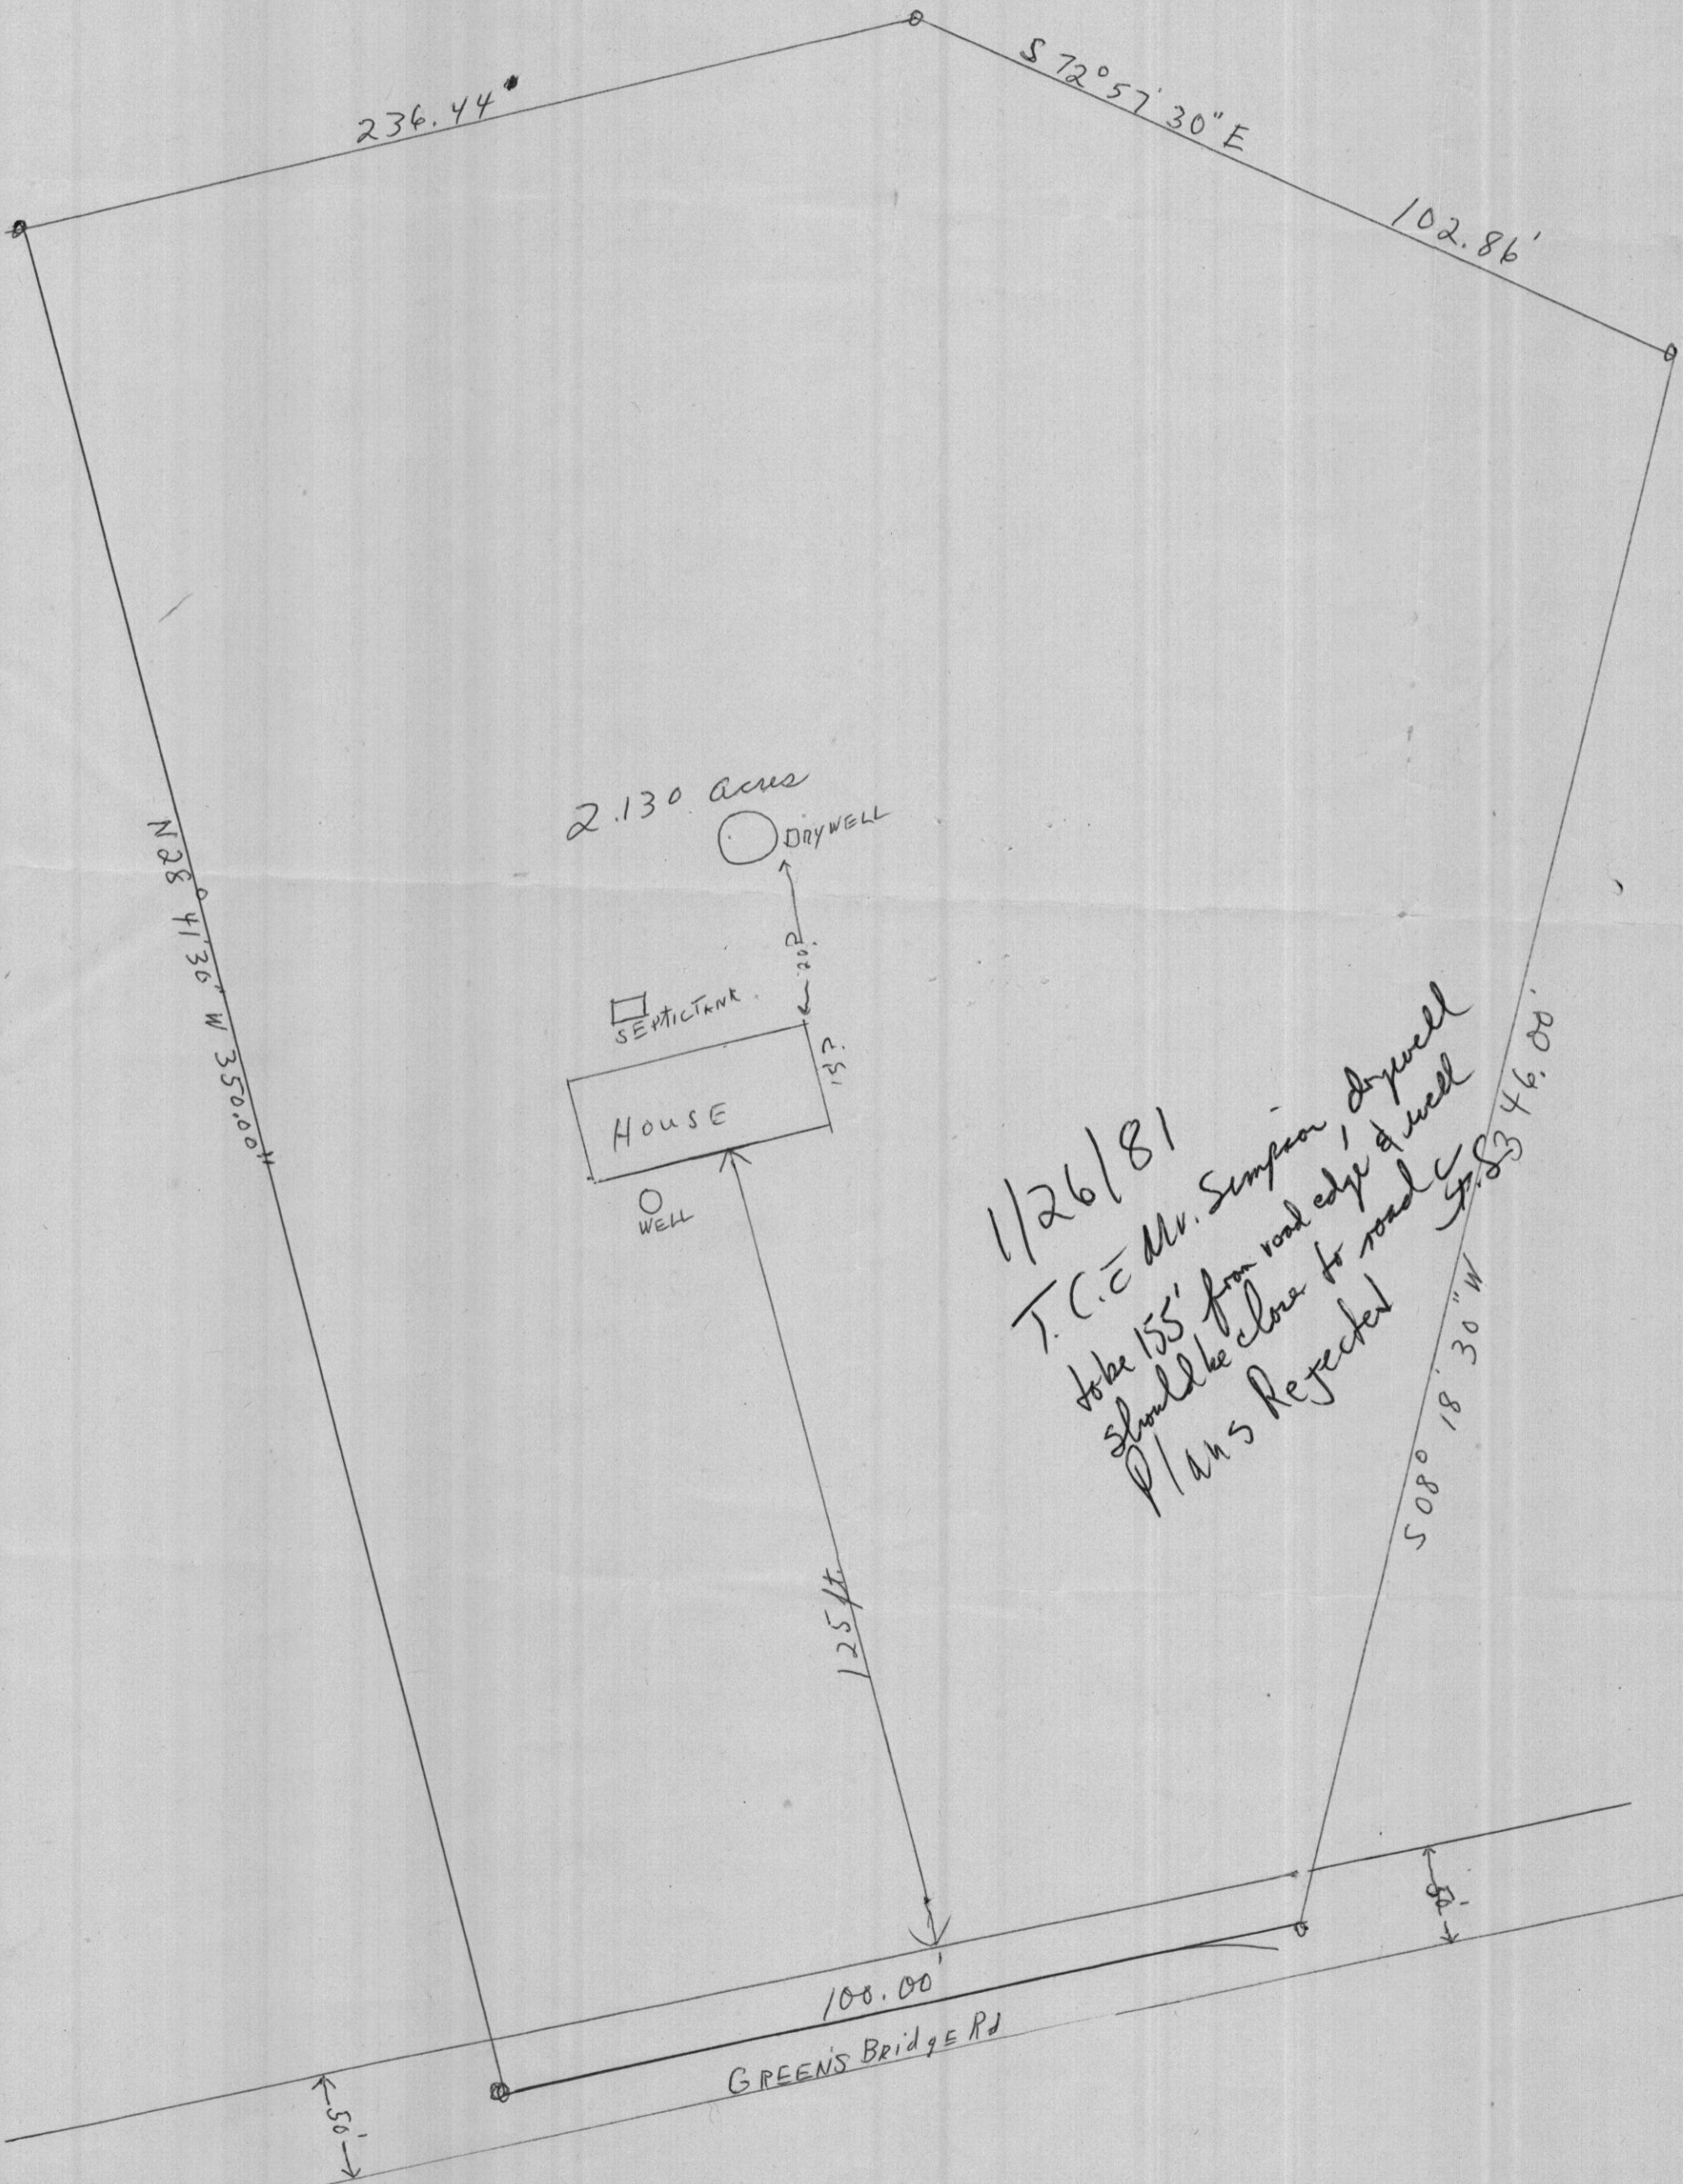

1/26/81
 T.C.E. Mr. Simpson, Drywell
 to be 155' from road edge & well
 should be close to road
 Plans Rejected
 G.S.B. 46.00

GREENS BRIDGE RD