


A#06446

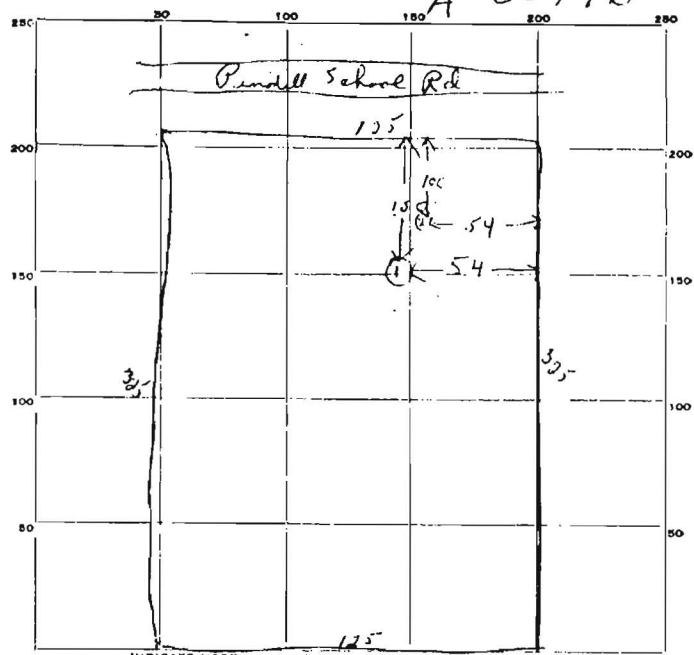

INDICATE NORTH - NAME ADJOINING ROADWAY AS BASE LINE.
Cherry Tree Drive

DATE	TEST NO.	DEPTH	PRE-WET		TEST - 1" DROP		TIME
			START	STOP	START	STOP	
3/28/63	1	9'	203	212	212	222	10 min
	2	9'	214	217	217	227	10 min

SOIL AUGER FINDING few siltily, the good ground

TESTED BY Jim M. 3/28/63

REMARKS _____

ALSO PRESENT A. J. H. A. and 6 A