

Att. Judy

2 pages

4-30-63

PERMIT

P 06668
A 06446

SEWAGE DISPOSAL SYSTEM

MARYLAND STATE DEPARTMENT OF HEALTH

HOWARD COUNTY

ELLICOTT CITY

INDEXED

INDEXED

DISTRICT _____

DATE 4/24/63

Elwood Scaggs

IS PERMITTED TO INSTALL _____ ALTER _____

ADDRESS _____ PHONE _____

A SEWAGE DISPOSAL SYSTEM LOCATED AT _____

SUBDIVISION Moosefield ROAD 734 Cherry Tree Rd. LOT 6 A

PROPERTY OWNER _____

ADDRESS _____

SPECIFICATIONS

DRAIN FIELD _____ DEPTH _____ FEET, BOTTOM AREA _____ SQ. FT.

SEEPAGE PITS X ABSORBENT SIDE-WALL AREA 400 SQ. FT. below inlet (first 3' of original grade not to be included in sidewall area.)
SEPTIC TANK CAPACITY 1,000 GALLONS

FOR GARBAGE GRINDER, INCREASE DISPOSAL AREA 22% & TANK CAPACITY 50%.
changed 4/26/63 dma


OTHER Place dry well 140 & to 160 ft. from rear lot line and 50 to 55 ft. from right sideline or 90 to 110 ft. from rear sideline. Rear lotline determined as you face lot from Cherry Tree Dr.

PLANS APPROVED BY DW Monaghan DATE 3/28/63

FILL SEPTIC TANK AND DISTRIBUTION BOX WITH WATER BEFORE CALLING FOR AN INSPECTION. COVER NO WORK UNTIL INSPECTED AND APPROVED.

NEITHER THE HOWARD COUNTY COMMISSIONERS NOR THE HEALTH DEPARTMENT IS RESPONSIBLE FOR THE SUCCESSFUL OPERATION OF ANY SYSTEM.

A
06446

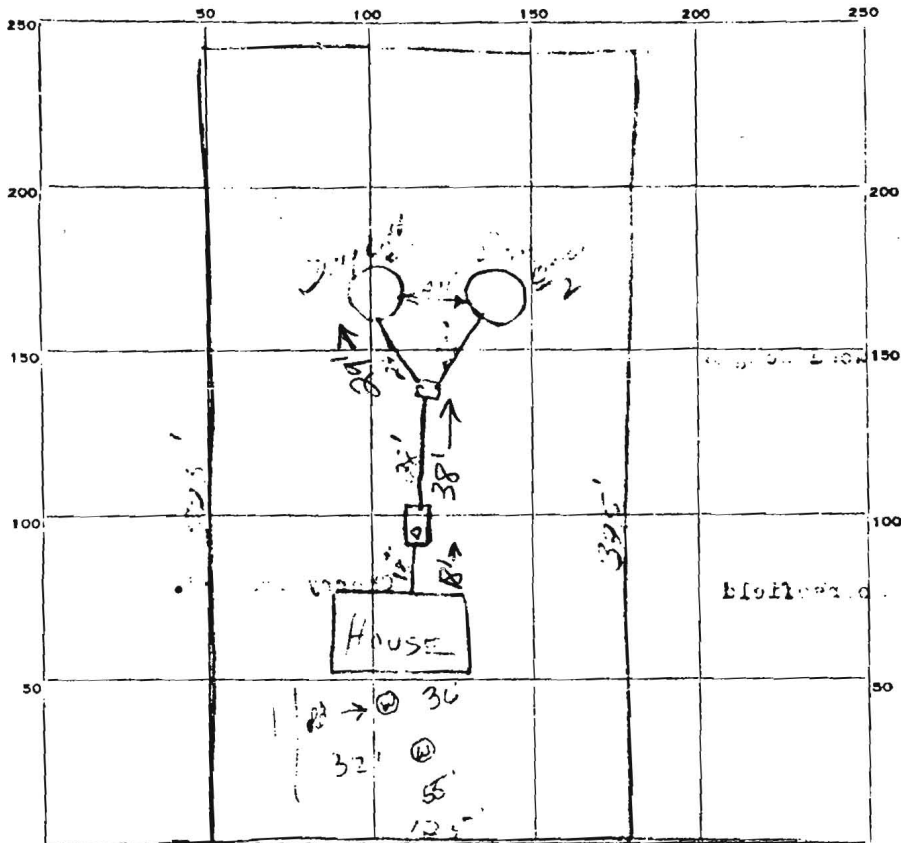

INDICATE NORTH - NAME ADJOINING ROADWAY AS BASE LINE.

PERMIT CARD 100001 C. MERRY TREE DRIVE

SEPTIC TANK, LEVEL 100001 CLEANOUTS 1/10

DISTRIBUTION BOX, LEVEL 100001

TILE FIELD, DEPTH 2 FT. TRENCH WIDTH 12 FT. ALL OF 10 TO 12 IN. 12 IN.

GRAVEL DEPTH 6 IN. TOTAL LENGTH 12 FT. ALL OF 10 TO 12 IN. 12 IN.

NUMBER OF TRENCHES 2 TOTAL BOTTOM AREA 288

SEEPAGE PITS, INSIDE DIAMETER 8 FT. DEPTH BELOW INLET 3 FT.

ABSORBENT AREA 288 SQ. FT.

REMARKS 1. 12\"/>

DATE SYSTEM APPROVED 1/30/62 INSPECTOR [Signature]