

APPLICATION

PERCOLATION TESTING

56429M
A ~~56429~~
P _____

HOWARD COUNTY HEALTH DEPARTMENT
BUREAU OF ENVIRONMENTAL HEALTH
3525-H ELLICOTT MILLS DRIVE/ELLICOTT CITY, MARYLAND 21043
TELEPHONE: 313-2840

DISTRICT _____
DATE 4/11/96

TO: THE COUNTY HEALTH OFFICER
ELLICOTT CITY, MARYLAND

I HEREBY APPLY FOR THE NECESSARY TEST PRIOR TO APPLICATION FOR PERMIT TO CONSTRUCT (OR RECONSTRUCT) A SEWAGE DISPOSAL SYSTEM.

PROPERTY OWNER J Thomas Scrivener NV HOMES

ADDRESS c/o Land Design & Development PHONE 410 740 5176

AGENT OR PROSPECTIVE BUYER Donald R. Renner Jr

ADDRESS 10805 Hickory Ridge Rd PHONE _____
21044

PROPERTY LOCATION:

SUBDIVISION _____ LOT NO. 25

ROAD AND DESCRIPTION (11020 Hidden Fox Court)

TAX MAP 29 PARCEL # 21
BLDG. PERMIT SIGNED AND RETURNED 10-26-98
Serial # B00114778

SIZE OF LOT 1+ Acres TYPE BLDG. SFD-4Bm
(SINGLE FAMILY DWELLING OR COMMERCIAL)

THE SYSTEM INSTALLED UNDER THIS APPLICATION IS ACCEPTABLE ONLY UNTIL PUBLIC FACILITIES BECOME AVAILABLE. I FULLY UNDERSTAND THE FEE CONNECTED WITH THE FILING OF THIS PERC TEST APPLICATION IS NON-REFUNDABLE UNDER ANY CIRCUMSTANCES. I ALSO AGREE TO COMPLY WITH ALL M.O.S.H.A. REQUIREMENTS IN TESTING THIS LOT.
Don R Renner Jr
(SIGNATURE OF APPLICANT)

APPROVED BY _____ FOR _____ DATE _____

DISAPPROVED BY _____ FOR _____ DATE _____

HOLD PENDING FURTHER TESTS _____

REASONS FOR REJECTION OR HOLDING _____

PERCOLATION TEST PLAT/PRELIMINARY PLAT - TITLE OR I.D. # _____ DATE _____

SITE DEVELOPMENT PLAN/FINAL PLAT - TITLE OR I.D. # _____ DATE _____

THIS IS NOT A PERMIT

56429M

COUNTY #

SOIL PROFILE

0' 63

TOPSOIL

ORANGE SANDY CLAY LOAM

30% ROCK SANDY LOAM


3' BAND OF COARSE SAND @ 4'

Rock 8 CIA

TOPSOIL 1'

RED BROWN HEAVY SILT LOAM

DARK BROWN MICACEOUS SILT LOAM

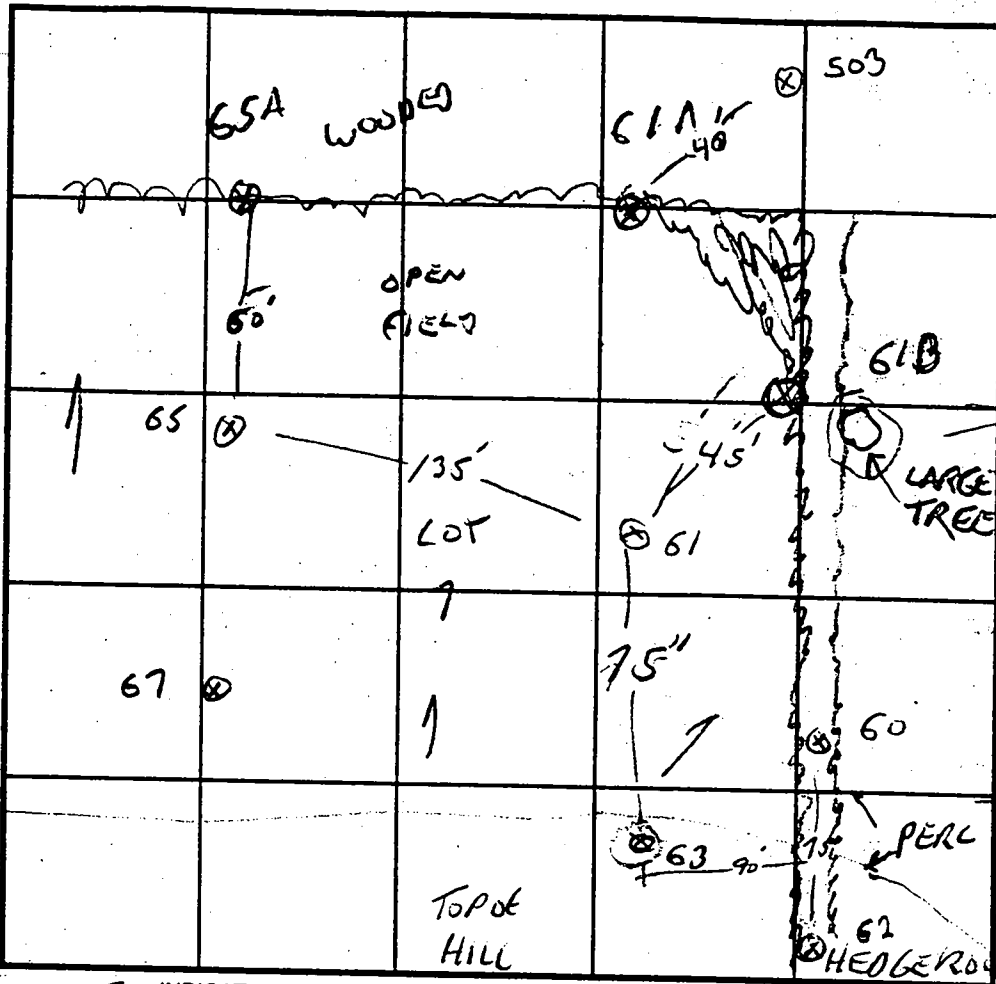

SOIL PROFILE

0' 61

TOPSOIL

ORANGE SANDY CLAY LOAM

BROWN SANDY MICACEOUS LOAM

1/8% Rock

← INDICATE NORTH - NAME ADJOINING ROADWAY AS BASE LINE.

DATE	TEST NO.	DEPTH	PRE-WET		TEST - 1" DROP		TIME	
			START	STOP	START	STOP		
4/11/96	67	5' 11"	SEE LOT 6 PROFILE					2 MIN
	65	4' 10 1/2"	"	"	"	"	2 MIN	
	61	4' 6" 11"	1:24	1:25	1:25	1:27	2 MIN	
	63	5' 8"	< 1 MIN					
	61A	4' 6" 11"	4:15	4:17	4:17	4:21	4 MIN	
	61B	5' 6" 11"	4:37	4:43	4:43	4:52	9 MIN	
8/7/96	503	4' 6" 11"	VISUAL OK TO 7'					

REMARKS LOT 7 (2 SHEETS) RECONFIRMATION

TYPE OF SOIL

TESTED BY G. SAUSAGE ALSO PRESENT M/

TRENCH DESIGN DATA: AVERAGE PERCOLATION TIME TRENCH WIDTH

INLET DEPTH MAXIMUM BOTTOM DEPTH SQ. FT./BEDROOM

APPLICATION

PERCOLATION TESTING

56429M
A ~~56429M~~
P _____

HOWARD COUNTY HEALTH DEPARTMENT
BUREAU OF ENVIRONMENTAL HEALTH
3525-H ELLICOTT MILLS DRIVE/ELLICOTT CITY, MARYLAND 21043
TELEPHONE: 313-2840

DISTRICT _____

DATE 4-1-96

TO: THE COUNTY HEALTH OFFICER
ELLICOTT CITY, MARYLAND

I HEREBY APPLY FOR THE NECESSARY TEST PRIOR TO APPLICATION FOR PERMIT TO CONSTRUCT (OR RECONSTRUCT) A SEWAGE DISPOSAL SYSTEM.

PROPERTY OWNER J Thomas Scrivener

ADDRESS c/o Land Design & Development PHONE 410 740 5176

AGENT OR PROSPECTIVE BUYER Donald R. Reuwer Jr

ADDRESS 10805 Hickory Ridge Rd PHONE _____
21044

PROPERTY LOCATION:

SUBDIVISION _____ LOT NO. 13

ROAD AND DESCRIPTION _____

TAX MAP 29 PARCEL # 21

SIZE OF LOT 1 + Acres TYPE BLDG. _____
(SINGLE FAMILY DWELLING OR COMMERCIAL)

THE SYSTEM INSTALLED UNDER THIS APPLICATION IS ACCEPTABLE ONLY UNTIL PUBLIC FACILITIES BECOME AVAILABLE. I FULLY UNDERSTAND THE FEE CONNECTED WITH THE FILING OF THIS PERC TEST APPLICATION IS NON-REFUNDABLE UNDER ANY CIRCUMSTANCES. I ALSO AGREE TO COMPLY WITH ALL M.O.S.H.A. REQUIREMENTS IN TESTING THIS LOT.

Donald R. Reuwer Jr
(SIGNATURE OF APPLICANT)

APPROVED BY _____ FOR _____ DATE _____

DISAPPROVED BY _____ FOR _____ DATE _____

HOLD PENDING FURTHER TESTS _____

REASONS FOR REJECTION OR HOLDING _____

PERCOLATION TEST PLAT/PRELIMINARY PLAT - TITLE OR I.D. # _____ DATE _____

SITE DEVELOPMENT PLAN/FINAL PLAT - TITLE OR I.D. # _____ DATE _____

THIS IS NOT A PERMIT

56429M

COUNTY #

SOIL PROFILE

TOPSOIL

ORANGE SANDY LOAM


10% COBBLE

SOIL PROFILE NOT CLEAR

60

3' 6"

11" 106

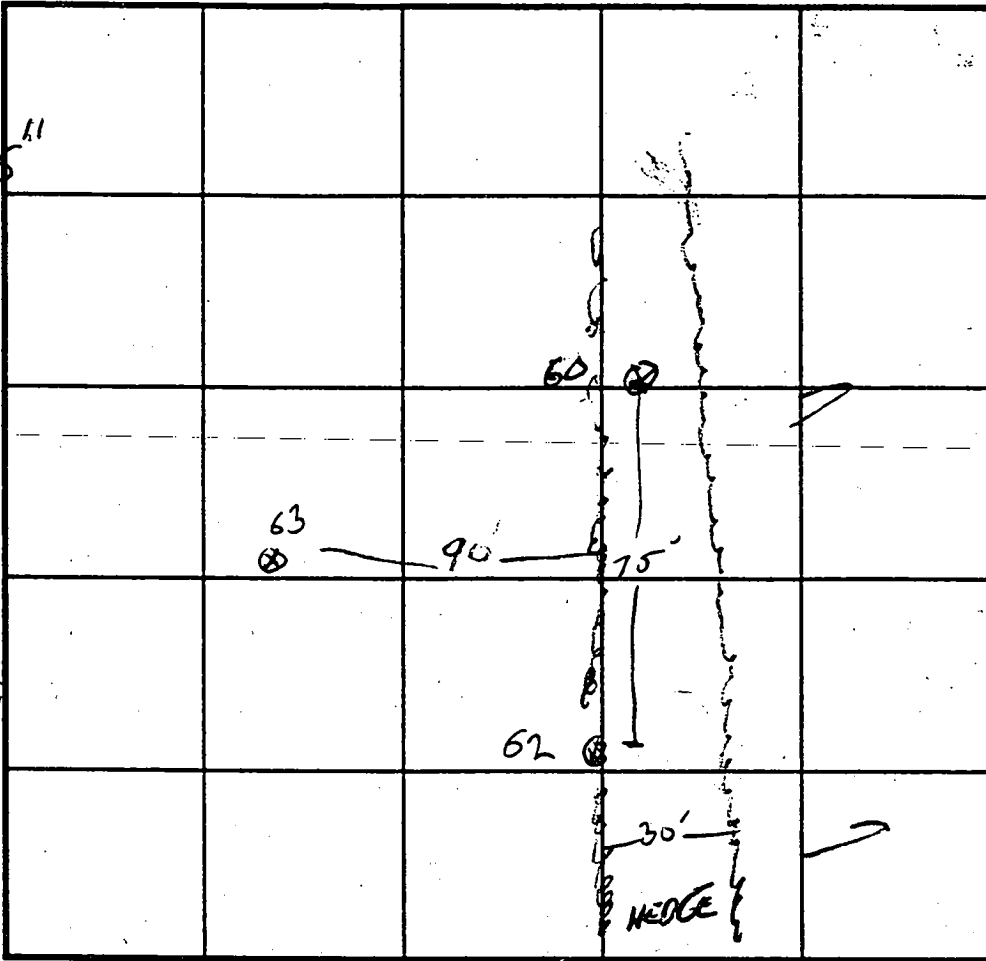

SOIL PROFILE

TOPSOIL

ORANGE SANDY CLAY LOAM

BROWN SILT SAND LOAM

0'

1'

5'

9'

INDICATE NORTH - NAME ADJOINING ROADWAY AS BASE LINE.

DATE	TEST NO.	DEPTH	PRE-WET		TEST - 1" DROP		TIME
			START	STOP	START	STOP	
4-11-96	62	46" / 9'	1:38	1:39	1:39	1:40	2min
	60	5' / 106"	1:48	1:50	1:50	1:53	3min

REMARKS LOT #13 (2 SHEETS) RE-CONVEGATION

TYPE OF SOIL

TESTED BY G. SAUVAGE ALSO PRESENT MIKE + MIKE

TRENCH DESIGN DATA: AVERAGE PERCOLATION TIME 3 TRENCH WIDTH 3

INLET DEPTH 3 MAXIMUM BOTTOM DEPTH 5 SQ. FT./BEDROOM 180