

APPLICATION

A 19178

SEWAGE DISPOSAL TESTING
MARYLAND STATE DEPARTMENT OF HEALTH
HOWARD COUNTY

P _____
ELLICOTT CITY
DISTRICT 4th
DATE 10/30/73

TO: THE COUNTY HEALTH OFFICER
ELLICOTT CITY, MARYLAND

I, HEREBY, APPLY FOR THE NECESSARY TESTS IN ORDER TO CONSTRUCT (OR RECONSTRUCT) A SEWAGE DISPOSAL SYSTEM.

PROPERTY OWNER Justice Tract, Joint Venture

ADDRESS 1131 University Blvd. W. #215, Silver Spring, Md. 20902 PHONE 301-649-1500

PROPERTY LOCATION:

SUBDIVISION Glenwood Estates LOT NO. 5 Sec I

ROAD AND DESCRIPTION S.E. Quadrant of intersection of Shady Lane and Burntwoods Rd.

OCCUPANT _____ PHONE _____

PERSON TO CONSTRUCT SYSTEM _____

ADDRESS _____ PHONE _____

SIZE OF LOT 1.0 acres 40,000 s.f. TYPE BLDG. 3-4 bedrooms
NUMBER OF ROOMS

IF NOT SINGLE RESIDENCE DESCRIBE _____

SIGNATURE OF APPLICANT Justice Tract, Joint Venture: By *Walter D. Cook* Partner


APPROVED BY _____ FOR _____ (KIND OF SYSTEM) _____ DATE _____

REJECTED BY _____ FOR _____ (KIND OF SYSTEM) _____ DATE _____

HOLD PENDING FURTHER TESTS _____ DATE _____

REASONS FOR REJECTION OR HOLDING _____

THIS IS NOT A PERMIT

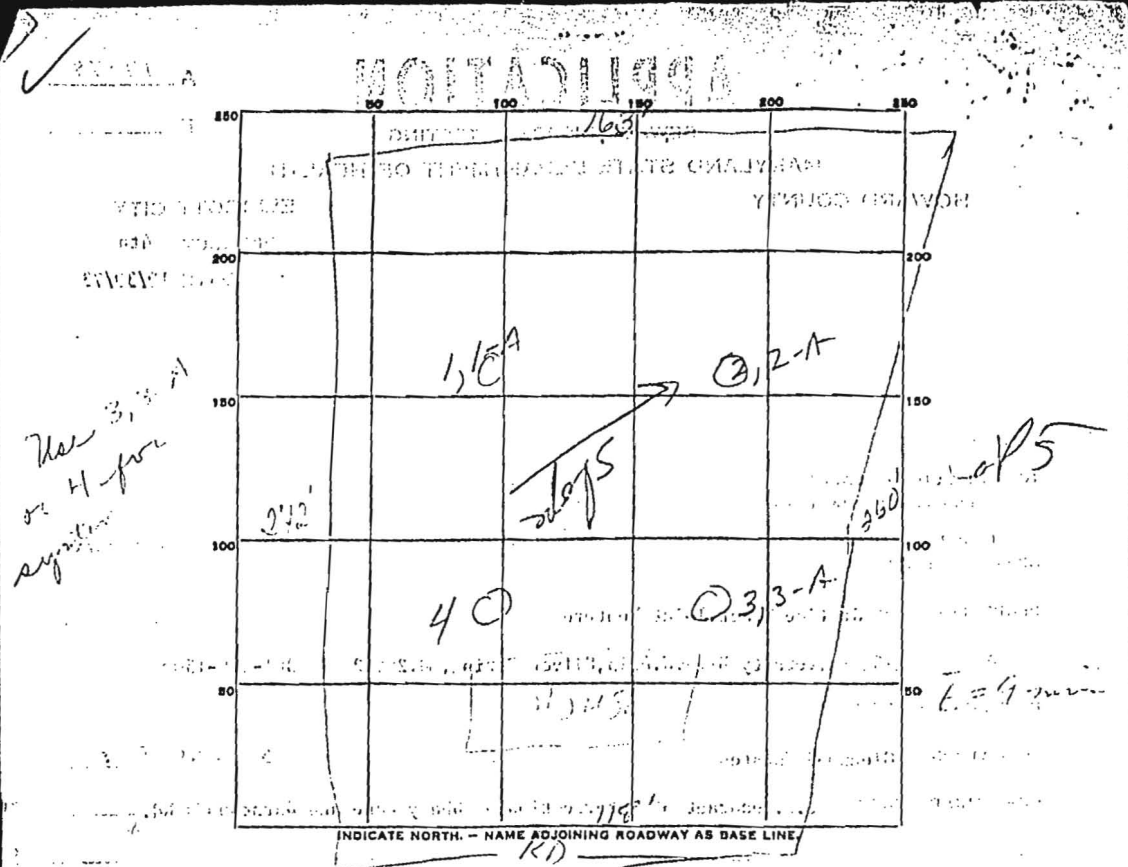

DATE	TEST NO.	DEPTH	PRE-WET		TEST - 1" DROP		TIME
			START	STOP	START	STOP	
4/31/74	1	6	3:56	4:00	4:00	4:10	10
	1-A	12	3:56	4:00	4:00	4:06	6
	2	5 1/2	4:08	4:15	4:15	4:25	10
	2-A	12 1/2	4:08	4:15	4:15	4:25	10
	3	5	4:19	4:22	4:22	4:28	6
	3-A	11 1/2	4:16	4:21	4:21	4:29	8
	4	12	Visual; same to 1, 1-A; dry				

SOIL AUGER FINDING _____

TESTED BY WWZ

REMARKS _____