

MARYLAND DEPARTMENT OF THE ENVIRONMENT, WATER MANAGEMENT ADMINISTRATION
1800 Washington Blvd., Baltimore, Maryland 21230 (410) 537-3784

WATER WELL ABANDONMENT-SEALING REPORT FORM

SUBMIT COPIES OF COMPLETED FORM TO:

- COUNTY ENVIRONMENT AGENCY (contact MDE, WMA if address needed)
- WELL OWNER
- MDE, WATER MANAGEMENT ADMINISTRATION, WELL PROGRAM

DATE WELL ABANDONED: 8/22/05 (month/day/year)

PERMIT NUMBER OF ABANDONED WELL (if any) NA

PERMIT NUMBER OF REPLACEMENT WELL NA

PERSON ABANDONING WELL: Good

WELL DRILLERS LICENSE NUMBER: 360-0-0-0-0-0
CIRCLE: MWD/MSD/MGD

OWNER'S NAME: _____


SITE LOCATION MAP

WELL LOCATION

COUNTY: Howard County
NEAREST TOWN: Ellicott City
TAX MAP _____ BLOCK _____ PARCEL _____
SUBDIVISION: _____
SECTION: _____ LOT: _____
NEAREST ROAD: College Ave

4309 College Ave

4309 College Ave

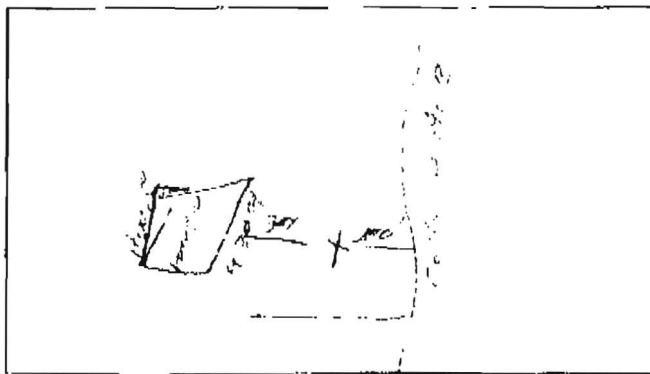

TYPE OF WELL BEING ABANDONED:

- DRILLED
- BORED/AUGERED
- OTHER (specify) _____
- JETTED
- HAND DUG

USE CODE:

- DOMESTIC
- IRRIGATION
- TEST/OBSERVATION
- MUNICIPAL/PUBLIC
- INDUSTRIAL
- GEOTHERMAL

TYPE OF CASING:

- STEEL
- CONCRETE
- PLASTIC
- OTHER (specify) _____

SIZE OF CASING: 6 INCHES IN DIAMETER

DEPTH OF WELL: 20 FEET DEEP

WAS ANY CASING REMOVED? YES NO
if yes, length removed, in feet: _____

WAS CASING RIPPED OR PERFORATED? YES NO

LOG OF SEALING MATERIAL

MATERIAL	FEET	
	FROM	TO
<u>Sand</u>	<u>10</u>	<u>20</u>
<u>Concrete</u>	<u>20</u>	<u>0'</u>

VOLUME OF MATERIAL USED

2 cu yd sand
1 cu yd concrete
(2 x 10) = 20 cu yd to 20 ft

SIGNATURE-MASTER WELL DRILLER OR SUPERVISING SANITARIAN _____

LICENSE # _____

MWD/MSD/MGD
CIRCLE ONE

DATE 8/22/05