



PROPOSED BIO-RETENTION FILTER

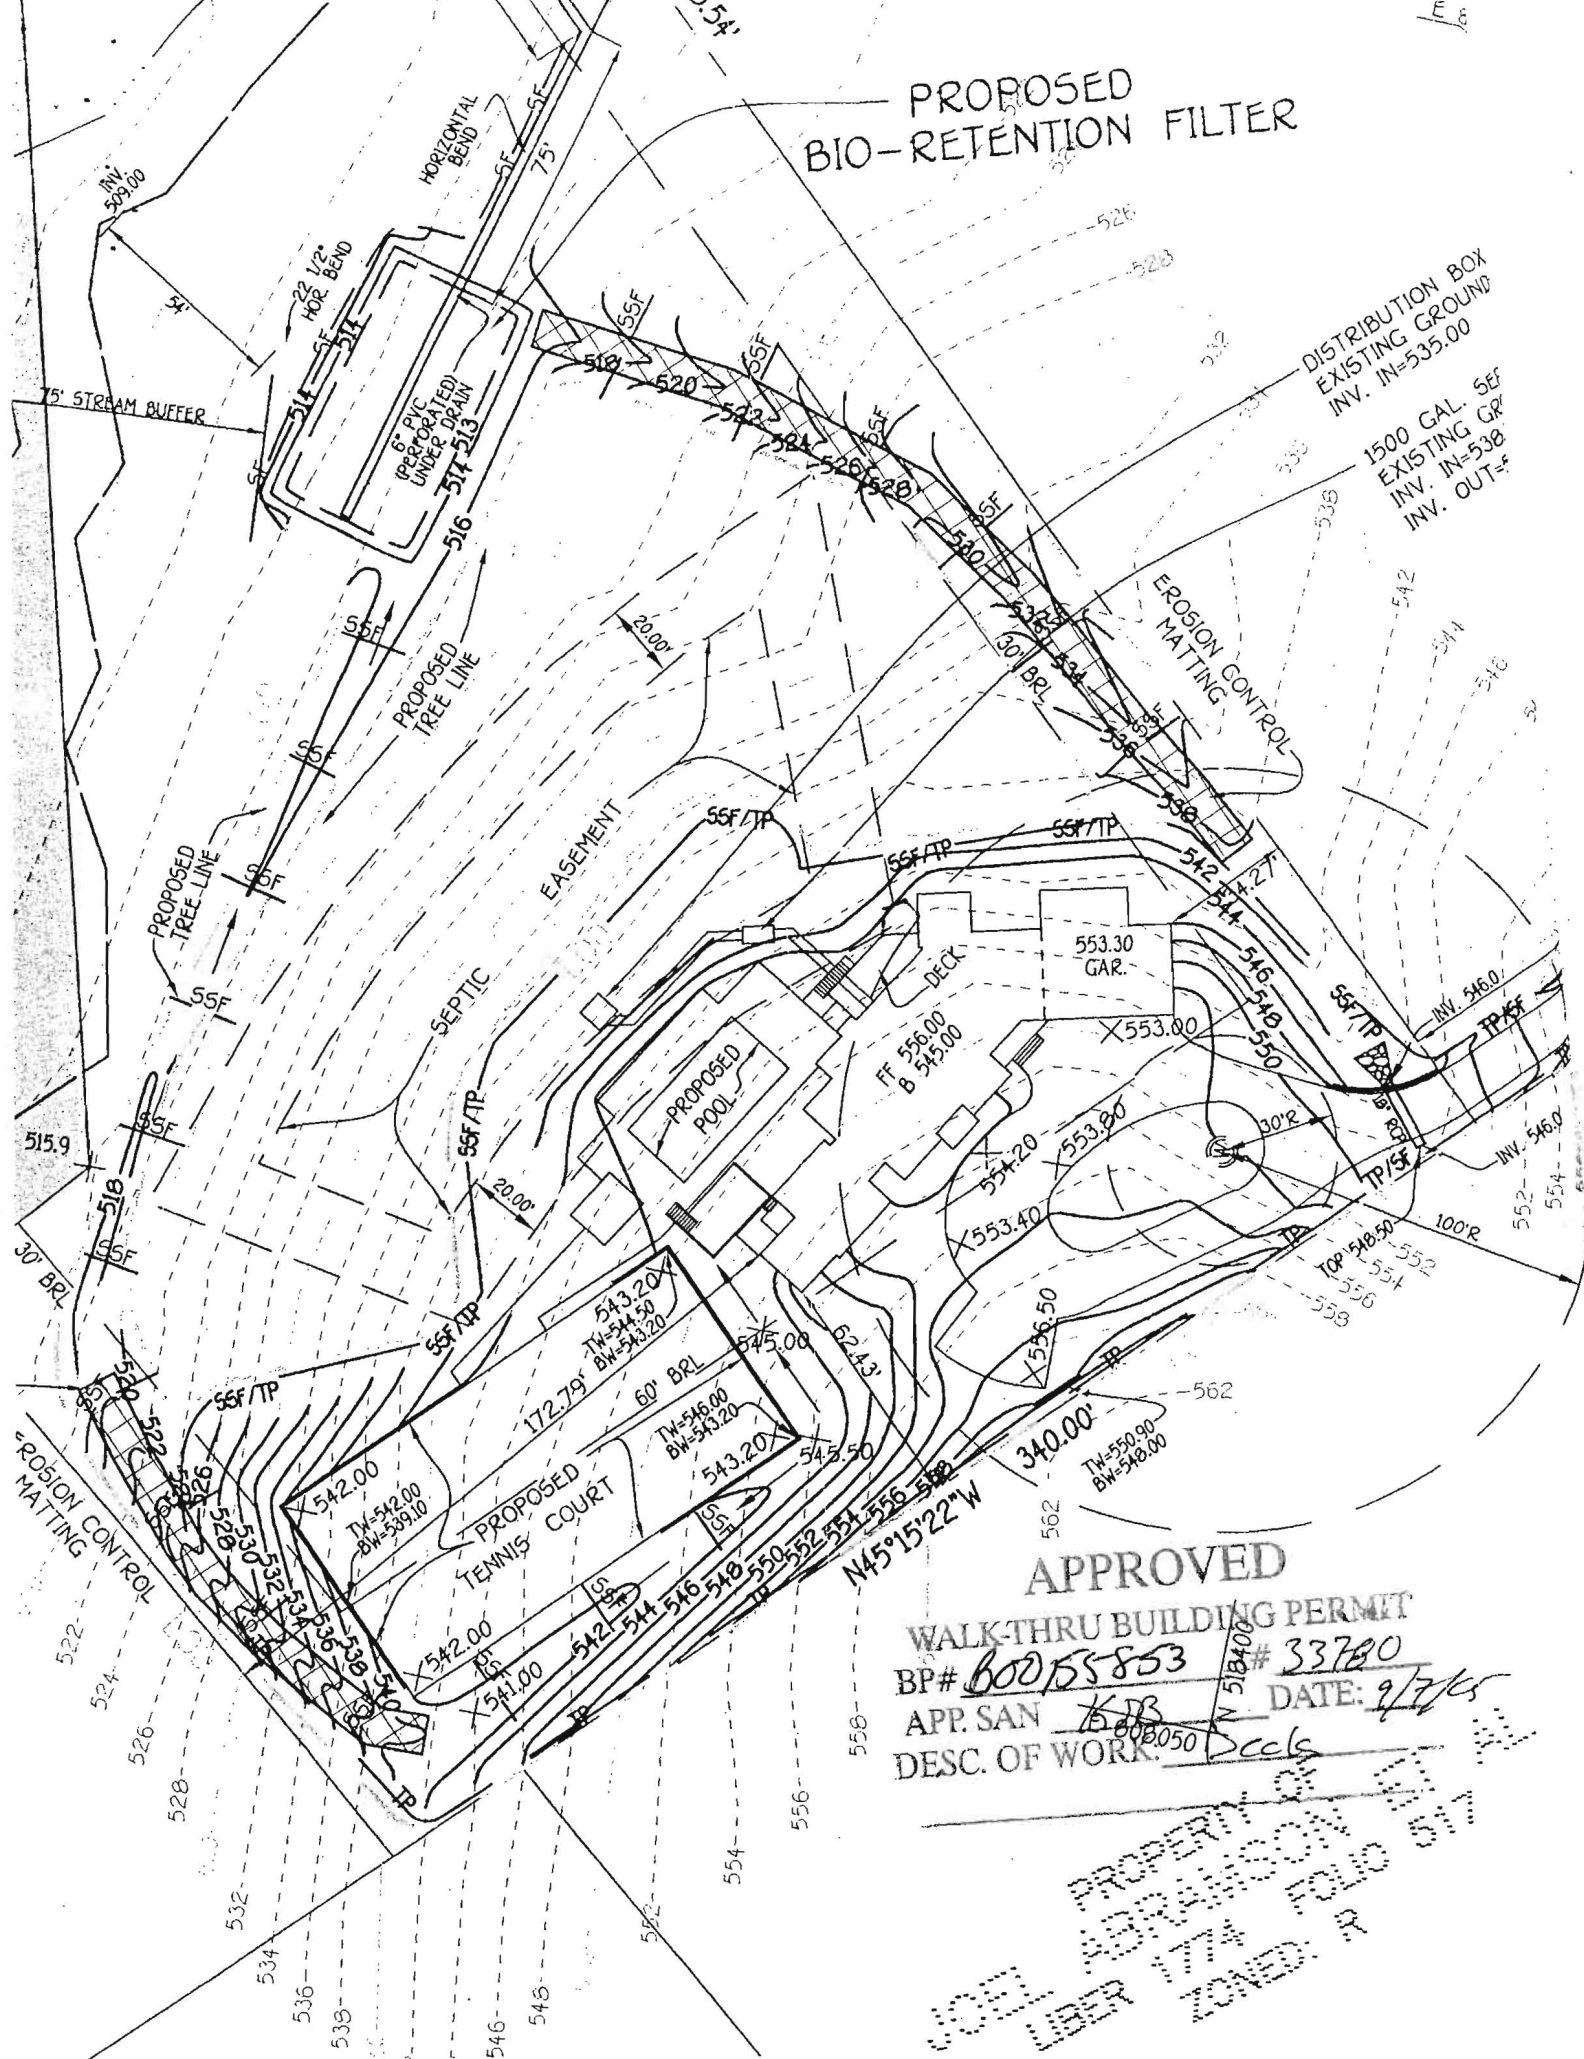

APPROVED
 WALK-THRU BUILDING PERMIT
 BP# 600155853
 APP. SAN *KJB* # 33780
 DATE: 9/7/05
 DESC. OF WORK: *Scels*

PROPERTY OF
 WALK-THRU BUILDING PERMIT
 10/18/05
 10/18/05

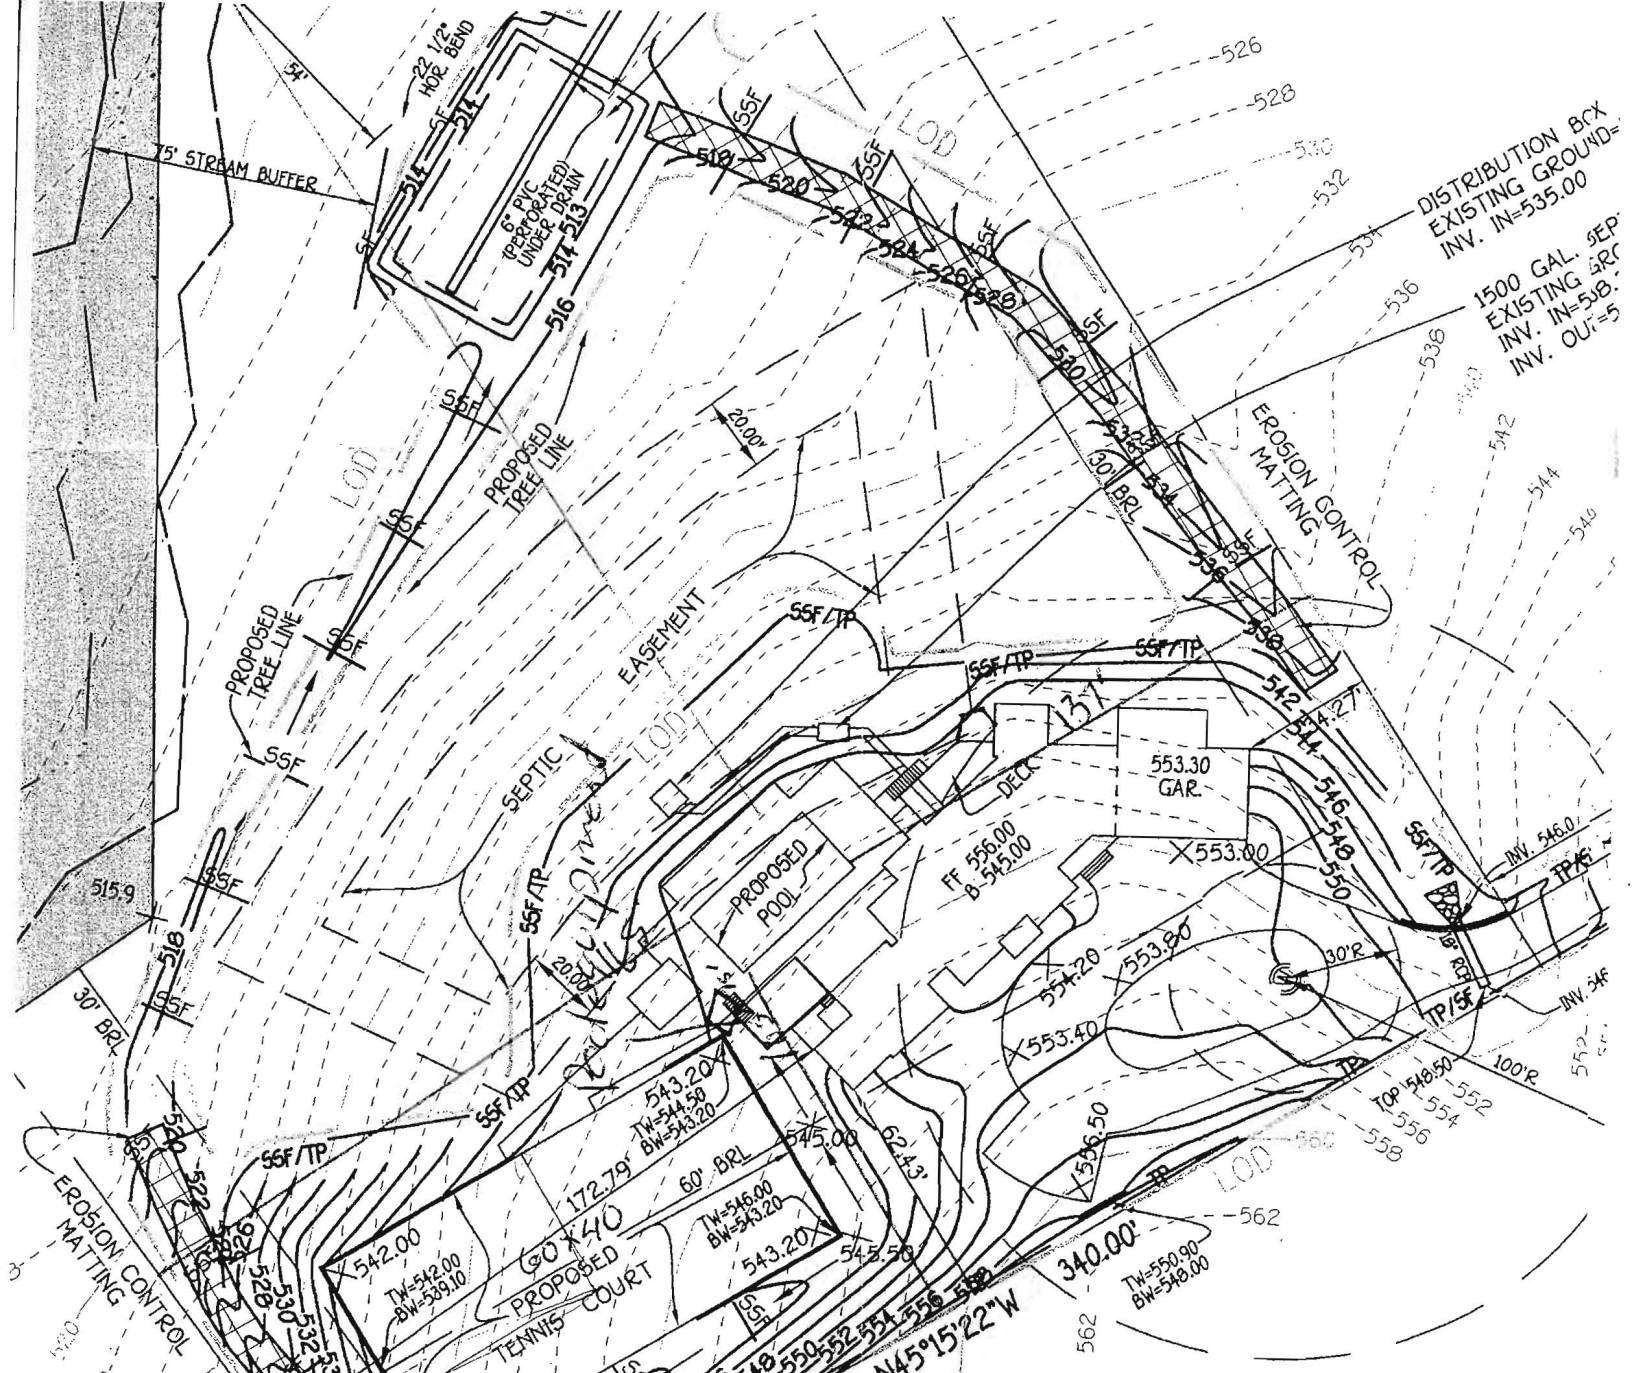

APPROVED
 WALK-THRU BUILDING PERMIT
 BP# B00158307 A# 5192
 APR SAN K55 D. 10050 5-1-06
 DES. OF WORK: 24-x42 01

PROPERLY ZONED
 LIBERATED
 517

GP-04-50

ENGINEER'S CERTIFICATE

that this plan for erosion and sediment control represents a practical and workable