

APPLICATION

A 21925

P _____

SEWAGE DISPOSAL TESTING

STATE OF MARYLAND - DEPARTMENT OF HEALTH AND MENTAL HYGIENE

HOWARD COUNTY HEALTH DEPARTMENT *Septic Tank*
ENVIRONMENTAL HEALTH SERVICES

DISTRICT 2nd

P. O. BOX 476, ELLICOTT CITY, MARYLAND 21043
TELEPHONE: 465-5000, EXT. 356

1000 gal

DATE 8/4/75

*Dry well in lot 4'-max depth 10', 300 sq FT
10' from rear of lot
absorbant area to be located 35' from right property line, 5' earth
buffer between dry well and trench, trench 20' long, to run 10' from
rear property line towards right property line, inlet at 4' max
depth 10' call office for inspection of trench before pouring stone in
trench*

TO: THE COUNTY HEALTH OFFICER
ELLICOTT CITY, MARYLAND

I, HEREBY, APPLY FOR THE NECESSARY TEST IN ORDER TO CONSTRUCT (OR RECONSTRUCT) A SEWAGE DISPOSAL SYSTEM.

PROPERTY OWNER William R. Spicer

ADDRESS 4489 Centennial Lane, Ellicott City, Maryland PHONE 465-6613

PROPERTY LOCATION:

SUBDIVISION _____ LOT NO. _____

ROAD AND DESCRIPTION 4489 Centennial Lane

SIZE OF LOT 3/4 acres TYPE BLDG. 3 bedrooms NUMBER OF BEDROOMS 2 to be removed
*These tests for house to be moved onto property
existing house*

IF NOT SINGLE RESIDENCE DESCRIBE _____

THE SYSTEM INSTALLED UNDER THIS APPLICATION IS ACCEPTABLE ONLY UNTIL PUBLIC FACILITIES BECOME AVAILABLE.

SIGNATURE OF APPLICANT William R. Spicer

APPROVED BY D. J. O'Neill FOR Dry well + trench DATE 8/11/75
(KIND OF SYSTEM)

REJECTED BY _____ FOR _____ DATE _____
(KIND OF SYSTEM)

HOLD PENDING FURTHER TESTS _____ DATE _____

REASONS FOR REJECTION OR HOLDING _____

THIS IS NOT A PERMIT

APPLICATION

A 21925

SEWAGE DISPOSAL TESTING

P _____

STATE OF MARYLAND - DEPARTMENT OF HEALTH AND MENTAL HYGIENE

HOWARD COUNTY HEALTH DEPARTMENT
ENVIRONMENTAL HEALTH SERVICES

DISTRICT 2nd

P. O. BOX 476, ELLICOTT CITY, MARYLAND 21043
TELEPHONE: 465-5000, EXT. 356

DATE 8/4/75

TO: THE COUNTY HEALTH OFFICER
ELLICOTT CITY, MARYLAND

I, HEREBY, APPLY FOR THE NECESSARY TEST IN ORDER TO CONSTRUCT (OR RECONSTRUCT) A SEWAGE DISPOSAL SYSTEM.

PROPERTY OWNER William R. Spicer

ADDRESS 4489 Centennial Lane, Ellicott City, Maryland PHONE 465-6613

PROPERTY LOCATION:

SUBDIVISION _____ LOT NO. _____

ROAD AND DESCRIPTION 4489 Centennial Lane

SIZE OF LOT 3/4 acres TYPE BLDG. 3 bedrooms
NUMBER OF BEDROOMS

IF NOT SINGLE RESIDENCE DESCRIBE _____

THE SYSTEM INSTALLED UNDER THIS APPLICATION IS ACCEPTABLE ONLY UNTIL PUBLIC FACILITIES BECOME AVAILABLE.

SIGNATURE OF APPLICANT William R. Spicer


APPROVED BY _____ FOR _____ DATE _____
(KIND OF SYSTEM)

REJECTED BY _____ FOR _____ DATE _____
(KIND OF SYSTEM)

HOLD PENDING FURTHER TESTS _____ DATE _____

REASONS FOR REJECTION OR HOLDING _____

THIS IS NOT A PERMIT

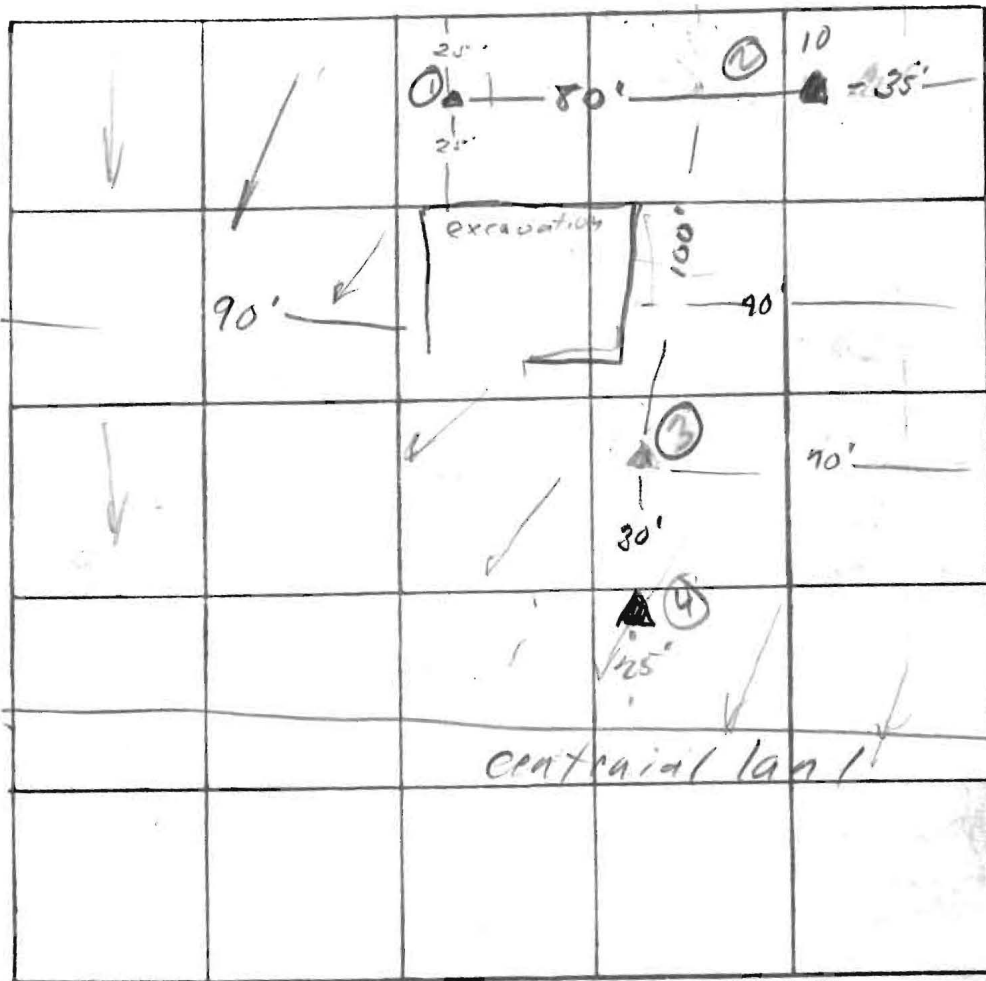

INDICATE NORTH. - NAME ADJOINING ROADWAY AS BASE LINE

DATE	TEST NO.	DEPTH	PRE-WET		TEST - 1" DROP		TIME
			START	STOP	START	STOP	
8/11/75	1s	4'	10 ²⁰	10 ²²	10 ²²	10 ²⁵	3
"	1d	13'	10 ²⁵	10 ³⁰	10 ³⁶	10 ³²	14
"	2s	4 1/2'	10 ⁴⁰	10 ⁴⁵	10 ⁴¹	10 ⁵¹	6
"	2d	13'	10 ⁵¹	11 ⁰⁰	10 ⁵⁸	11 ¹⁵	17
"	3s	5'	11 ⁰⁰	11 ⁰³	11 ⁰³	11 ¹⁰	7
"	3d	Water	12'				(4)
"	4	10'	Water				9

10 min
Aug

REMARKS _____

TYPE OF SOIL Sandy loam

TESTED BY O'Neill ALSO PRESENT: Mr & Mrs Spicer

