

APPLICATION

SEWAGE DISPOSAL TESTING

STATE OF MARYLAND · DEPARTMENT OF HEALTH AND MENTAL HYGIENE

HOWARD COUNTY HEALTH DEPARTMENT
ENVIRONMENTAL HEALTH SERVICES

P. O. BOX 476 ELLICOTT CITY, MARYLAND 21043
TELEPHONE: 992-2330

A 35422

P _____

DISTRICT 5th

DATE April 3, 1985

TO: THE COUNTY HEALTH OFFICER
ELLICOTT CITY, MARYLAND

I HEREBY APPLY FOR THE NECESSARY TEST IN ORDER TO CONSTRUCT (OR RECONSTRUCT) A SEWAGE DISPOSAL SYSTEM

PROPERTY OWNER Grace A. E. Eisenhardt c/o Tracy, Schulte & Associates, Inc.

ADDRESS 8450 Baltimore National Pike, Suite 34 PHONE 465-6105

PROPERTY LOCATION:

SUBDIVISION Lime Kiln, Section 2 LOT NO 27

ROAD AND DESCRIPTION Southwest of Green Dell Lane: West of Brown's Bridge Road

SIZE OF LOT 3.310 Ac TYPE BLDG N/A
(NUMBER OF BEDROOMS)

THE SYSTEM INSTALLED UNDER THIS APPLICATION IS ACCEPTABLE ONLY UNTIL PUBLIC FACILITIES BECOME AVAILABLE. I FULLY UNDERSTAND THE FEE CONNECTED WITH THE FILING OF THIS PERC TEST APPLICATION IS NON-REFUNDABLE UNDER ANY CIRCUMSTANCES. I ALSO AGREE TO COMPLY WITH ALL M.O.S.H.A. REQUIREMENTS IN TESTING THIS LOT.

(SIGNATURE OF APPLICANT)

APPROVED BY _____ FOR _____ DATE _____

REJECTED BY _____ FOR _____ DATE _____

HOLD PENDING FURTHER TESTS _____ DATE _____

REASONS FOR REJECTION OR HOLDING _____

THIS IS NOT A PERMIT

APPLICATION

SEWAGE DISPOSAL TESTING

STATE OF MARYLAND - DEPARTMENT OF HEALTH AND MENTAL HYGIENE

HOWARD COUNTY HEALTH DEPARTMENT
ENVIRONMENTAL HEALTH SERVICES

P. O. BOX 476 ELLICOTT CITY, MARYLAND 21043
TELEPHONE: 992-2330

A 35420³

P _____

DISTRICT 5th

DATE April 3, 1985

TO: THE COUNTY HEALTH OFFICER
ELLICOTT CITY, MARYLAND

I, HEREBY, APPLY FOR THE NECESSARY TEST IN ORDER TO CONSTRUCT (OR RECONSTRUCT) A SEWAGE DISPOSAL SYSTEM

PROPERTY OWNER Grace A. E. Eisenhardt c/o Tracy, Schulte & Associates, Inc.

ADDRESS 8450 Baltimore National Pike, Suite 34 PHONE 465-6105

PROPERTY LOCATION:

SUBDIVISION Lime Kiln, Section 2 LOT NO. 27 26

ROAD AND DESCRIPTION Southwest of Green Dell Lane: West of Brown's Bridge Road

SIZE OF LOT 3.310 Ac TYPE BLDG N/A
(NUMBER OF BEDROOMS)

THE SYSTEM INSTALLED UNDER THIS APPLICATION IS ACCEPTABLE ONLY UNTIL PUBLIC FACILITIES BECOME AVAILABLE. I FULLY UNDERSTAND THE FEE CONNECTED WITH THE FILING OF THIS PERC TEST APPLICATION IS NON-REFUNDABLE UNDER ANY CIRCUMSTANCES. I ALSO AGREE TO COMPLY WITH ALL M.O.S.H.A. REQUIREMENTS IN TESTING THIS LOT.

(SIGNATURE OF APPLICANT)

APPROVED BY _____ FOR _____ DATE _____

REJECTED BY _____ FOR _____ DATE _____

HOLD PENDING FURTHER TESTS _____ DATE _____

REASONS FOR REJECTION OR HOLDING 5/24/85 Perc OK Hold for Plat R.H

THIS IS NOT A PERMIT

APPLICATION

SOIL PROFILE

| | | | | |
|--|--|--|--|--|
| | | | | |
| | | | | |
INDICATE NORTH - NAME ADJOINING ROADWAY AS BASE LINE.

| DATE | TEST NO. | DEPTH | PRE-WET | | TEST - 1" DROP | | TIME |
|------|----------|-------|---------|------|----------------|------|------|
| | | | START | STOP | START | STOP | |
| | | | | | | | |
| | | | | | | | |
REMARKS _____

TYPE OF SOIL _____

TESTED BY _____ ALSO PRESENT _____

EH-12-1079

THIS IS NOT A PERMIT

APPLICATION

SEWAGE DISPOSAL TESTING

STATE OF MARYLAND · DEPARTMENT OF HEALTH AND MENTAL HYGIENE

HOWARD COUNTY HEALTH DEPARTMENT
ENVIRONMENTAL HEALTH SERVICES
P. O. BOX 478 ELLICOTT CITY, MARYLAND 21043
TELEPHONE: 992-2330

A 35424
P _____

DISTRICT 5th

DATE April 3, 1985

TO: THE COUNTY HEALTH OFFICER
ELLICOTT CITY, MARYLAND

I HEREBY APPLY FOR THE NECESSARY TEST IN ORDER TO CONSTRUCT (OR RECONSTRUCT) A SEWAGE DISPOSAL SYSTEM

PROPERTY OWNER Grace A. E. Eisenhardt c/o Tracy, Schulte & Associates, Inc.
ADDRESS 8450 Baltimore National Pike, Suite 34 PHONE 465-6105

PROPERTY LOCATION:

SUBDIVISION Lime Kiln, Section 2 LOT NO. 26²⁵ - NOW P/O LOT 33

ROAD AND DESCRIPTION Southwest of Green Dell Lane: West of Brown's Bridge Road

SIZE OF LOT 3.110 Ac TYPE BLDG. N/A
(NUMBER OF BEDROOMS)

THE SYSTEM INSTALLED UNDER THIS APPLICATION IS ACCEPTABLE ONLY UNTIL PUBLIC FACILITIES BECOME AVAILABLE. I FULLY UNDERSTAND THE FEE CONNECTED WITH THE FILING OF THIS PERC TEST APPLICATION IS NON-REFUNDABLE UNDER ANY CIRCUMSTANCES. I ALSO AGREE TO COMPLY WITH ALL M.O.S.H.A. REQUIREMENTS IN TESTING THIS LOT.

(SIGNATURE OF APPLICANT)

APPROVED BY _____ FOR _____ DATE _____

REJECTED BY _____ FOR _____ DATE _____

HOLD PENDING FURTHER TESTS _____ DATE _____

REASONS FOR REJECTION OR HOLDING 5/24/85 Perc OK Hold for Plat RH

THIS IS NOT A PERMIT

APPLICATOR

SOIL PROFILE

0 []

| | | | | |
|--|--|--|--|--|
| | | | | |
| | | | | |
INDICATE NORTH - NAME ADJOINING ROADWAY AS BASE LINE.

| DATE | TEST NO. | DEPTH | PRE-WET | | TEST - 1" DROP | | TIME |
|------|----------|-------|---------|------|----------------|------|------|
| | | | START | STOP | START | STOP | |
| | | | | | | | |
| | | | | | | | |
REMARKS _____

TYPE OF SOIL _____

TESTED BY _____ ALSO PRESENT _____

EH-12-1079

THIS IS NOT A RETURN

APPLICATION

SEWAGE DISPOSAL TESTING

STATE OF MARYLAND · DEPARTMENT OF HEALTH AND MENTAL HYGIENE

HOWARD COUNTY HEALTH DEPARTMENT
ENVIRONMENTAL HEALTH SERVICES
P. O. BOX 476 ELLICOTT CITY, MARYLAND 21043
TELEPHONE: 992-2330

A 35424
P _____
DISTRICT 5th
DATE April 3, 1985

TO: THE COUNTY HEALTH OFFICER
ELLICOTT CITY, MARYLAND

I HEREBY APPLY FOR THE NECESSARY TEST IN ORDER TO CONSTRUCT (OR RECONSTRUCT) A SEWAGE DISPOSAL SYSTEM

PROPERTY OWNER Grace A. E. Eisenhardt c/o Tracy, Schulte & Associates, Inc.
ADDRESS 8450 Baltimore National Pike, Suite 34 PHONE 465-6105

PROPERTY LOCATION:

SUBDIVISION Lime Kiln, Section 2 LOT NO 26

ROAD AND DESCRIPTION Southwest of Green Dell Lane; West of Brown's Bridge Road

SIZE OF LOT 3.110 Ac TYPE BLDG N/A
(NUMBER OF BEDROOMS)

THE SYSTEM INSTALLED UNDER THIS APPLICATION IS ACCEPTABLE ONLY UNTIL PUBLIC FACILITIES BECOME AVAILABLE. I FULLY UNDERSTAND THE FEE CONNECTED WITH THE FILING OF THIS PERC TEST APPLICATION IS NON-REFUNDABLE UNDER ANY CIRCUMSTANCES. I ALSO AGREE TO COMPLY WITH ALL M.O.S.H.A. REQUIREMENTS IN TESTING THIS LOT.

(SIGNATURE OF APPLICANT)

APPROVED BY _____ FOR _____ DATE _____

REJECTED BY _____ FOR _____ DATE _____

HOLD PENDING FURTHER TESTS _____ DATE _____

REASONS FOR REJECTION OR HOLDING _____


THIS IS NOT A PERMIT

APPLICATION

HOLE ELEVATION

- ① HIGHEST
- ② = HIGH
- ③ LOWEST
- ④ NEXT LOWER

X TIME 5 MIN
INLET 3 FE
BOTTOM 4.5 FE

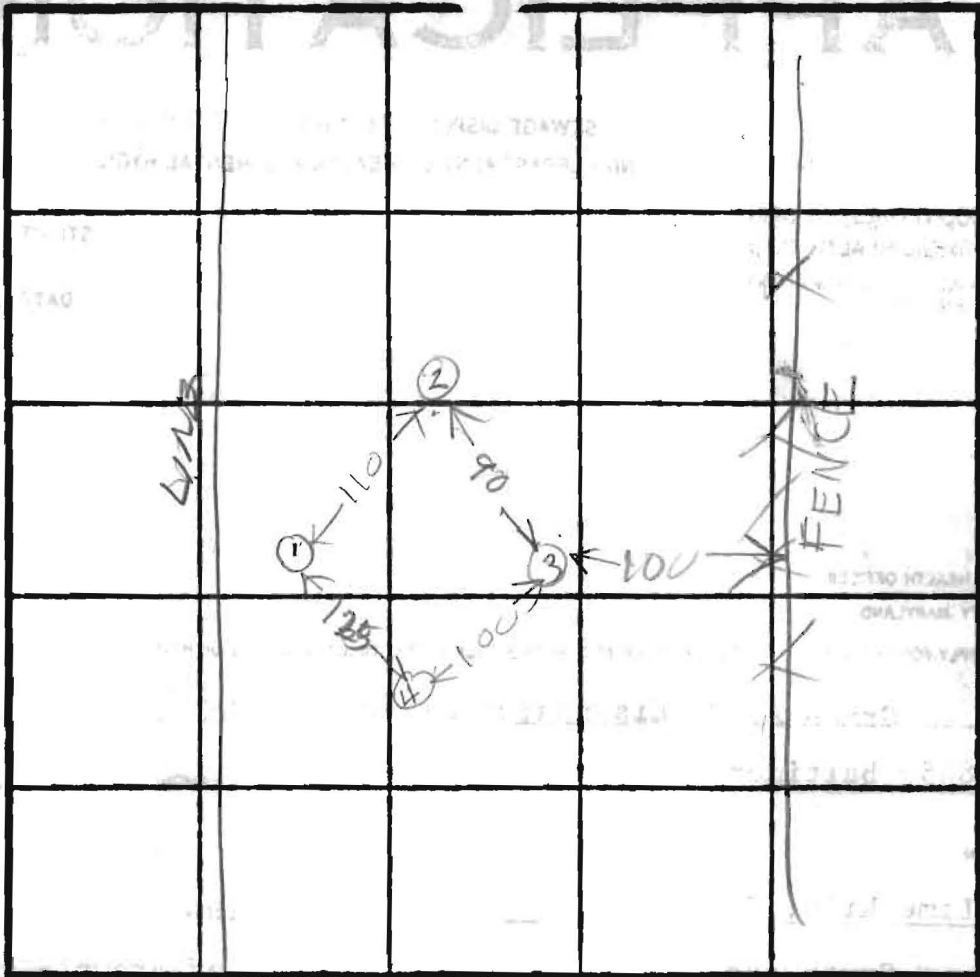

INDICATE NORTH - NAME ADJOINING ROADWAY AS BASE LINE

SOIL PROFILE
TOPSOIL CLAY
BROWN SAND LOAM
HARD

RED BROWN CLAY
BROWN SAND LOAM
HARD

RED BROWN CLAY
BROWN SAND LOAM
HARD

CLAY TOPSOIL
SAND & PROFILE
HARD

| DATE | TEST NO | DEPTH | PRE-WET | | TEST - 1" DROP | | TIME |
|---------|---------|--------|----------|------|----------------|------|------|
| | | | START | STOP | START | STOP | |
| 5/24/05 | 1S | 3 1/2 | 1137 | 1141 | 1141 | 1147 | 6 |
| | 1V | 9 | LOOKS OK | | OK | | |
| | 2S | 3 | 1141 | 1144 | 1144 | 1146 | 2 |
| | 2V | 10 | LOOKS OK | | BUT SHALLOW | | |
| | 3S | 4 | 1153 | 1204 | 1204 | 1208 | 10 |
| | 3V | 10 1/2 | LOOKS OK | | BUT SHALLOW | | |
| | 4S | 4 | 1158 | 1200 | 1200 | 1202 | 2 |
| | 4V | 8 | LOOKS OK | | BUT SHALLOW | | |
| | | | | | | | |
| | | | | | | | |
REMARKS HOLES DUG PER SURVEYOR STAKES

TYPE OF SOIL _____

TESTED BY B. HODGES

ALSO PRESENT KHATEFIELD Book

53