

Official Role
& Return
8/14/75
9:30 A

58453.8

APPLICATION

A 21941

SEWAGE DISPOSAL TESTING

P _____

STATE OF MARYLAND - DEPARTMENT OF HEALTH AND MENTAL HYGIENE

HOWARD COUNTY HEALTH DEPARTMENT
ENVIRONMENTAL HEALTH SERVICES
P. O. BOX 478, ELLICOTT CITY, MARYLAND 21043
TELEPHONE: 465-5000, EXT. 358

DISTRICT 3rd
DATE 8/11/75

Dry well to be located 225' From Front of lot 75' 100' From Right side line.
Inlet at 5' max depth 10', 200' sq' absorbant sidewall area, 5' earth buffer
between dry well and trench. Trench to run approximately parallel with
right property line towards rear of lot. Trench Inlet at 5' Max depth
10' 3 bedroom 35' long, 4 bedroom 60' long. Call office for inspection
of trench before pouring stone in trench.

TO: THE COUNTY HEALTH OFFICER
ELLICOTT CITY, MARYLAND

I, HEREBY, APPLY FOR THE NECESSARY TEST IN ORDER TO CONSTRUCT (OR RECONSTRUCT) A SEWAGE DISPOSAL SYSTEM.

PROPERTY OWNER Manfred J. Reinhard and Wife
Any questions call Mrs. Levy:
ADDRESS _____ PHONE 531-5084

PROPERTY LOCATION:
SUBDIVISION Woodmark LOT NO. 62 63, Blk. C, Sec. 7
ROAD AND DESCRIPTION Mt. Albert Road

SIZE OF LOT 94,300 sq. ft. TYPE BLDG. 3 or 4 bedrooms
NUMBER OF BEDROOMS _____

IF NOT SINGLE RESIDENCE DESCRIBE _____

THE SYSTEM INSTALLED UNDER THIS APPLICATION IS ACCEPTABLE ONLY UNTIL PUBLIC FACILITIES BECOME AVAILABLE.

SIGNATURE OF APPLICANT /s/ Helen M. Levy
BLDG. PERMIT SIGNED AND RETURNED 8/26/75

APPROVED BY DJO'Will FOR Dry well & Trench DATE 8/14/75
(KIND OF SYSTEM)

REJECTED BY _____ FOR _____ DATE _____
(KIND OF SYSTEM)

HOLD PENDING FURTHER TESTS _____ DATE _____

REASONS FOR REJECTION OR HOLDING _____

THIS IS NOT A PERMIT

*Official hole
& Retent*

58757.8

APPLICATION

A 21941
P _____

8/14/75
9:30 A.M.

SEWAGE DISPOSAL TESTING

STATE OF MARYLAND - DEPARTMENT OF HEALTH AND MENTAL HYGIENE

HOWARD COUNTY HEALTH DEPARTMENT *Septic Tank*
ENVIRONMENTAL HEALTH SERVICES *3 bdr. 1000 gal*
P. O. BOX 476, ELLICOTT CITY, MARYLAND 21043 *4 bdr. 1250 gal*
TELEPHONE: 485-5000, EXT. 356

DISTRICT 3rd
DATE 8/11/75

Dry well to be located 225' from front of lot 75' 100' from right side line. Inlet at 5' max depth 10', 200' sq' absorbant sidewalk cover, 5' earth buffer between dry well and trench. Trench to run approximately parallel with right property line towards rear of lot. Trench inlet at 5' max depth 10' 3 bedroom 35' long, 4 bedroom 60' long. Call office for inspection of trench before pouring stone in trench.

TO: THE COUNTY HEALTH OFFICER
ELLICOTT CITY, MARYLAND

I, HEREBY, APPLY FOR THE NECESSARY TEST IN ORDER TO CONSTRUCT (OR RECONSTRUCT) A SEWAGE DISPOSAL SYSTEM.

PROPERTY OWNER Manfred J. Reinhard and Wife
Any questions call Mrs. Levy:
ADDRESS _____ PHONE 531-5084

PROPERTY LOCATION:

SUBDIVISION Woodmark LOT NO. 62 63, Blk. C, Sec. 7
ROAD AND DESCRIPTION Mt. Albert Road

SIZE OF LOT 94,300 sq. ft. TYPE BLDG. 3 or 4 bedrooms
NUMBER OF BEDROOMS _____

IF NOT SINGLE RESIDENCE DESCRIBE _____

THE SYSTEM INSTALLED UNDER THIS APPLICATION IS ACCEPTABLE ONLY UNTIL PUBLIC FACILITIES BECOME AVAILABLE.

BLDG. PERMIT SIGNED
AND RETURNED 8/26/75

SIGNATURE OF APPLICANT /s/ Helen M. Levy


APPROVED BY D.P.O. Wall FOR Dry well + Trench DATE 8/14/75
(KIND OF SYSTEM)

REJECTED BY _____ FOR _____ DATE _____
(KIND OF SYSTEM)

HOLD PENDING FURTHER TESTS _____ DATE _____

REASONS FOR REJECTION OR HOLDING _____

THIS IS NOT A PERMIT

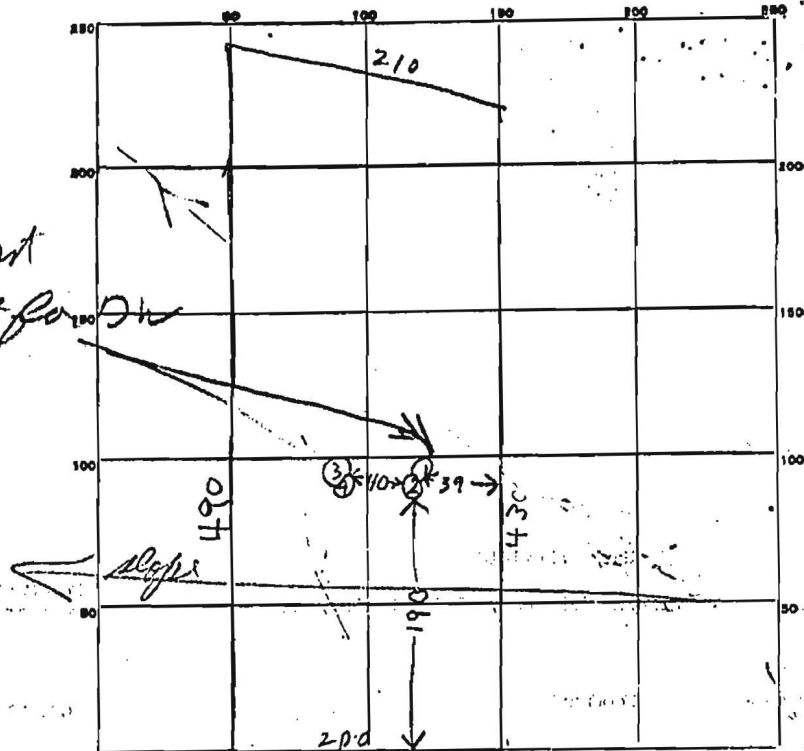

INDICATE NORTH - NAME ADJOINING ROADWAY AS BASE LINE.

MT ALBERT RD

DATE	TEST NO.	DEPTH	PRE-WET		TEST - 1" DROP		TIME
			START	STOP	START	STOP	
4/14/71	1	9 1/2	1038	1040	1040	1043	3
	2	3	1038	1040	1040	1044	4
	3	11 1/2	1038	1039	1039	1040	1
	4	4	1038	1039	1039	1042	2

SOIL AUGER FINDING _____
 TESTED BY Harwood Hodges
 REMARKS Lot 63

