

11/4/04 - 1-2 PM

ISSUE DATE: 10/28/04

P 521558

APPROVAL DATE: _____

A REPAIR

PERMIT INDEXED

ON-SITE SEWAGE DISPOSAL SYSTEM HOWARD COUNTY HEALTH DEPARTMENT BUREAU OF ENVIRONMENTAL HEALTH

Hatfield's Equipment _____ IS PERMITTED TO INSTALL ALTER

ADDRESS: 13785 Burntwoods Rd. PHONE NUMBER: 410-531- _____

SUBDIVISION: _____ LOT NUMBER: _____

ADDRESS: 13275 Highland Road PROPERTY OWNER: Jack Kogok

SEPTIC TANK CAPACITY (GALLONS): Ex 1250

PUMP CHAMBER CAPACITY (GALLONS): _____

NUMBER OF BEDROOMS: 4 5

SQUARE FEET PER BEDROOM: 210 210

LINEAR FEET OF TRENCH REQUIRED: 185 231

TRENCHES:	Trench to be 2 feet wide. Inlet 12 feet below original grade. Bottom maximum depth 12 feet below original grade. Effective area begins at 9 feet below original grade. 4 feet of stone below distribution pipe.
LOCATION:	D. B. between S.T. & D.W. Speed leveler up on P.W.
PURPOSE:	Existing septic system has failed. Call for inspection when ground is opened so sanitarian can recommend repair.


PLANS APPROVED: [Signature] DATE: 11/1/04

- NOTE: PERMIT VOID AFTER 2 YEARS
- NOTE: CONTRACTOR RESPONSIBLE FOR SCHEDULING A PRE-CONSTRUCTION INSPECTION FOR ALL INSTALLATIONS
- NOTE: WATERTIGHT SEPTIC TANKS REQUIRED
- NOTE: ALL PARTS OF SEPTIC SYSTEM SHALL BE 100 FEET FROM ANY WATER WELL
- NOTE: MANHOLE RISERS REQUIRED ON ALL SEPTIC TANKS AND PUMP CHAMBERS

NEITHER THE HOWARD COUNTY COUNCIL OR THE HEALTH DEPARTMENT IS RESPONSIBLE FOR THE SUCCESSFUL OPERATION OF ANY SYSTEM PERMITTEE RESPONSIBLE FOR OBTAINING FINAL APPROVAL ON THIS PERMIT CALL 410-313-2640 FOR INSPECTION OF SEPTIC SYSTEM

P5 21558

NOT TO SCALE

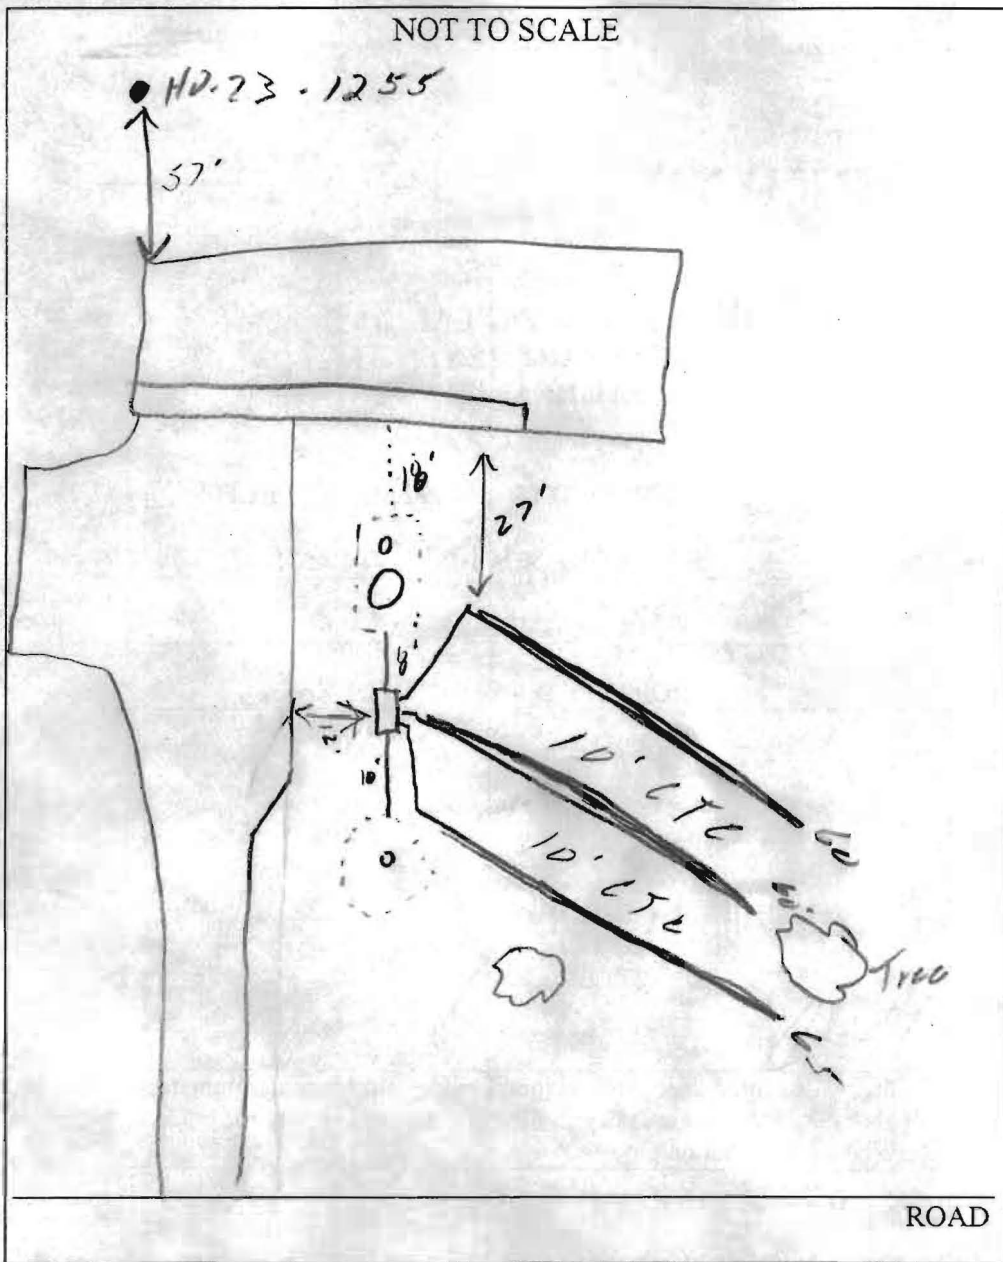

TRENCH/DRAINFIELD DATA		
WIDTH	INLET	BOTTOM
2'	8'	12'
NUMBER OF TRENCHES		3
TOTAL LENGTH		185'
ABSORPTION AREA		555 sq ft
DISTRIBUTION BOX LEVEL		✓
DISTRIBUTION BOX BAFFLE		✓
DISTRIBUTION BOX PORT		✓

SEPTIC TANK DATA	
SEPTIC TANK 1 LEVEL	
CAPACITY	Ex 1250 GAL
SEAM LOC	Mid
TANK LID DEPTH	∞
BAFFLES	✓
BAFFLE FILTER	
MANHOLE LOC	Back
6" PORT LOC	Front
WATERTIGHT TEST	
SEPTIC TANK 2 LEVEL	
CAPACITY	GAL
SEAM LOC	
TANK LID DEPTH	
BAFFLES	N/A
BAFFLE FILTER	N/A
MANHOLE LOC	
6" PORT LOC	
WATERTIGHT TEST	

PRE-CONSTRUCTION 11/3/04 - See prev sheet

INSTALLATION 11/4/04 - D.B. & 1 trench installed. Const. Left because of heavy rain (SO)

11/5/04 - Complete repair installed per specs OK TO cover (SO)

FINAL INSPECTOR [Signature] DATE OF APPROVAL 11/5/04