

4/33/76 approved J.S.
afternoon permit

PERMIT

SEWAGE DISPOSAL SYSTEM

P 22506
A 21116

MARYLAND STATE DEPARTMENT OF HEALTH

HOWARD COUNTY

ELLICOTT CITY

INDEXED

DISTRICT 5th

DATE 11/17/75

Howard Edwards IS PERMITTED TO INSTALL ALTER

ADDRESS 6645 Mink Hollow Road, Highland, Md. 20777 PHONE 596-6309

A SEWAGE DISPOSAL SYSTEM LOCATED AT

SUBDIVISION ROAD 13275 Highland Road LOT 1-C

PROPERTY OWNER Howard Edwards

ADDRESS same as above

SPECIFICATIONS 3 bedrooms

DRAIN FIELD DEPTH FEET, BOTTOM AREA SQ. FT.

SEEPAGE PITS ABSORBENT SIDE-WALL AREA SQ. FT.

SEPTIC TANK CAPACITY 1000 GALLONS

FOR GARBAGE GRINDER, INCREASE DISPOSAL AREA 22% & TANK CAPACITY 50%.

OTHER DRY WELL - To have 170 sq. ft. effective absorbent sidewall area per bedroom below first 5 ft. of original soil. Inlet to come in at 4 ft. and maximum depth permitted for dry well is 12 ft. Locate (per owner's measurements) 110 ft. from center of Highland Road and 25 ft. off left property line when facing lot from road. A trench with 5 ft. earth buffer can come off dry well and go to right side of lot.

NOTE: ALL PIPE FROM HOUSE TO DISPOSAL AREA MUST BE CAST IRON.

PERMIT VOID AFTER THREE YEARS.

NOTE: INSTALL STAND PIPE ON SEPTIC TANK AND DRY WELL. STAND PIPES MUST BE 6 INCHES IN DIAMETER. CAST IRON OR CONCRETE OR TERRAZZO ACCEPTED.


PLANS APPROVED BY Charles E. Streaker DATE 10/24/75

FILL SEPTIC TANK AND DISTRIBUTION BOX WITH WATER BEFORE CALLING FOR AN INSPECTION. COVER NO WORK UNTIL INSPECTED AND APPROVED.

NEITHER THE HOWARD COUNTY COMMISSIONERS NOR THE HEALTH DEPARTMENT IS RESPONSIBLE FOR THE SUCCESSFUL OPERATION OF ANY SYSTEM.

A 21116

21116

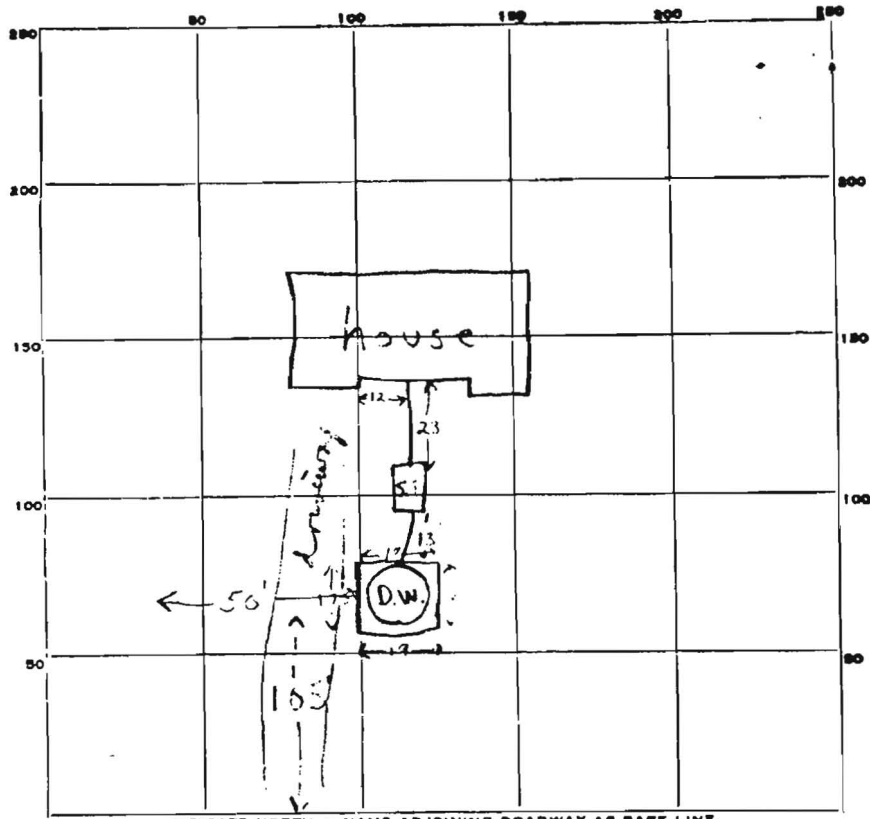

INDICATE NORTH. NAME ADJOINING ROADWAY AS BASE LINE.
Highland Rd.

PERMIT CARD Serial approved rec.

SEPTIC TANK, LEVEL ✓ 1250 gal septic tank CLEANOUTS ✓ S.T. | D.W. ✓

DISTRIBUTION BOX, LEVEL _____

TILE FIELD, DEPTH _____ FT. TRENCH WIDTH _____ FT.

GRAVEL DEPTH _____ IN. TOTAL LENGTH _____ FT.

NUMBER OF TRENCHES _____ TOTAL BOTTOM AREA _____

SEEPAGE PITS, ^{OUTSIDE PERIMETER} INSIDE DIAMETER 73.5 FT. DEPTH BELOW INLET 8 FT.

ABSORBENT AREA 588 SQ. FT.

REMARKS Had to dig well 20' off correct location but repair it that
was still possible. 4/24/76 spoke to C.B.S. plans approved for the well
in hole near house O.K. F.S.

DATE SYSTEM APPROVED 4/24/76 INSPECTOR F. Sh...