

11/26/75  
Inspection  
ready to  
start  
Rest of  
partial  
Need to see house -> ST conn  
tell final ok  
11/27/75

# PERMIT

P 22522  
A 21789

SEWAGE DISPOSAL SYSTEM

MARYLAND STATE DEPARTMENT OF HEALTH

HOWARD COUNTY

ELLICOTT CITY  
DISTRICT 5

## INDEXED

DATE 11/18/75

Olan Ketterman IS PERMITTED TO INSTALL  ALTER

ADDRESS 6119 Jerrys Drive, Columbia, Md. PHONE 997-6740

A SEWAGE DISPOSAL SYSTEM LOCATED AT \_\_\_\_\_

SUBDIVISION \_\_\_\_\_ ROAD 13989 R/W off Route 108 LOT A

PROPERTY OWNER Robert A. Dickson just before Montgomery County line on left going toward Ashton

ADDRESS \_\_\_\_\_

SPECIFICATIONS - 4 bedrooms

DRAIN FIELD \_\_\_\_\_ DEPTH \_\_\_\_\_ FEET, BOTTOM AREA \_\_\_\_\_ SQ. FT.

SEEPAGE PITS \_\_\_\_\_ ABSORBENT SIDE-WALL AREA \_\_\_\_\_ SQ. FT.

SEPTIC TANK CAPACITY 1,250 GALLONS

FOR GARBAGE GRINDER, INCREASE DISPOSAL AREA 22% & TANK CAPACITY 50%.

OTHER Dry well to have 150 sq. ft. effective sidewall absorption area per bedroom to begin below the first 4 ft. of non-porous soil. Max. depth permitted for dry well is 11 ft. below original grade. Place the dry well 110 ft. from the front lot line and 110 ft. from the right side line as seen when facing the property from the right-of-way. OK for trench

trench 82 ft. long - 13 ft. deep - 9 ft. of stone under pipe. CALL FOR INSPECTION OF TRENCH BEFORE GRAVEL IS INSTALLED. DWM 11/17/75

PLANS APPROVED BY Skinnex/Monaghan DATE 8/13/75 - 11/17/75


NOTE: ALL PIPE FROM HOUSE TO DISPOSAL AREA MUST BE CAST IRON.

FILL SEPTIC TANK AND DISTRIBUTION BOX WITH WATER BEFORE CALLING FOR AN INSPECTION. COVER NO WORK UNTIL INSPECTED AND APPROVED.  
PERMIT VOID AFTER THREE YEARS.

NEITHER THE HOWARD COUNTY COMMISSIONERS NOR THE HEALTH DEPARTMENT IS RESPONSIBLE FOR THE SUCCESSFUL OPERATION OF ANY SYSTEM.

INSTALL STAND PIPE ON SEPTIC TANK AND DRY WELL. CLEARS CUTS MUST BE 6" IN DIA., CONCRETE, CAST IRON OR TERRA COTTA ACCEPTED.

21789

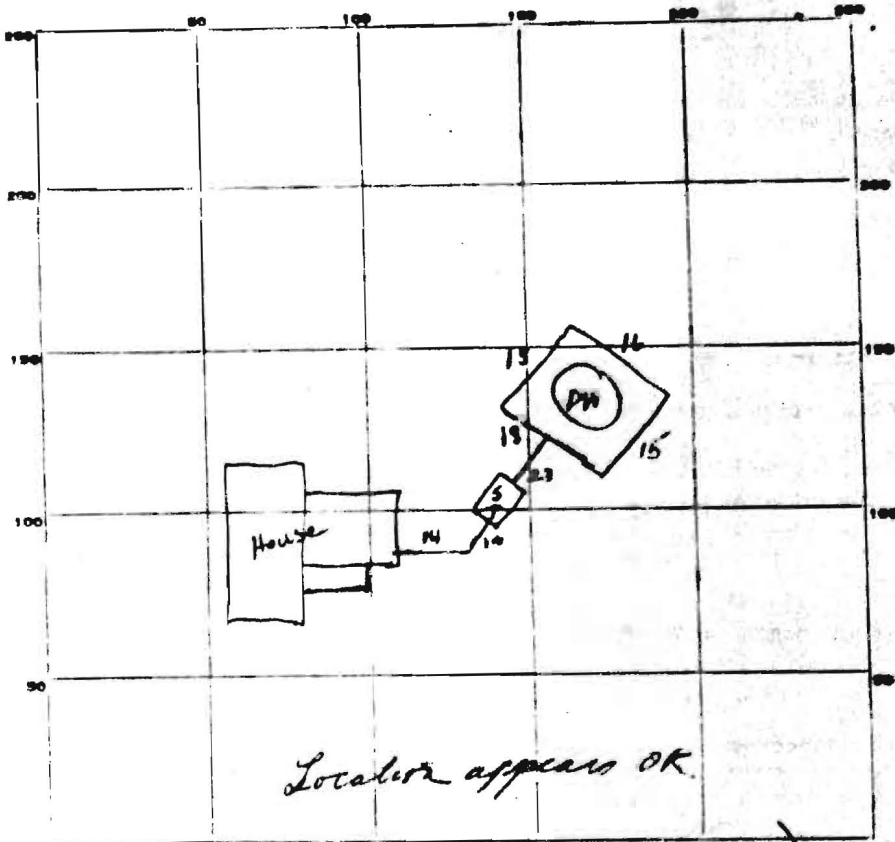

lots A

Location appears OK.

INDICATE NORTH - NAME ADJOINING ROADWAY AS BASE LINE

36  
 31  
 67  
 9  
 603

PERMIT CARD

SEPTIC TANK LEVEL 1.250 gal

ST	DW
<input checked="" type="checkbox"/>	<input checked="" type="checkbox"/>

DISTRIBUTION BOX LEVEL \_\_\_\_\_

TILE FIELD DEPTH \_\_\_\_\_ FT. TRENCH WIDTH \_\_\_\_\_ FT.

GRAVEL DEPTH \_\_\_\_\_ IN. TOTAL LENGTH \_\_\_\_\_ FT.

NUMBER OF TRENCHES \_\_\_\_\_ TOTAL BOTTOM AREA \_\_\_\_\_

SEEPAGE PITS INSIDE DIAMETER 15x18x16 FT. DEPTH BELOW INLET 4 FT.

ABSORBENT AREA 603 SQ. FT.

REMARKS 11/24/75 Hold for house → ST conn. WWB

11/28/75 Pipe extended into foundation wall

plumbing except messy final conn. WWB

DATE SYSTEM APPROVED 3/2/76

INSPECTOR William H. Zapp